Format A1 (841x594 mm) is 20 mm outside of this frame

A / – ÁSÝND Á VEGG STEYPUSKÁLA
(Horft úr annexbyggingu)

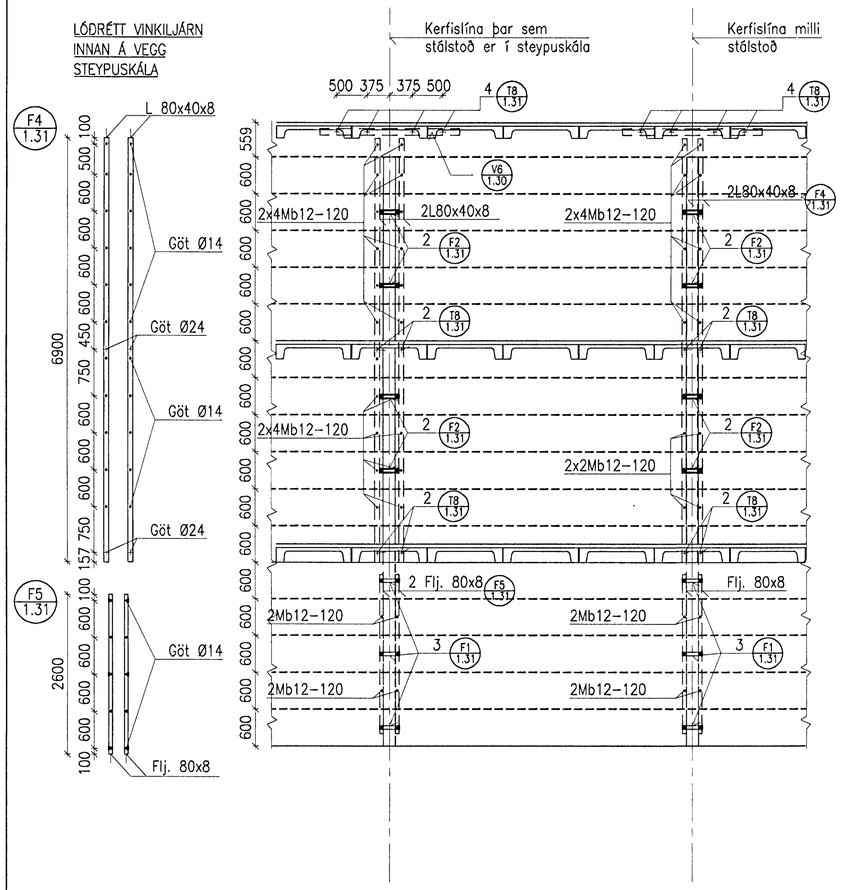

E / 103 KENNISNIÐ MÁLSETNING

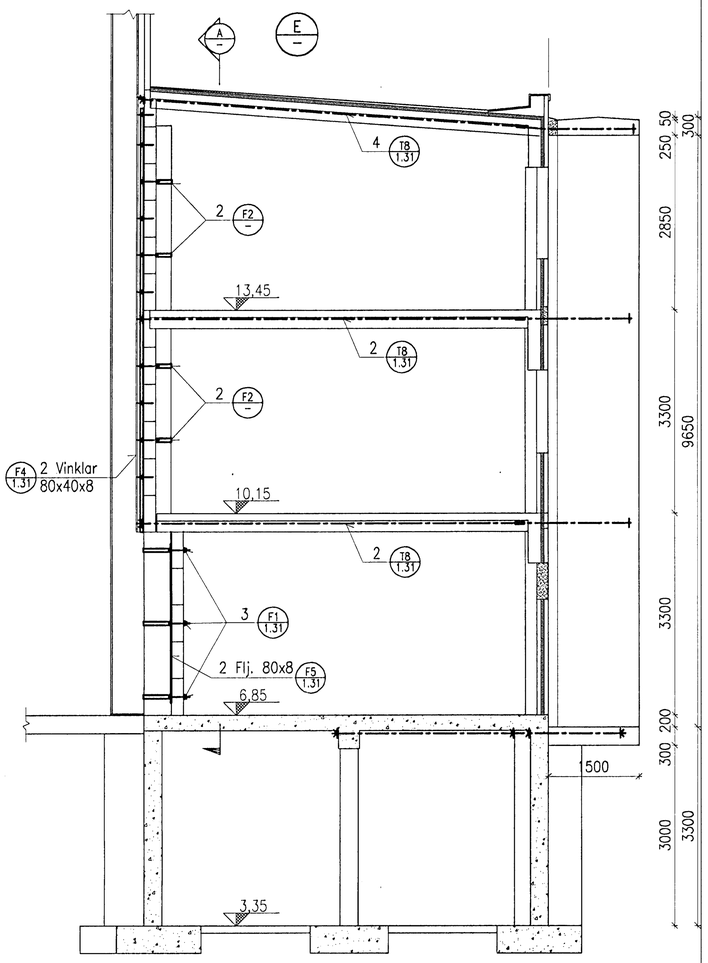

F / 103

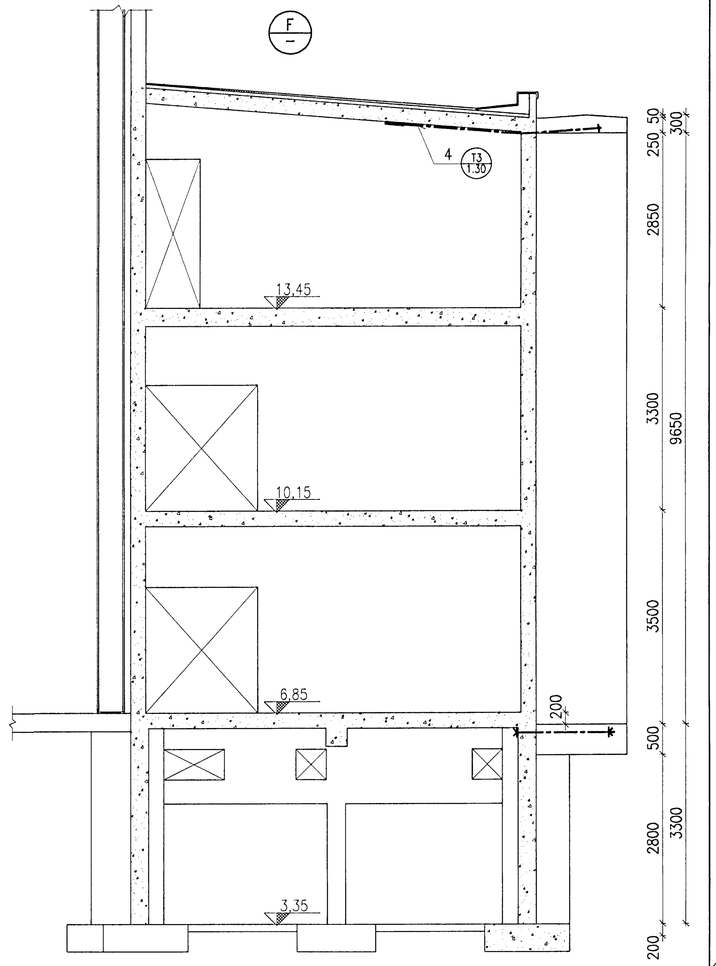

Samþykkt þann
02 OKT. 2003
Byggingafulltrúinn í Hafnarfirði
F.h. Sigurbjartur Halldórsson

1:50 1000 0 1000 2000 3000 4000 5000 mm

Skýringar:
Explanations:

J:\[99-1xx]\99110\Jardsk\Annex\ANN-28128-29.DWG

VST Verkfræðistofa Sigurðar Thoroddsen hf. Ármúla 4, 108 Reykjavík Sími 568 3000 Fax 568 3010

Breyt. Rev.	Breyting Revision	Dags. Date	Samb. Approved	Nafn. heimil Released
B	REYNDARTEIKNING	16.09.2003	SE	SvS
A	MERKINGAR OFL.	31.05.2002	SE	SVS

Tilv.teikningar nr. ISAL / Ref.drawing no. of ISAL
Samsetn.teikningar nr. ISAL / Assembly drawing no. of ISAL

This drawing is the property of the Alcan Iceland Ltd. and handed out for personal use only. It may neither be copied nor made available to others without permission of the Alcan Iceland Ltd. The receiver is liable for any misuse.

Fjöldi stykkja Number of pieces: IV III II I

Hlutur Object	Steypuskáli. Mhl. 12
	Annex, styrking, stækkun
	Þversnið, málteikning
Verktaki / Supplier	VST
Teiknað Drawn	SE/SAA 28.05.2001
Yfirfarið Checked	NI 28.05.2001
Samþykkt Approved	Sigurður Sæmundsson
Teiknað Drawn	Yfirfarið og skoðað Checked and rec'd 03.09.2001 GUR
Nafnkun heimilað Released	03.09.2001 SvS

Atriði Item | Efni Material | eg.:stk Weight | totalt held (kg) byggd | Athugasemdir Remarks

Stærð Format A1 | Mkv. Scale 1:50

Kostn.nr.-hönn.nr. / CDno.-Eq.no.: 6010 1227

AKS no.

Teikn.nr. verks / Dr.no. of supp. | Breyt./Rev.: 99.110-28.128

ALCAN PRIMARY METAL EUROPE
ISAL
Alcan Iceland Ltd
Straumsvík
IS-222 Hafnarfjörður

Stk.no. of ISAL / Teikn.nr. ISAL: 166778 | Breyt./Rev.: B