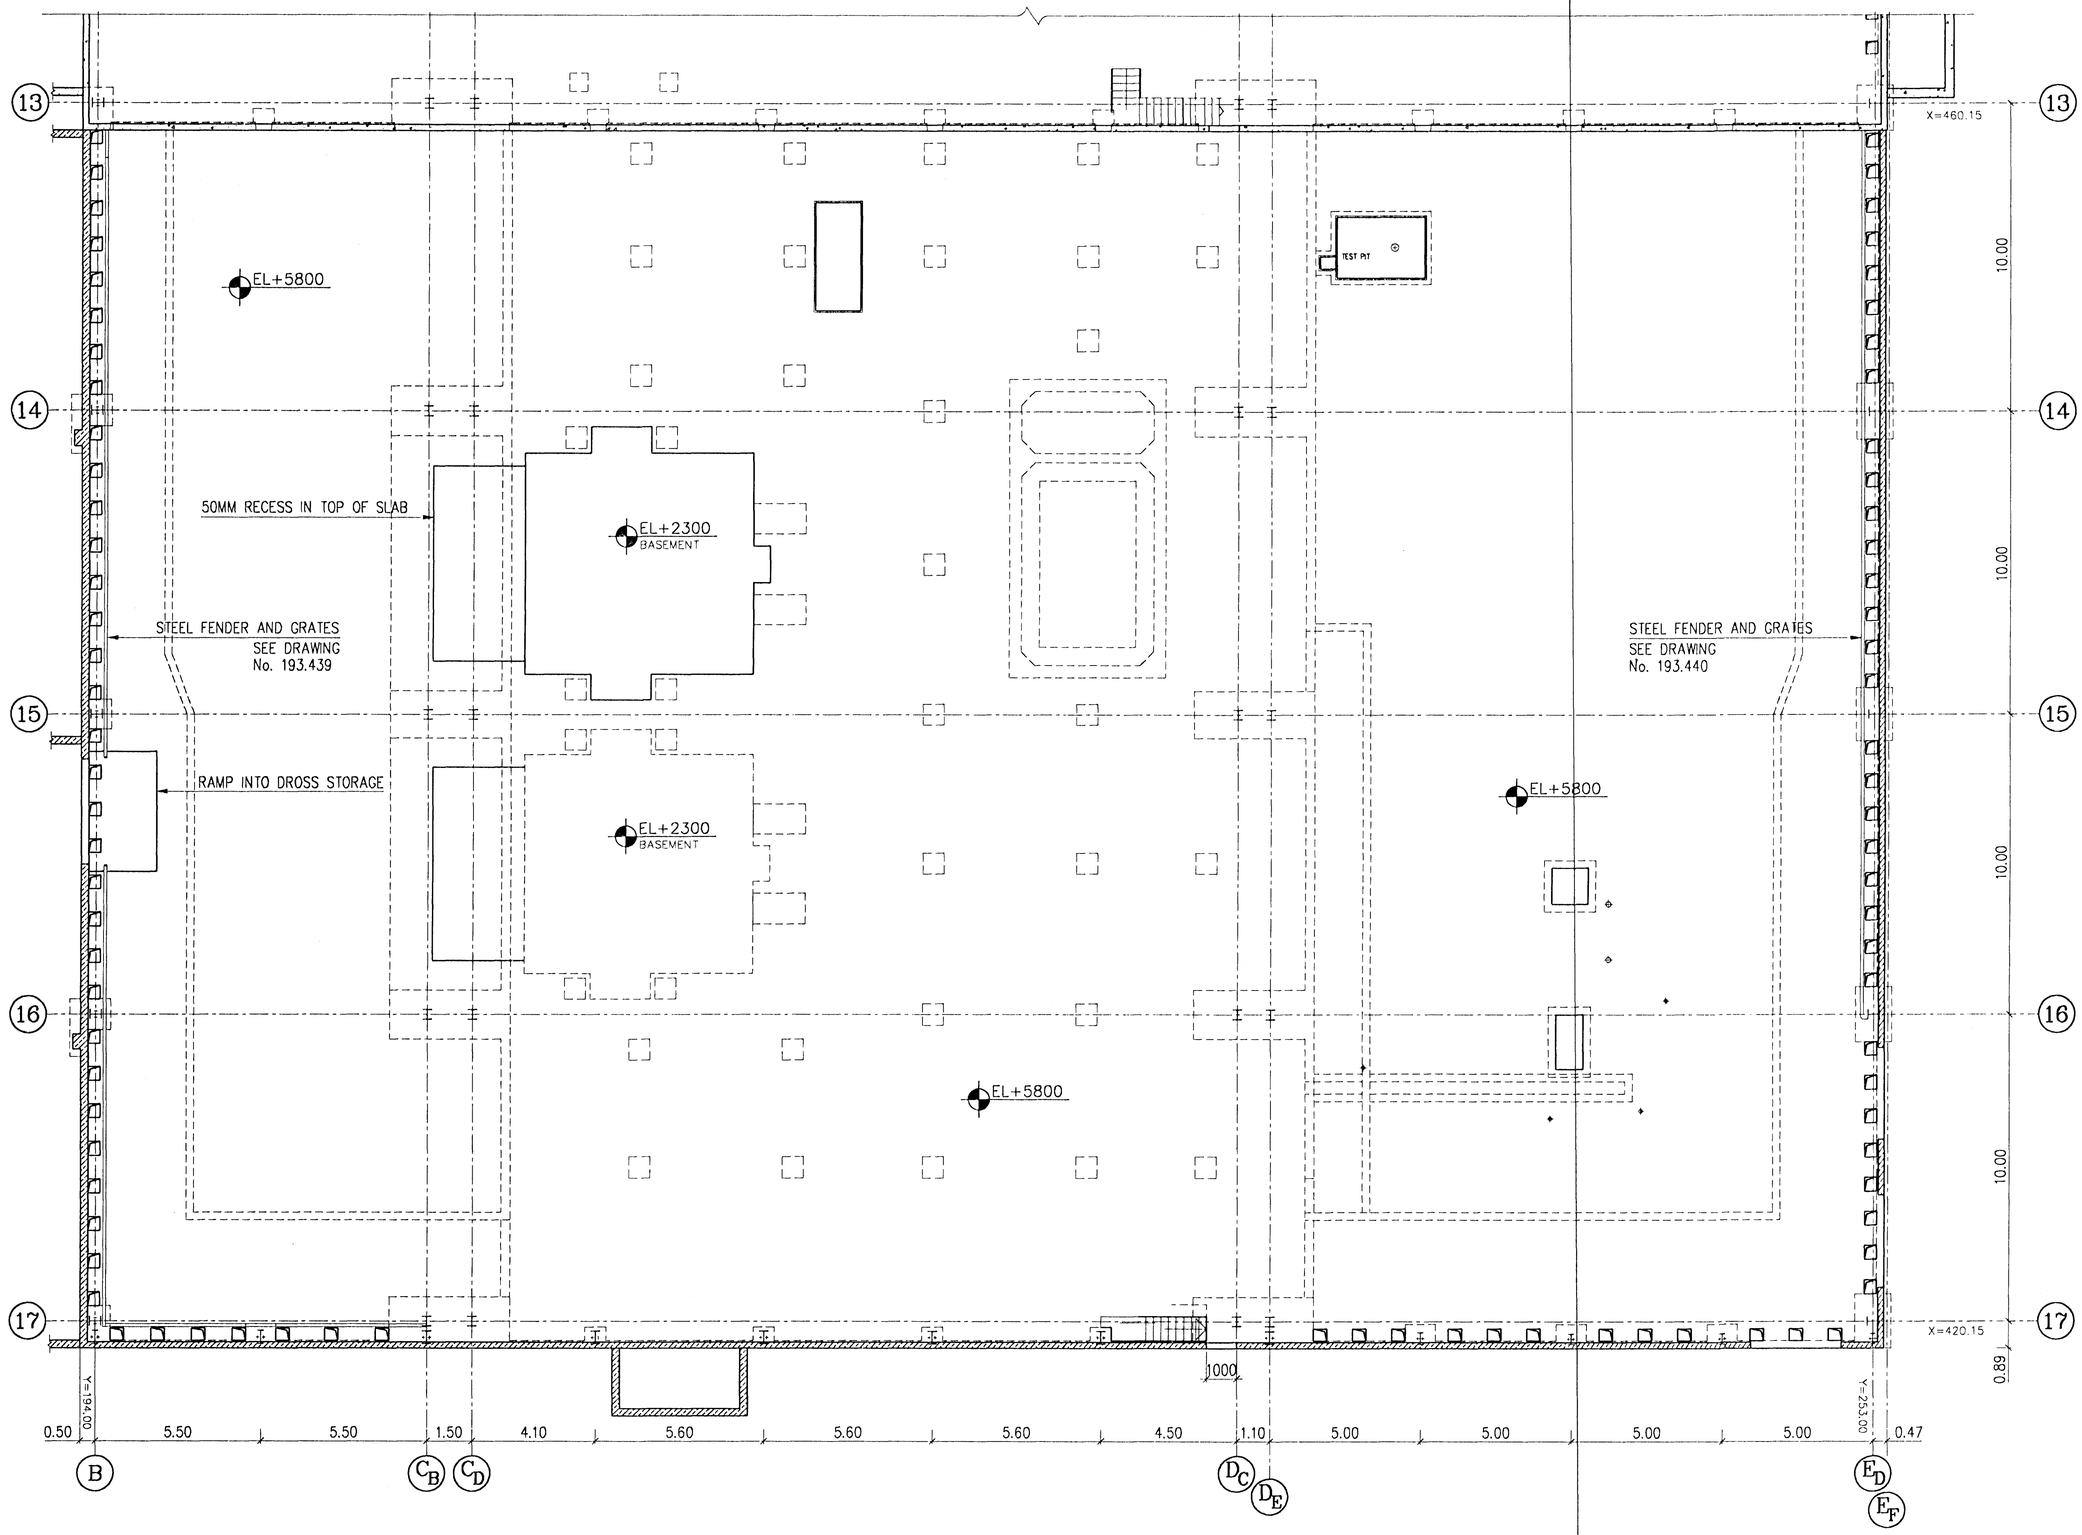

REV. NO.	DATE	REVISION	BY	APP.	REV. NO.	DATE	REVISION	BY	APP.
3 C	30.11.1997	AS BUILD	UH						
2	18.12.1996	VARIOUS CHANGES	UH						
1	15.8.1996	ISSUED FOR CONSTRUCTION	UH						
0	20.5.1996	ISSUED FOR TENDER							

NOTES

REFERENCE DRAWING

DRAWING NUMBER

This drawing is our property and given for personal use only. It may not be copied or made available to others without our permission. The receiver is responsible for any misuse.

ICELANDIC ALUMINIUM COMPANY LTD.

DRAWN	30.4.1996	HHH
APPROVED	30.4.1996	UH
PROCESS		
PROJECT		
SCALE 1:100		FORMAT A1

ALUSUISSE ALESA — ALESA ALUSUISSE ENGINEERING LTD. ZURICH SWITZERLAND

VERKFRAEDISTOFAN ONN SF.
TAEKNITHJONUSTAN SF.

CASTHOUSE EXTENSION
STRUCTURAL
OPERATION FLOOR PLAN
B-E/13-17

79000-34203 — REVISION 3

193.403 — C