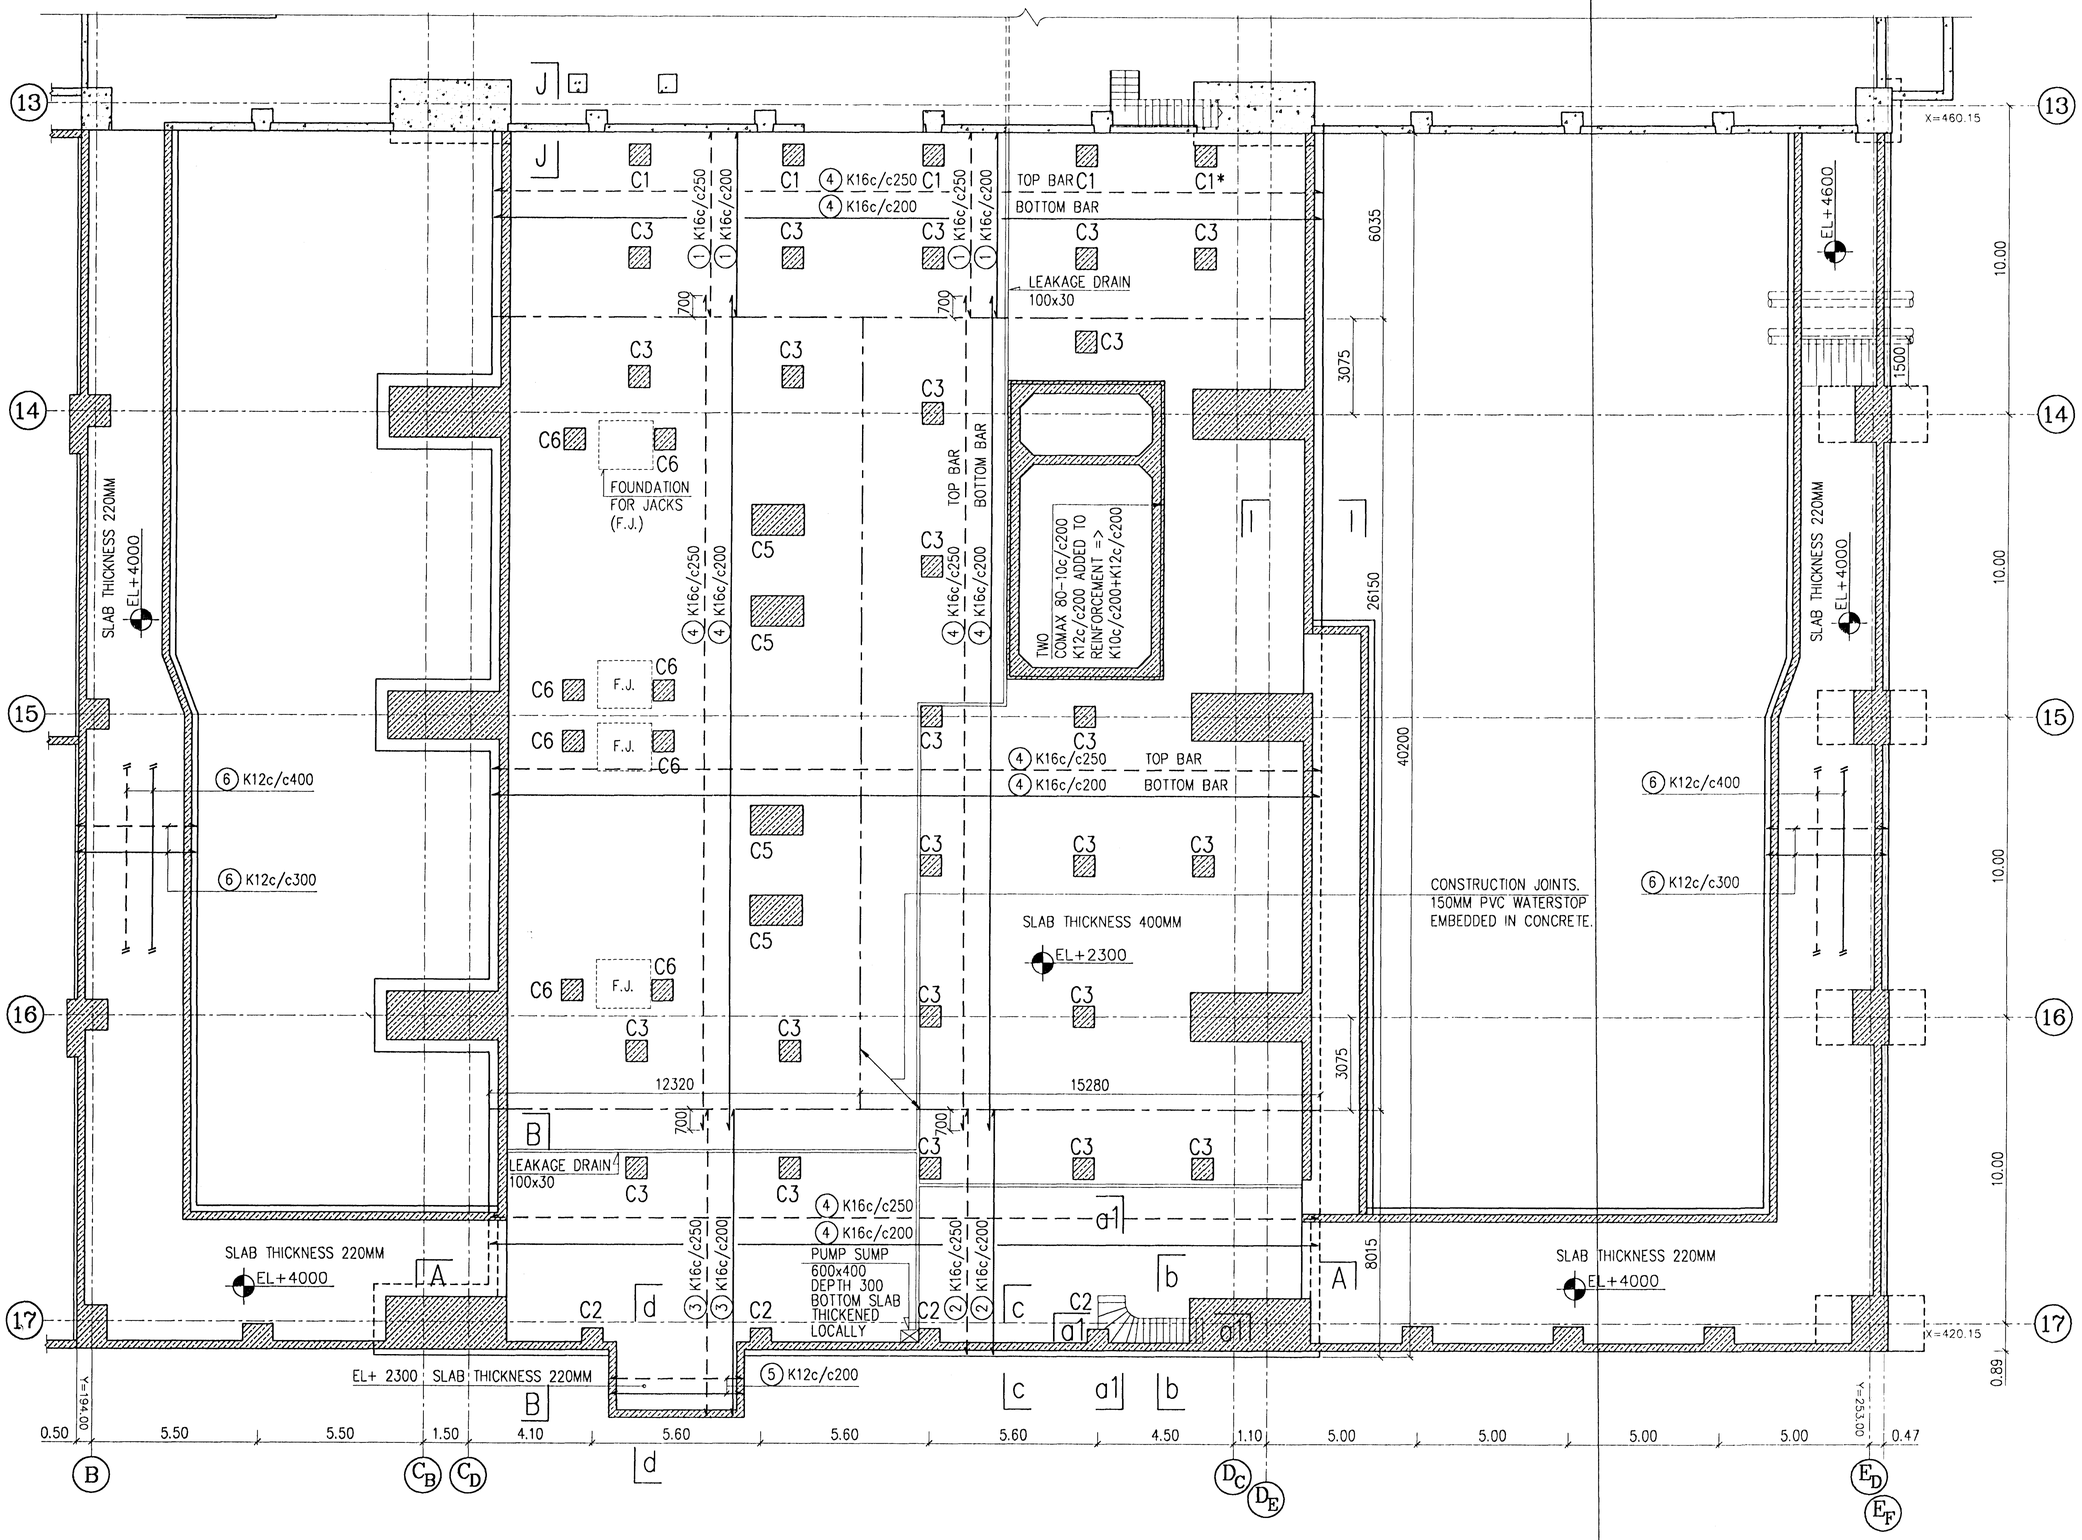


## NOTES:

EXTRA BARS IN SLAB UNDERNEATH COLUMNS. SEE DRAWINGS NO.: 193.412 AND 193.413

| REV. NO. | DATE | REVISION | BY | APP. | REV. NO. | DATE | REVISION | BY | APP. |
|---|---|---|---|---|---|---|---|---|---|
| 2 B | 30.11.1997 | AS BUILD | UH | | | | | | |
| 1 | 15.8.1996 | ISSUED FOR CONSTRUCTION | UH | | | | | | |
| 0 | 20.5.1996 | ISSUED FOR TENDER | | | | | | | |

NOTES

| REFERENCE DRAWING | DRAWING NUMBER |
|---|---|
| SECTIONS I-I AND J-J | 193.415 |
| COLUMNS C4, C5 AND F.J. | 193.412 |
| COLUMNS C2 | 193.409 |
| COLUMNS C1, C3 AND C6 | 193.413 |
| SECTIONS a-a, b-b, c-c and d-d | 193.409 |
| ELEVATION A-A AND B-B | 193.409 |

This drawing is our property and given for personal use only. It may not be copied or made available to others without our permission. The receiver is responsible for any misuse.

ICELANDIC ALUMINIUM COMPANY LTD.

| | | |
|---|---|---|
| DRAWN | 5.5.1996 | HHH |
| APPROVED | 5.5.1996 | UH |
| PROCESS | | |
| PROJECT | | |
| SCALE 1:100 | FORMAT A1 | |

CASTHOUSE EXTENSION
STRUCTURAL
BASEMENT SLAB REINFORCEMENT
B-E/13-17

ALUSUISSE ALESA — ALESA ALUSUISSE ENGINEERING LTD. ZURICH SWITZERLAND

VERKFRAEDISTOFAN ONN SF.
TAEKNITHJONUSTAN SF.

79000-34204 — REVISION 2

193.404 — B