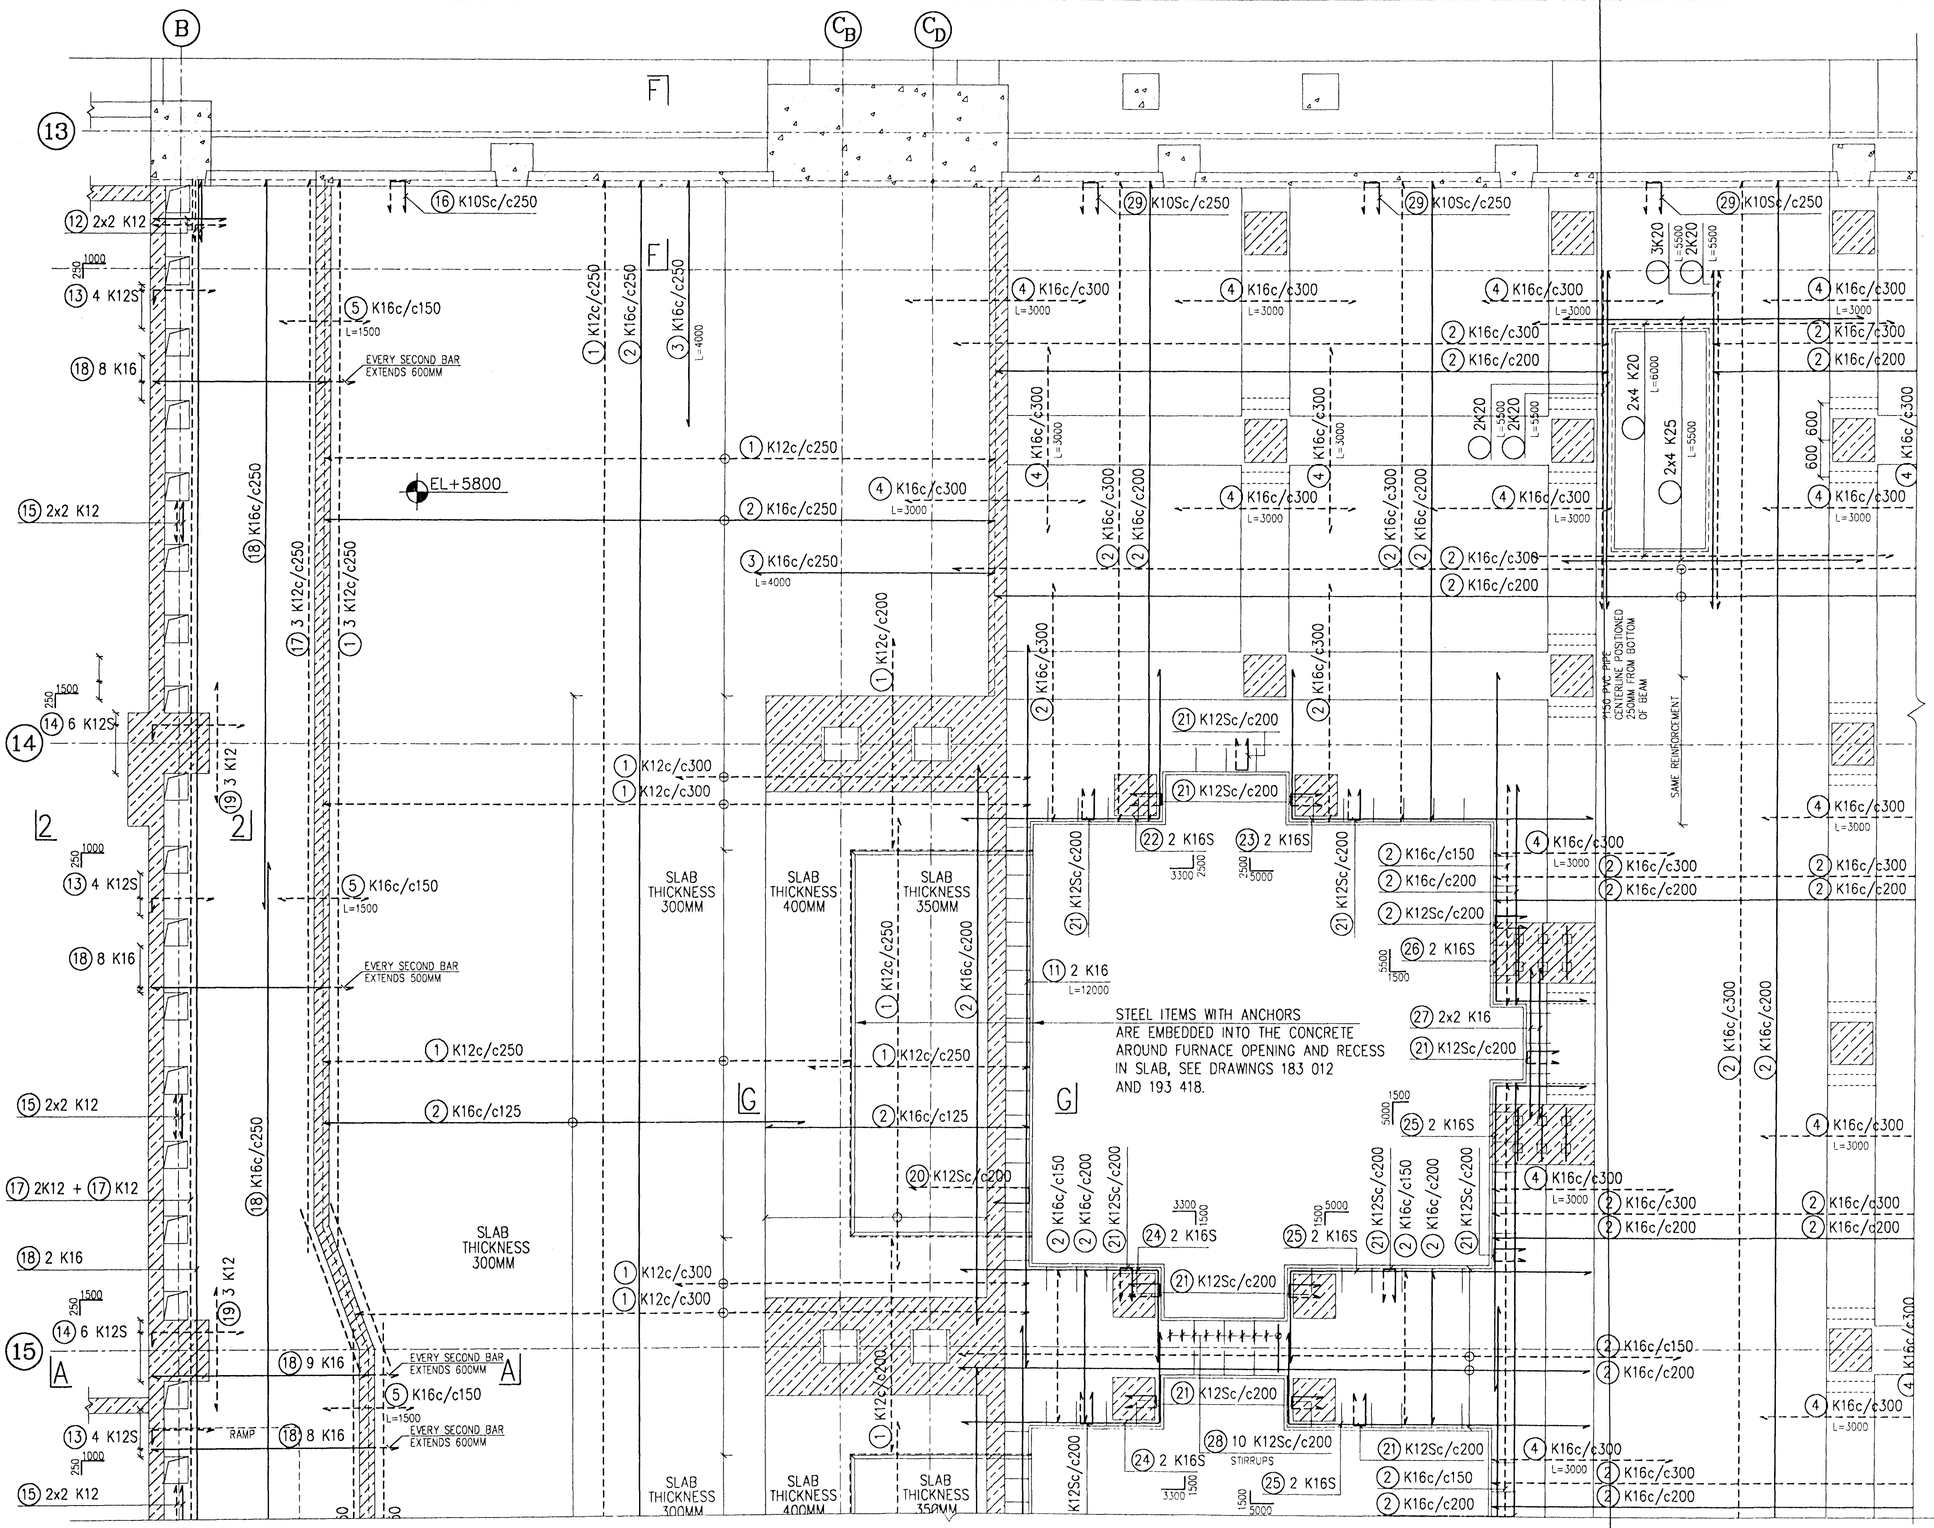


## G–G. 1:20

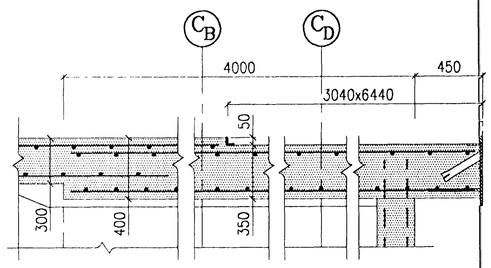


## STEEL FRAME AROUND OPENING IN SLAB. 1:20

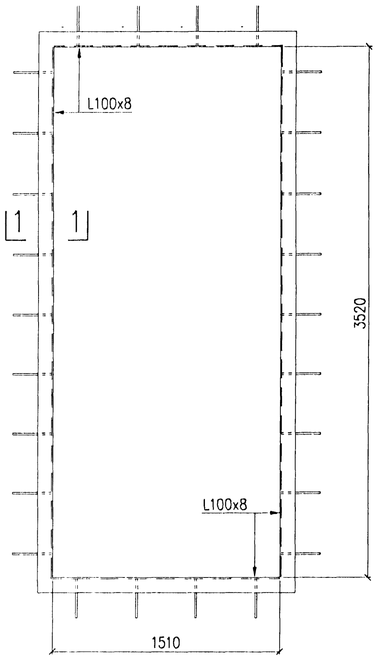


## 1–1. 1:10

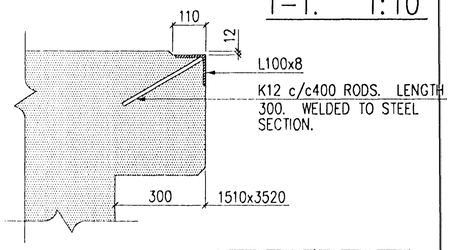


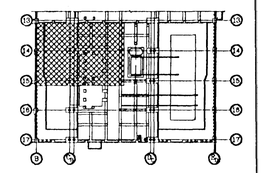

| REV. NO. | DATE | REVISION | BY | APP. |
|---|---|---|---|---|
| 3 C | 14.12.1997 | AS BUILD | UH | |
| 2 | 18.12.1996 | SECTION G–G. DEPTH OF RECESS CHANGED. | UH | |
| 2 | 18.12.1996 | NEW OPENING IN SLAB | UH | |
| 1 | 15.8.1996 | ISSUED FOR CONSTRUCTION | UH | |
| 0 | 20.5.1996 | ISSUED FOR TENDER | | |

| REV. NO. | DATE | REVISION | BY | APP. |
|---|---|---|---|---|

HATCH IN CENTER PART OF SLAB. THE SIZE IS BASED ON DRAWING ISAL 183 004 BY TAEKNITHJONUSTAN, DATED 22.2.1991.

NOTES

| REFERENCE DRAWING | DRAWING NUMBER |
|---|---|
| EMBEDDED STEEL ITEMS | 183 012,193.418 |
| SECTION F–F | 193.415 |
| SECTIONS A–A | 193.414 |
| SECTION 2–2 | 193.491 |

This drawing is our property and given for personal use only. It may not be copied or made available to others without our permission. The receiver is responsible for any misuse.

ICELANDIC ALUMINIUM COMPANY LTD.

| | | |
|---|---|---|
| DRAWN | 20.5.1996 | HHH |
| APPROVED | 20.5.1996 | UH |
| PROCESS | | |
| PROJECT | | |
| SCALE | 1:50 | FORMAT A1 |

ALUSUISSE ALESA — ALESA ALUSUISSE ENGINEERING LTD. ZURICH SWITZERLAND

VERKFRAEDISTOFAN ONN SF. TAEKNITHJONUSTAN SF.

CASTHOUSE EXTENSION
STRUCTURAL
OPERATION FLOOR REINFORCEMENT

79000–34205 — REVISION 3

193.405 — C