_EVATION A
ASEMENT WALL BY LINE 17. 1:50

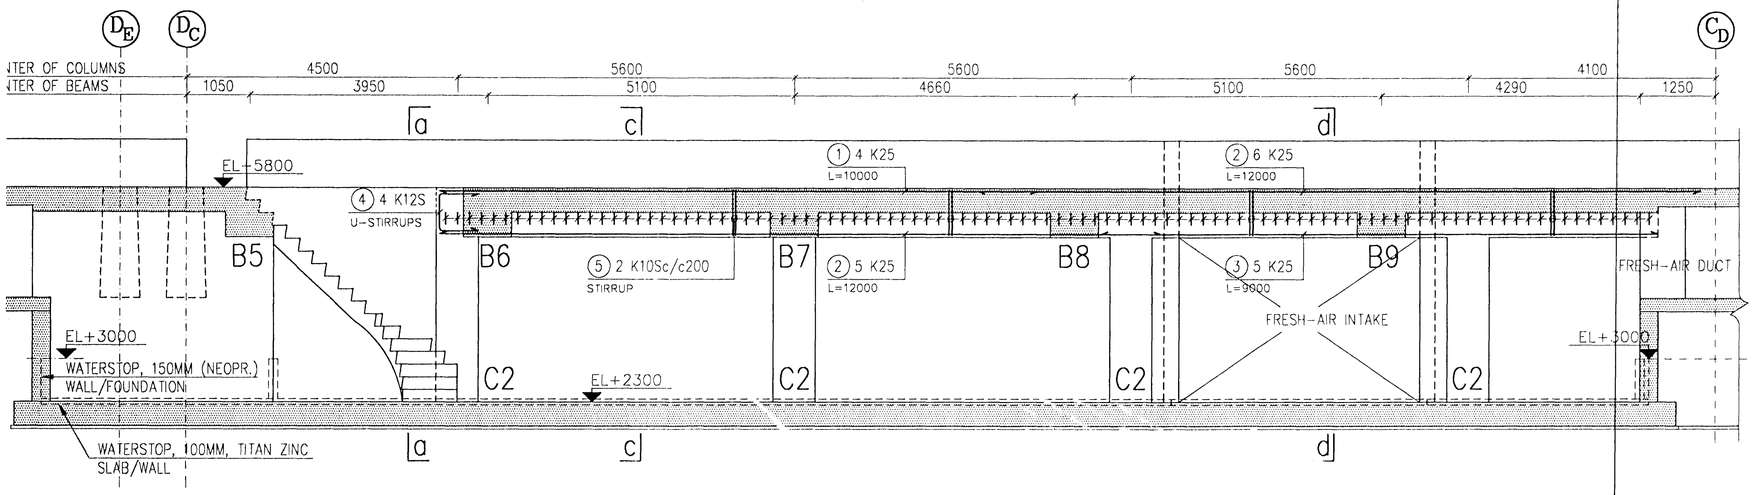

ELEVATION B
BASEMENT WALLS BY AXIS CD AND DC. 1:50

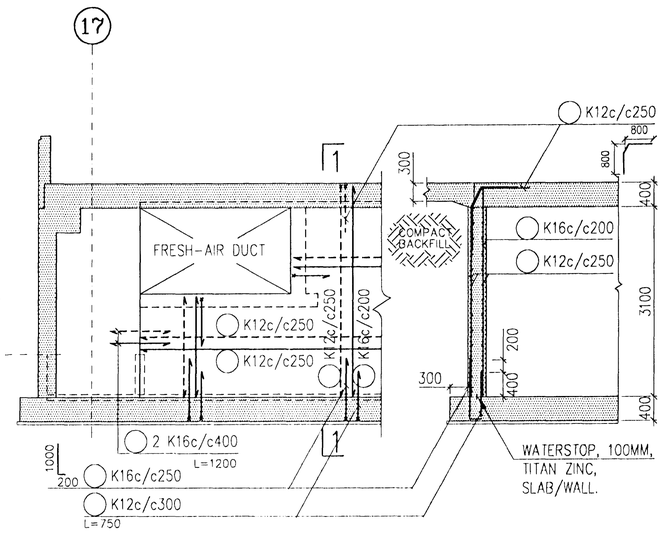

a-a. 1:20

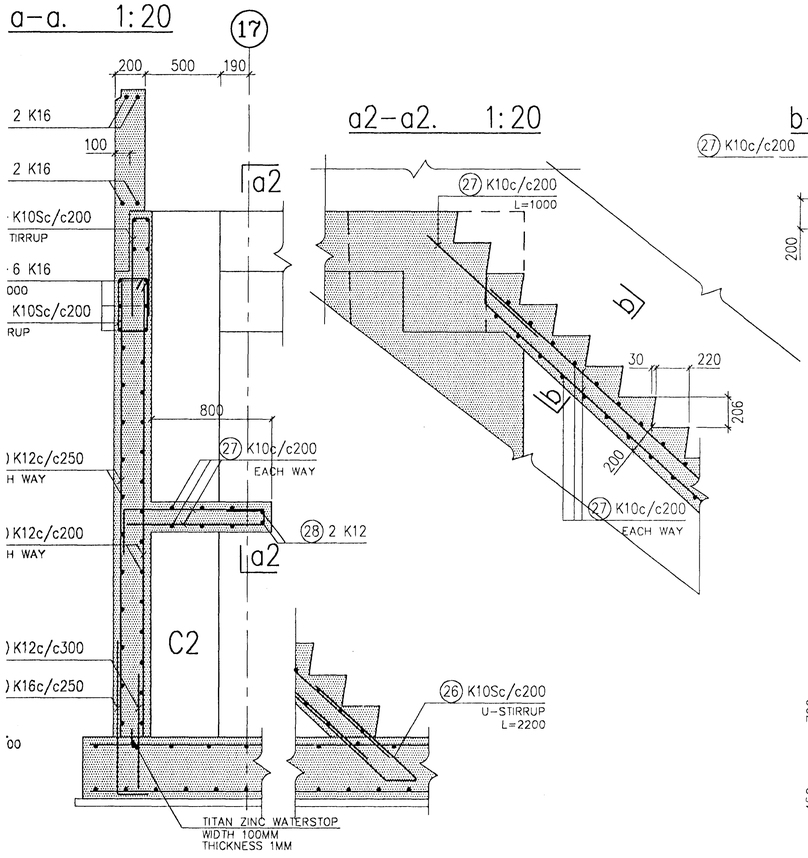

a2-a2. 1:20

b-b. 1:20

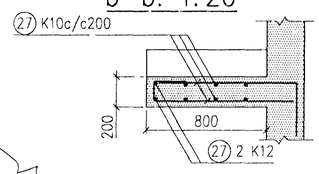

COLUMNS C2. 1:20

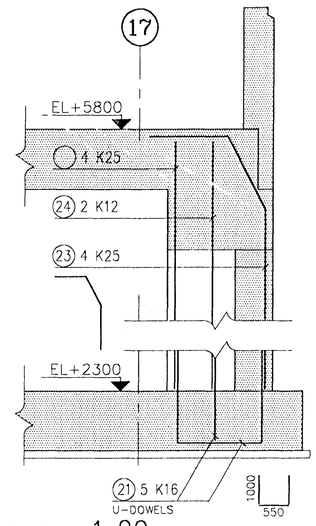

e-e. 1:20

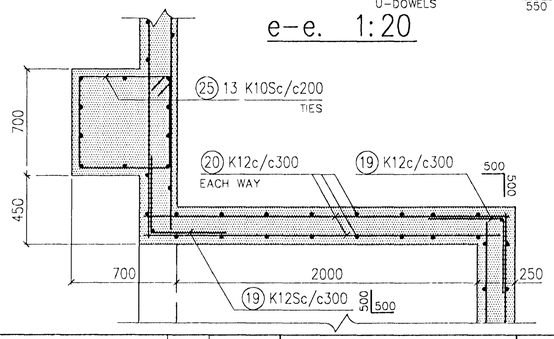

c-c. 1:20

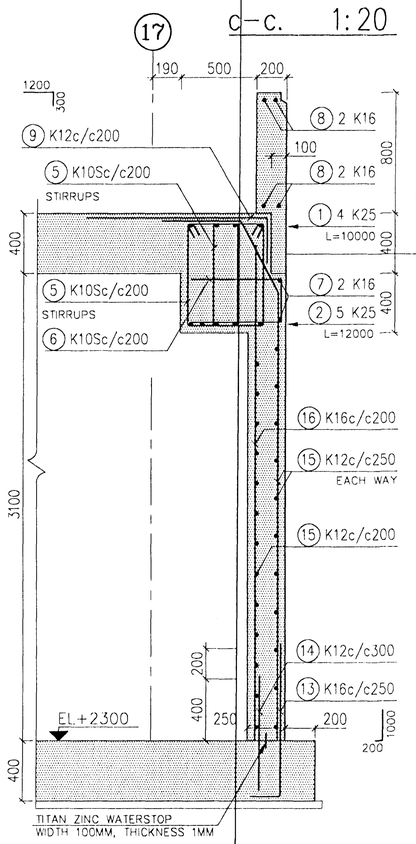

d-d, AIR-INTAKE. 1:20

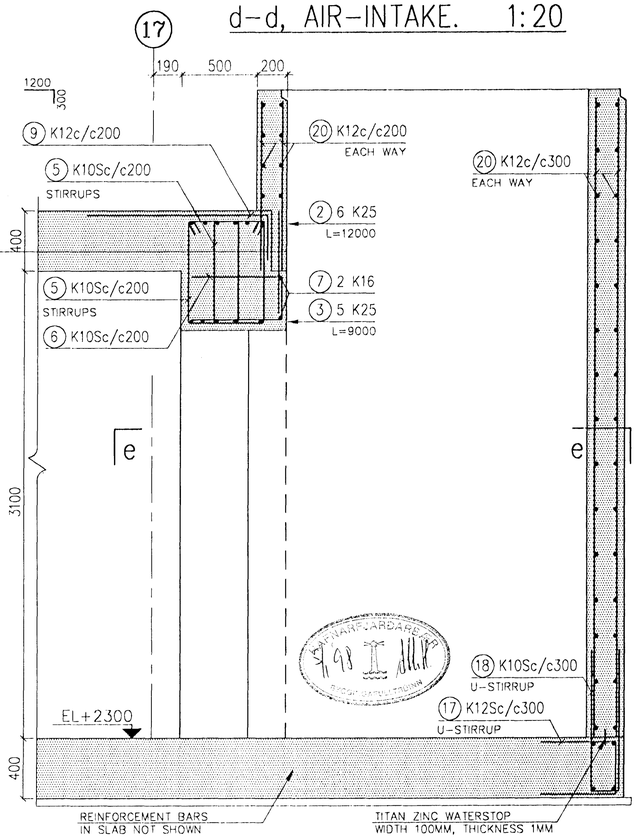

	DATE	REVISION	BY	APP.
B	30.11.1997	AS BUILD	UH	
	15.8.1996	ISSUED FOR CONSTRUCTION	UH	
	20.5.1996	ISSUED FOR TENDER		

REV. NO.	DATE	REVISION	BY	APP.

NOTES

REFERENCE DRAWING	DRAWING NUMBER
FOUNDATION DC, DE IN LINE 17	193.417
FOUNDATION CB, CD IN LINE 17	193.416
SECTION 1 - 1	193.415

This drawing is our property and given for personal use only. It may not be copied or made available to others without our permission. The receiver is responsible for any misuse.

ICELANDIC ALUMINIUM COMPANY LTD.

DRAWN	5.5.95	HHH
APPROVED	5.5.1996	UH
PROCESS		
PROJECT		
SCALE	1:50	FORMAT A1

STRUCTURAL
CASTHOUSE EXTENSION
BASEMENT WALLS, AIR-INTAKE, STAIR, COLUMN C2

ALUSUISSE ALESA
ALESA
ALUSUISSE ENGINEERING LTD.
ZURICH SWITZERLAND

VERKFRAEDISTOFAN ONN SF.
TAEKNITHJONUSTAN SF.

79000-34209 REVISION 2

193.409 B