B8. 1:50

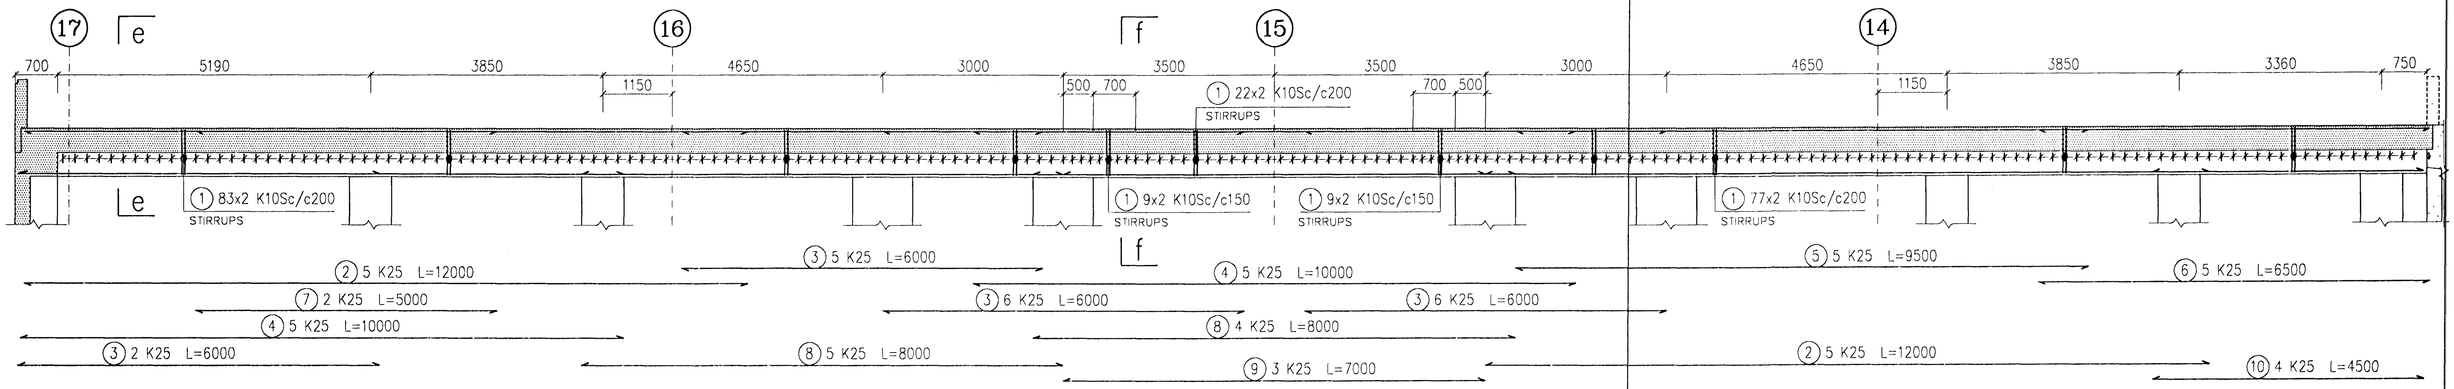

e–e. 1:20

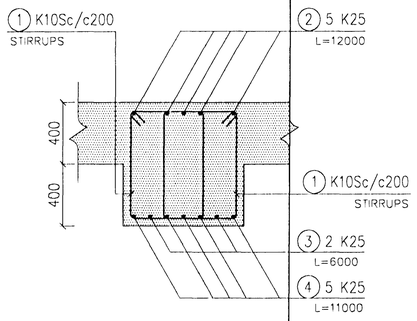

f–f. 1:20

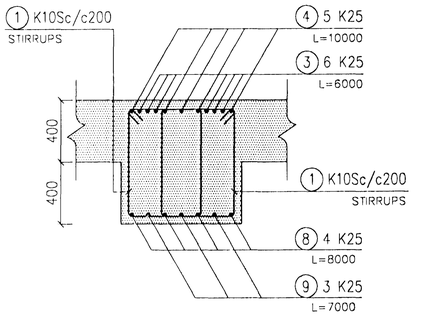

B7. 1:50

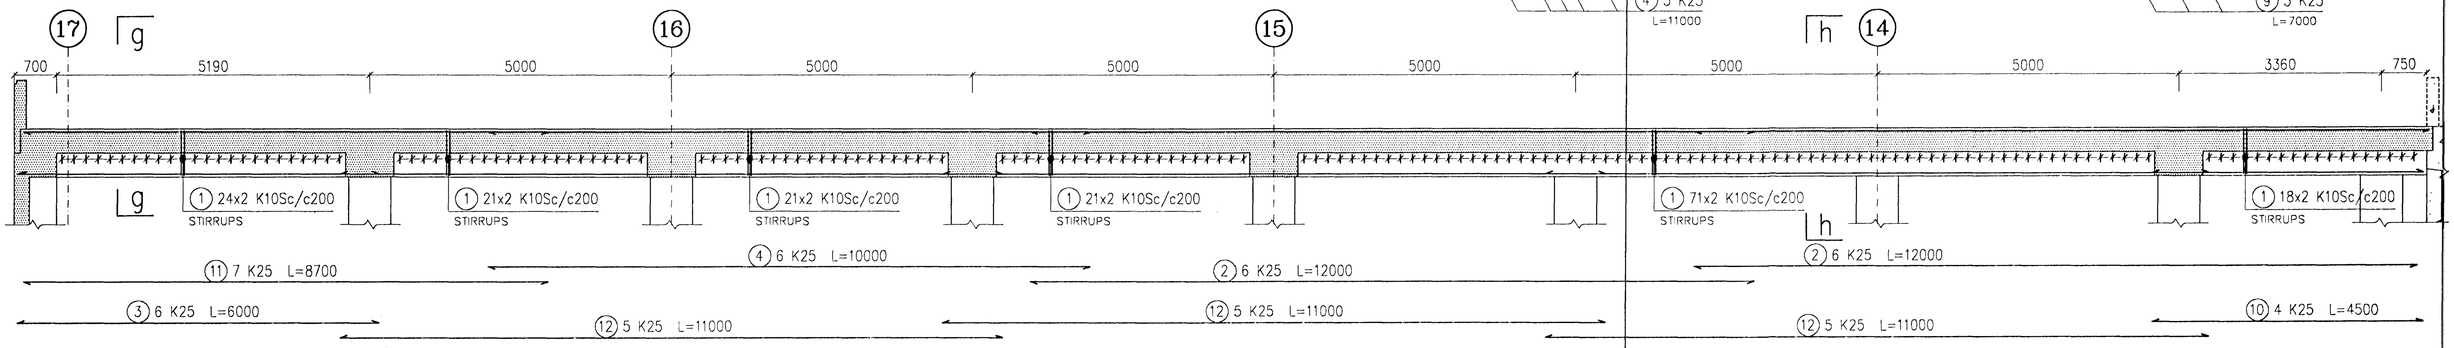

B6. 1:50

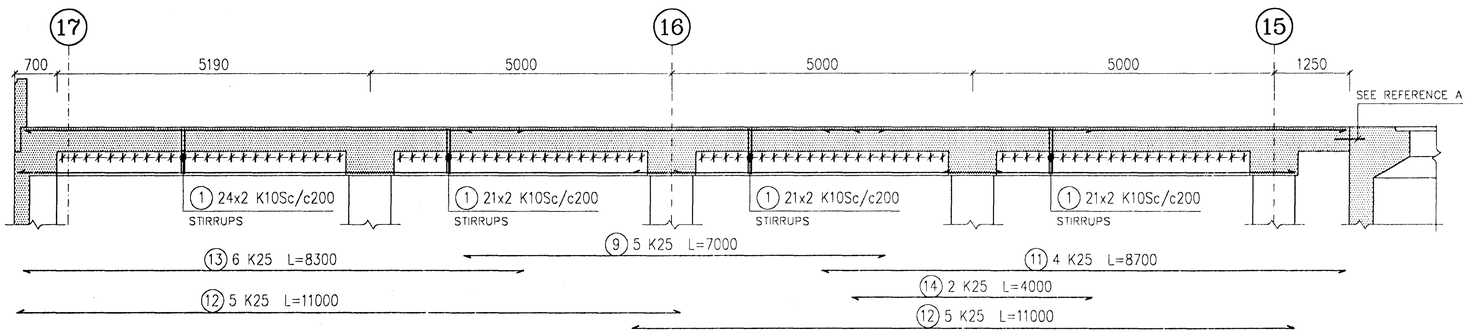

g–g. 1:20

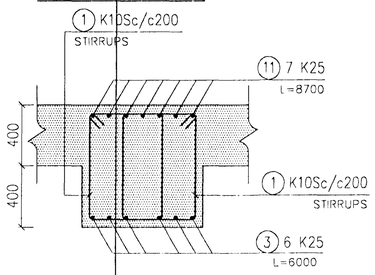

h–h. 1:20

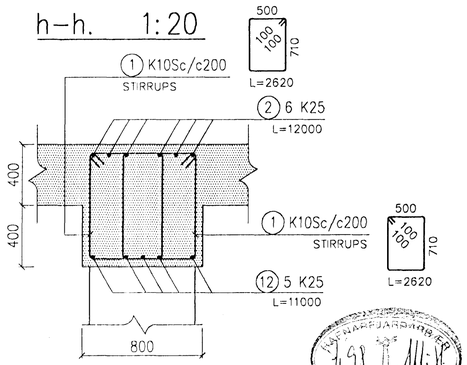

REV. NO.	DATE	REVISION	BY	APP.
2 B	14.12.1997	AS BUILD	UH	
1	15.8.1996	ISSUED FOR CONSTRUCTION	UH	
0	20.5.1996	ISSUED FOR TENDER		

REV. NO.	DATE	REVISION	BY	APP.

NOTES

REFERENCE A: CASTING MACHINE PIT

REFERENCE DRAWING

193.443

DRAWING NUMBER

This drawing is our property and given for personal use only. It may not be copied or made available to others without our permission. The receiver is responsible for any misuse.

ICELANDIC ALUMINIUM COMPANY LTD.

DRAWN	30.4.1996	HHH
APPROVED	30.4.1996	UH
PROCESS		
PROJECT		
SCALE 1:50	FORMAT A1	

ALUSUISSE ALESA — ALESA ALUSUISSE ENGINEERING LTD. ZURICH SWITZERLAND

VERKFRAEDISTOFAN ONN SF. TAEKNITHJONUSTAN SF.

STRUCTURAL
CASTHOUSE EXTENSION
OPERATION FLOOR
BEAMS B6, B7 AND B8.

79000-34210 — REVISION 2

193.410 — B