B5*. 1:50

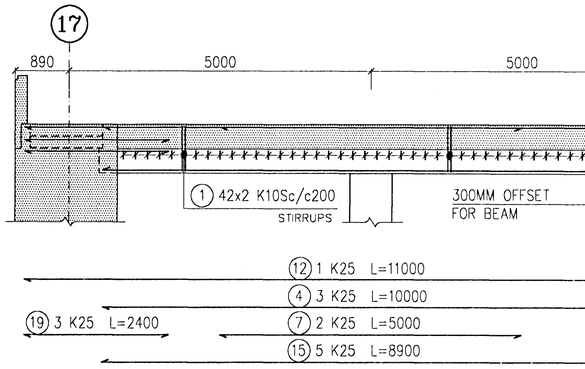

B5. 1:50

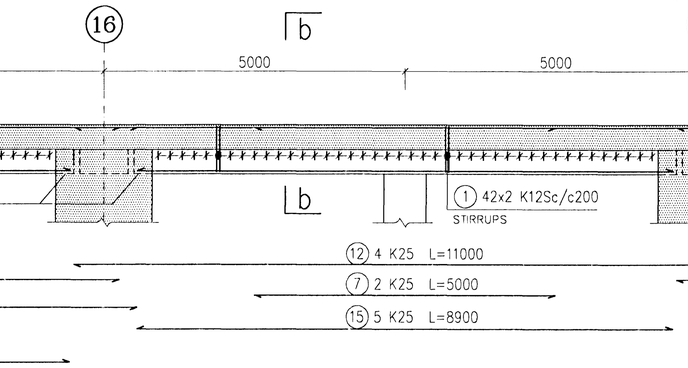

B4. 1:50

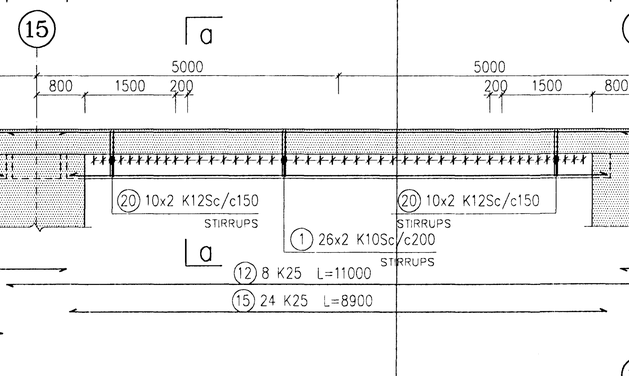

B3. 1:50

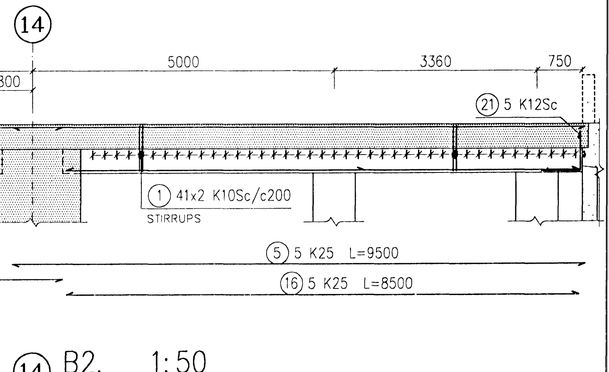

B9. 1:50

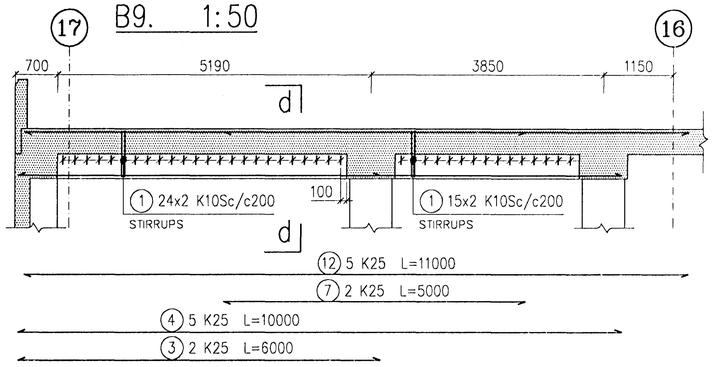

d–d. 1:20

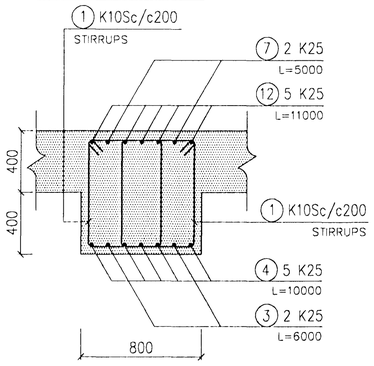

a–a. 1:20

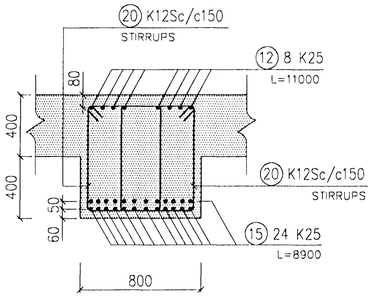

b–b. 1:20

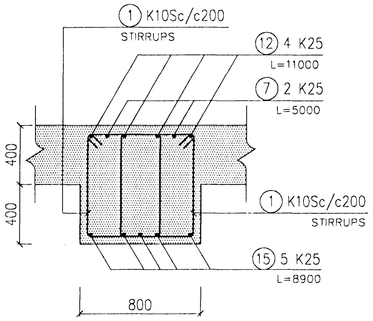

14 B2. 1:50

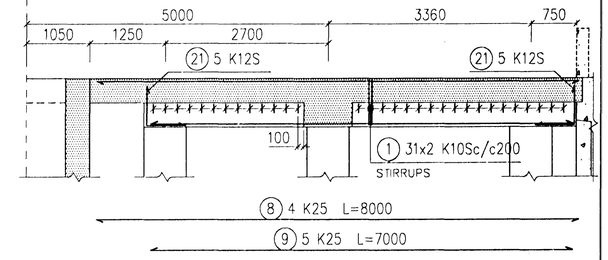

14 B2*. 1:50

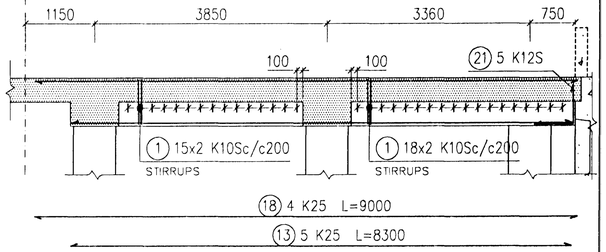

B1. 1:50

QUANTITY: 3 PC.

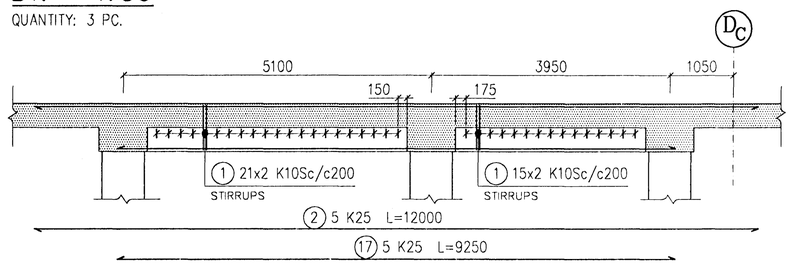

B1*. 1:50

QUANTITY: 2 PC.
IN THE BEAM IN LINE 15 THE STIRRUPS
GO THROUGH THE WHOLE LENGTH.

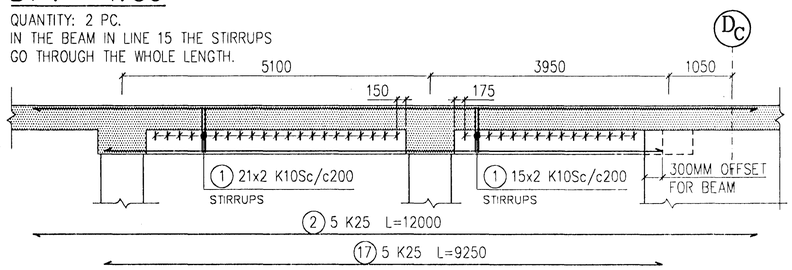

B1**. 1:50

QUANTITY: 4 PC.
IN THE TWO BEAMS CLOSE TO LINES 14 AND 16
THE STIRRUPS GO THROUGH THE WHOLE LENGTH.

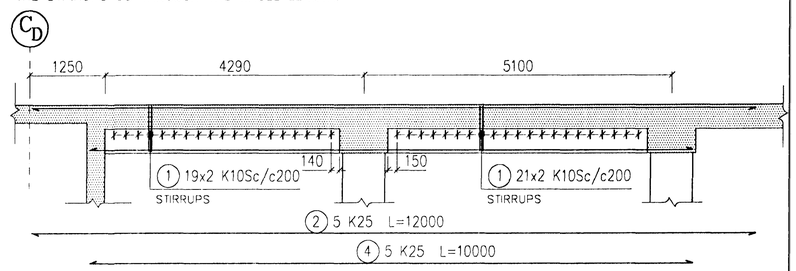

REV. NO.	DATE	REVISION	BY	APP.
2 B	14.12.1997	AS BUILD	UH	
1	15.8.1996	ISSUED FOR CONSTRUCTION	UH	
0	20.5.1996	ISSUED FOR TENDER		

REV. NO.	DATE	REVISION	BY	APP.

NOTES

REFERENCE DRAWING

DRAWING NUMBER

This drawing is our property and given for personal use only. It may not be copied or made available to others without our permission. The receiver is responsible for any misuse.

ICELANDIC ALUMINIUM COMPANY LTD.

DRAWN	30.4.1996	HHH
APPROVED	30.4.1996	UH
PROCESS		
PROJECT		
SCALE 1:50	FORMAT A1	

ALUSUISSE ALESA — ALUSUISSE ENGINEERING LTD. ZURICH SWITZERLAND

VERKFRAEDISTOFAN ONN SF.
TAEKNITHJONUSTAN SF.

STRUCTURAL
CASTHOUSE EXTENSION
OPERATION FLOOR
BEAMS B1 – B5 AND B9

79000–34211 — REVISION 2

193.411 — B