

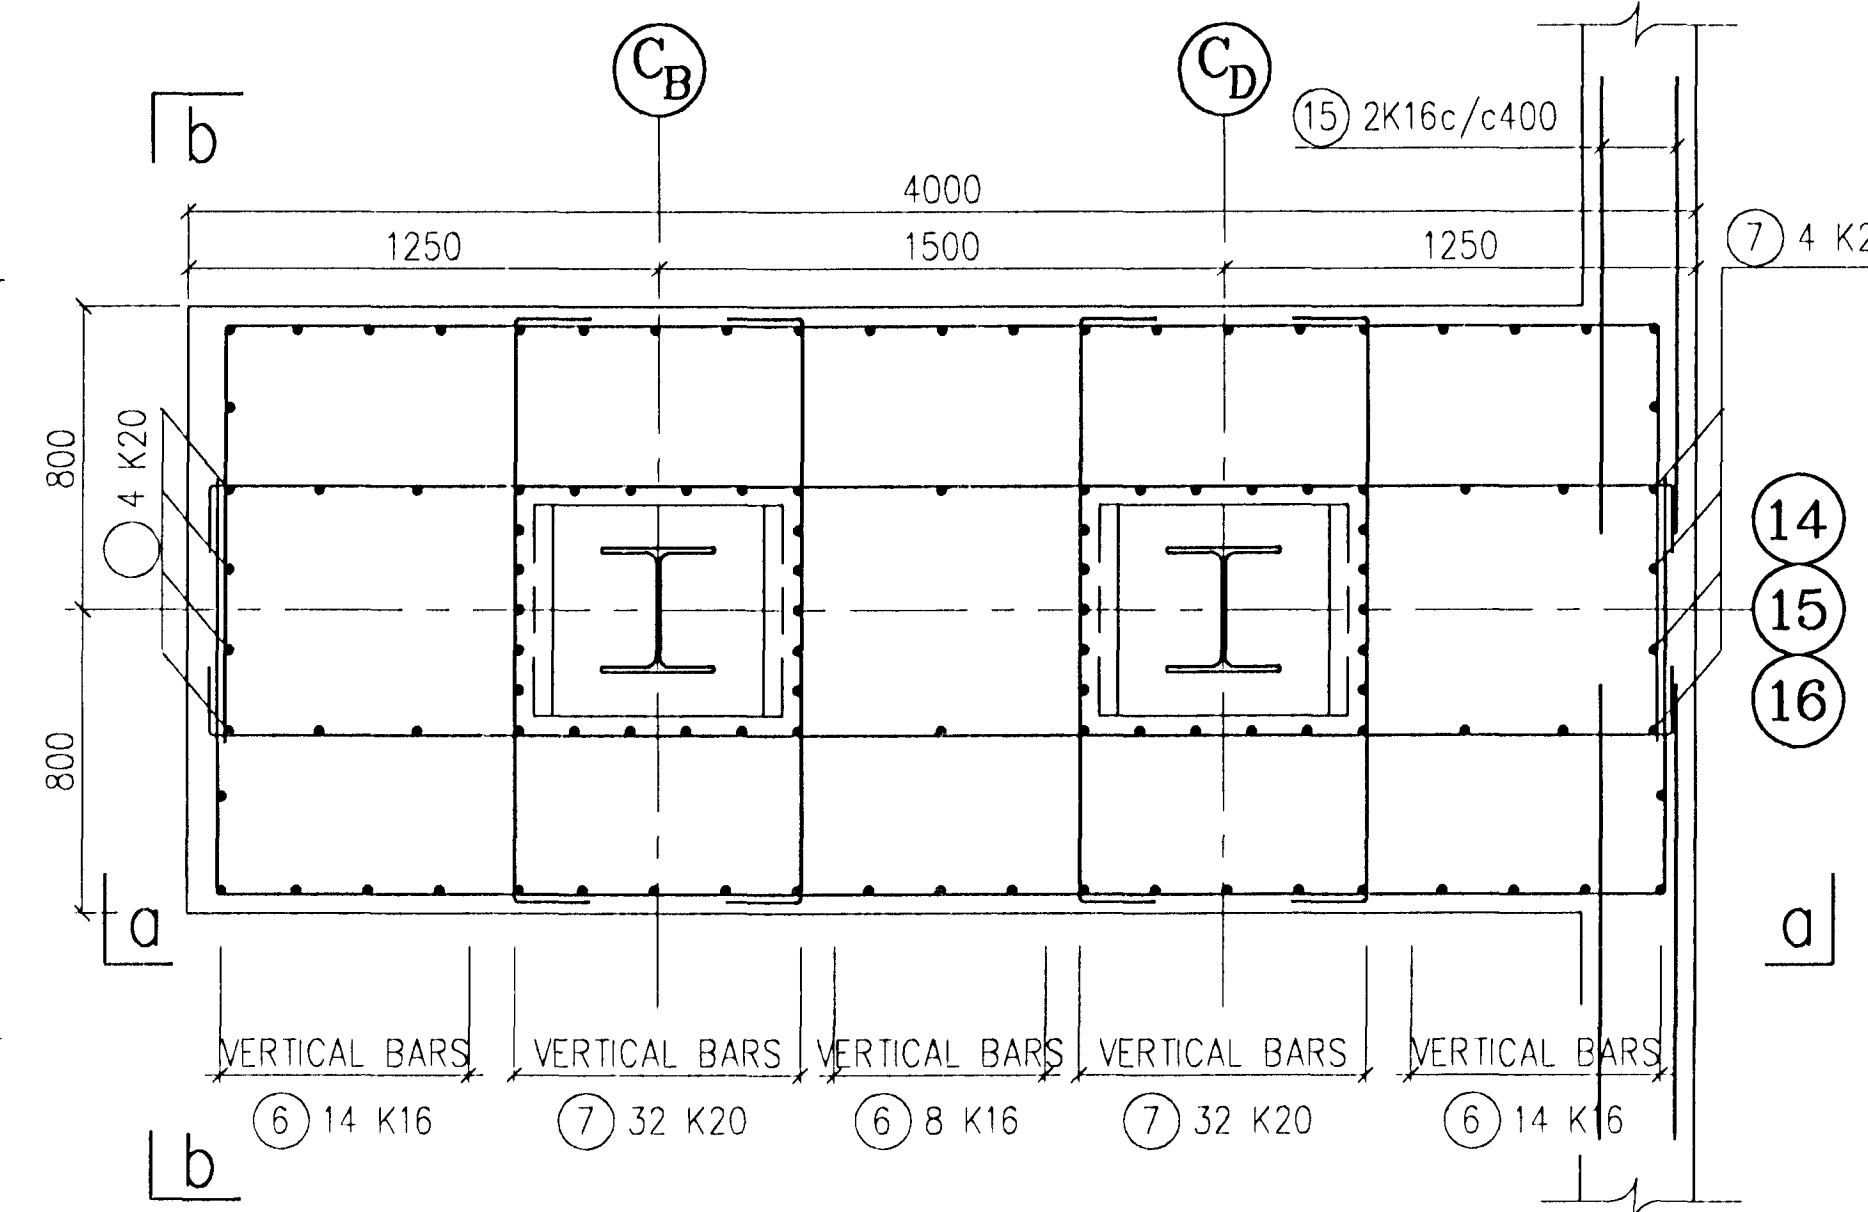
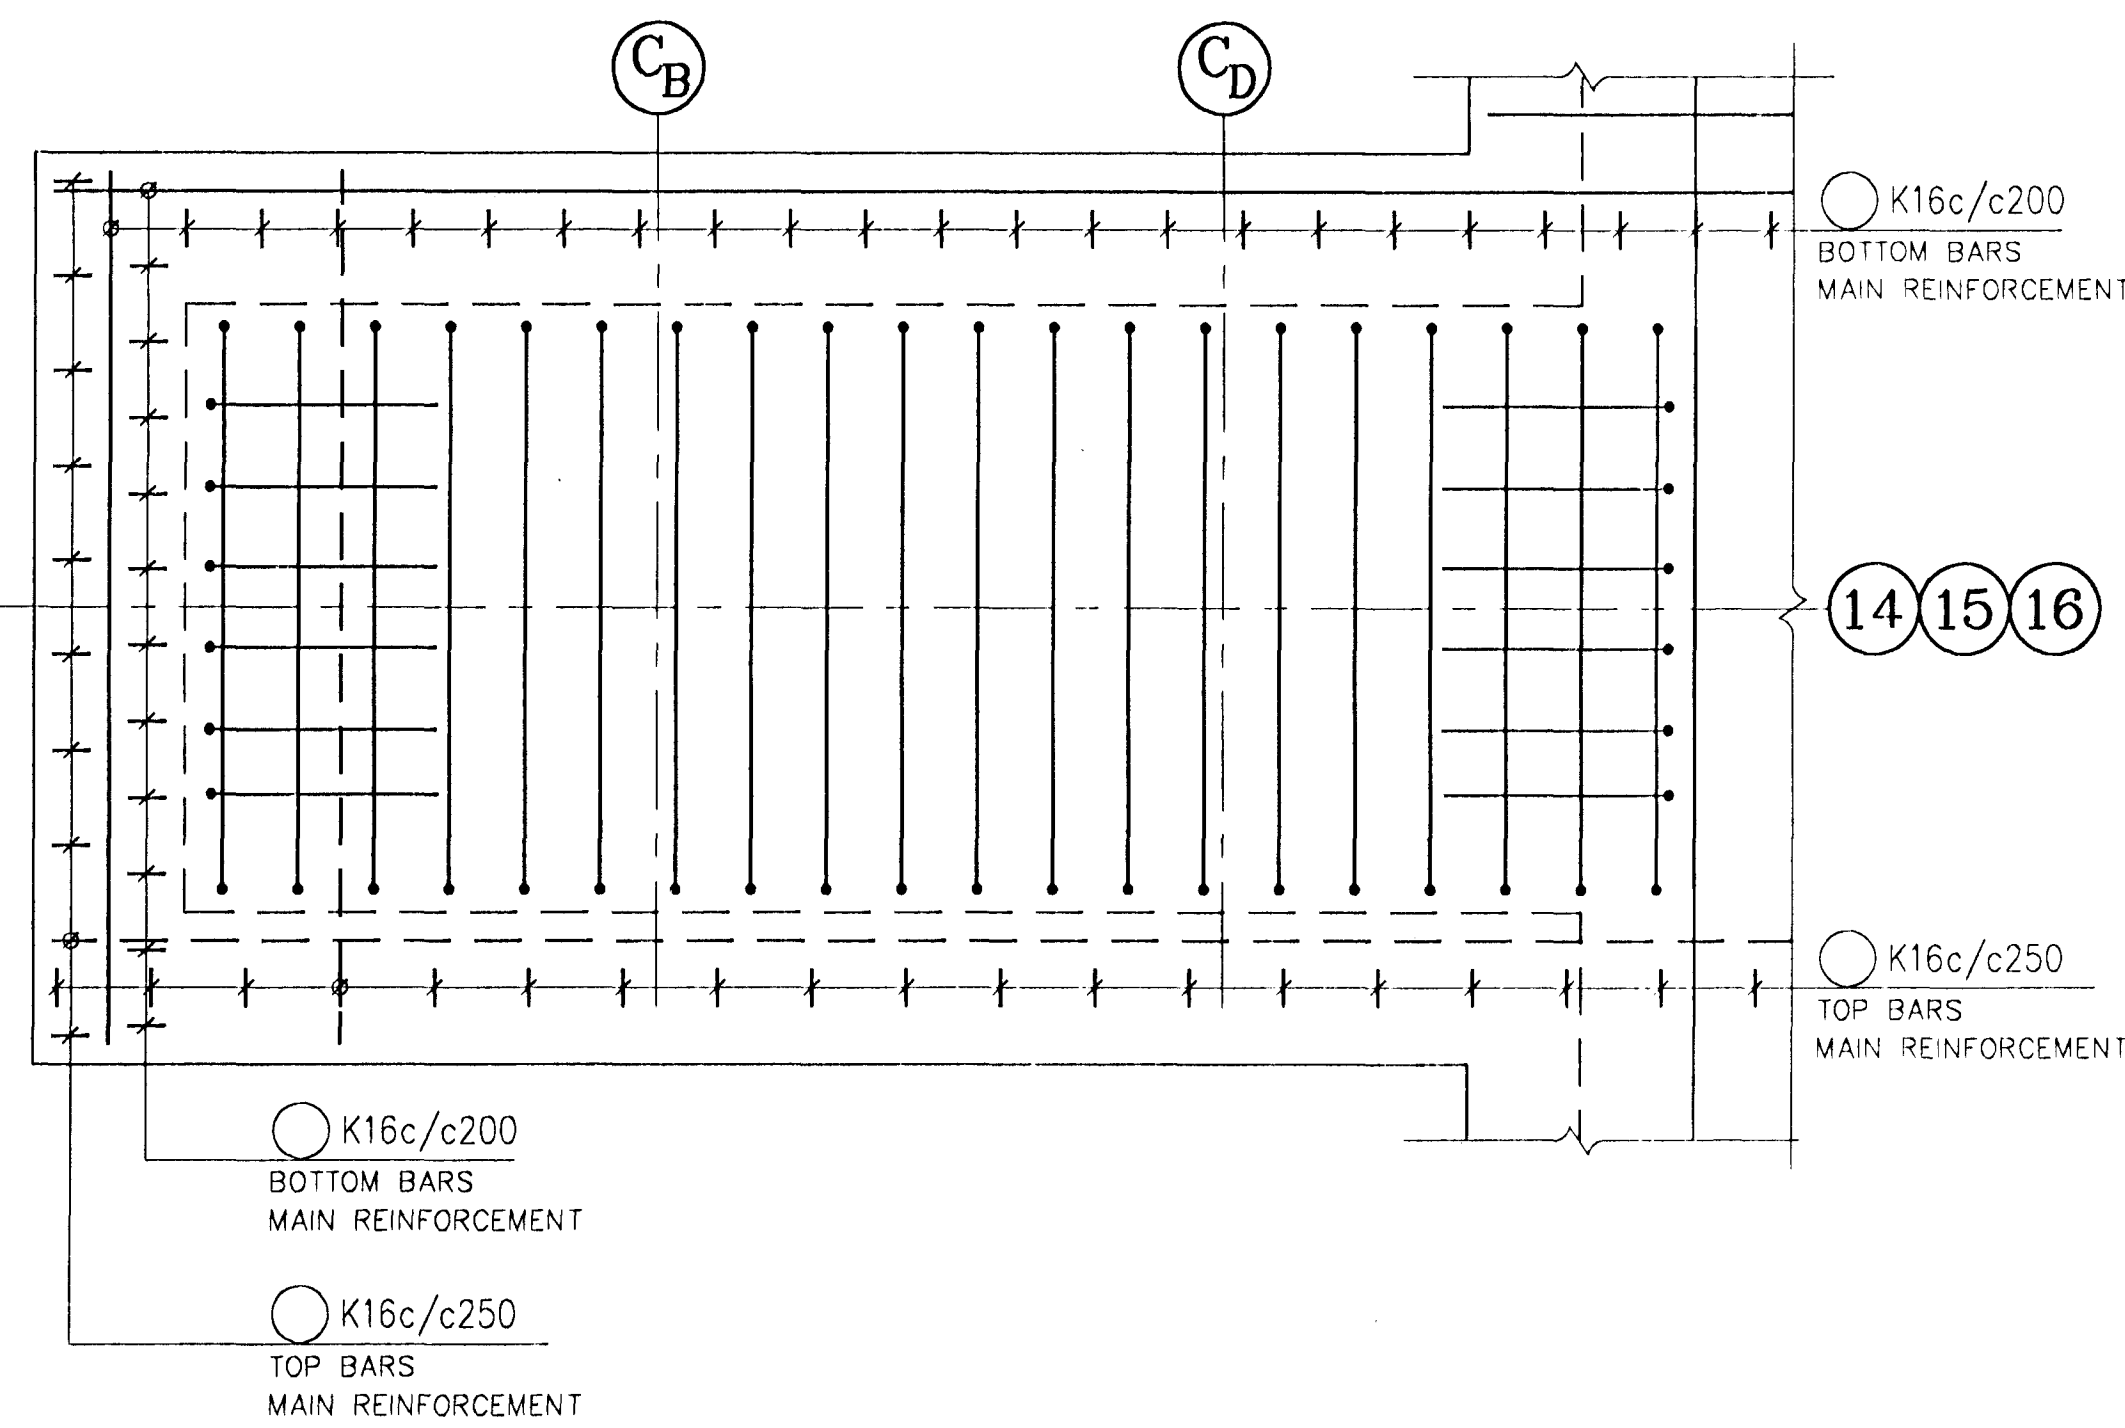



FOUNDATIONS IN AXES CB,CD AND LINES 14, 15 AND 16. 1:20  
 QUANTITY: 3 PC.

 


FOUNDATIONS IN AXES DC,DE AND LINES 14, 15 AND 16. 1:20  
 QUANTITY: 3 PC.

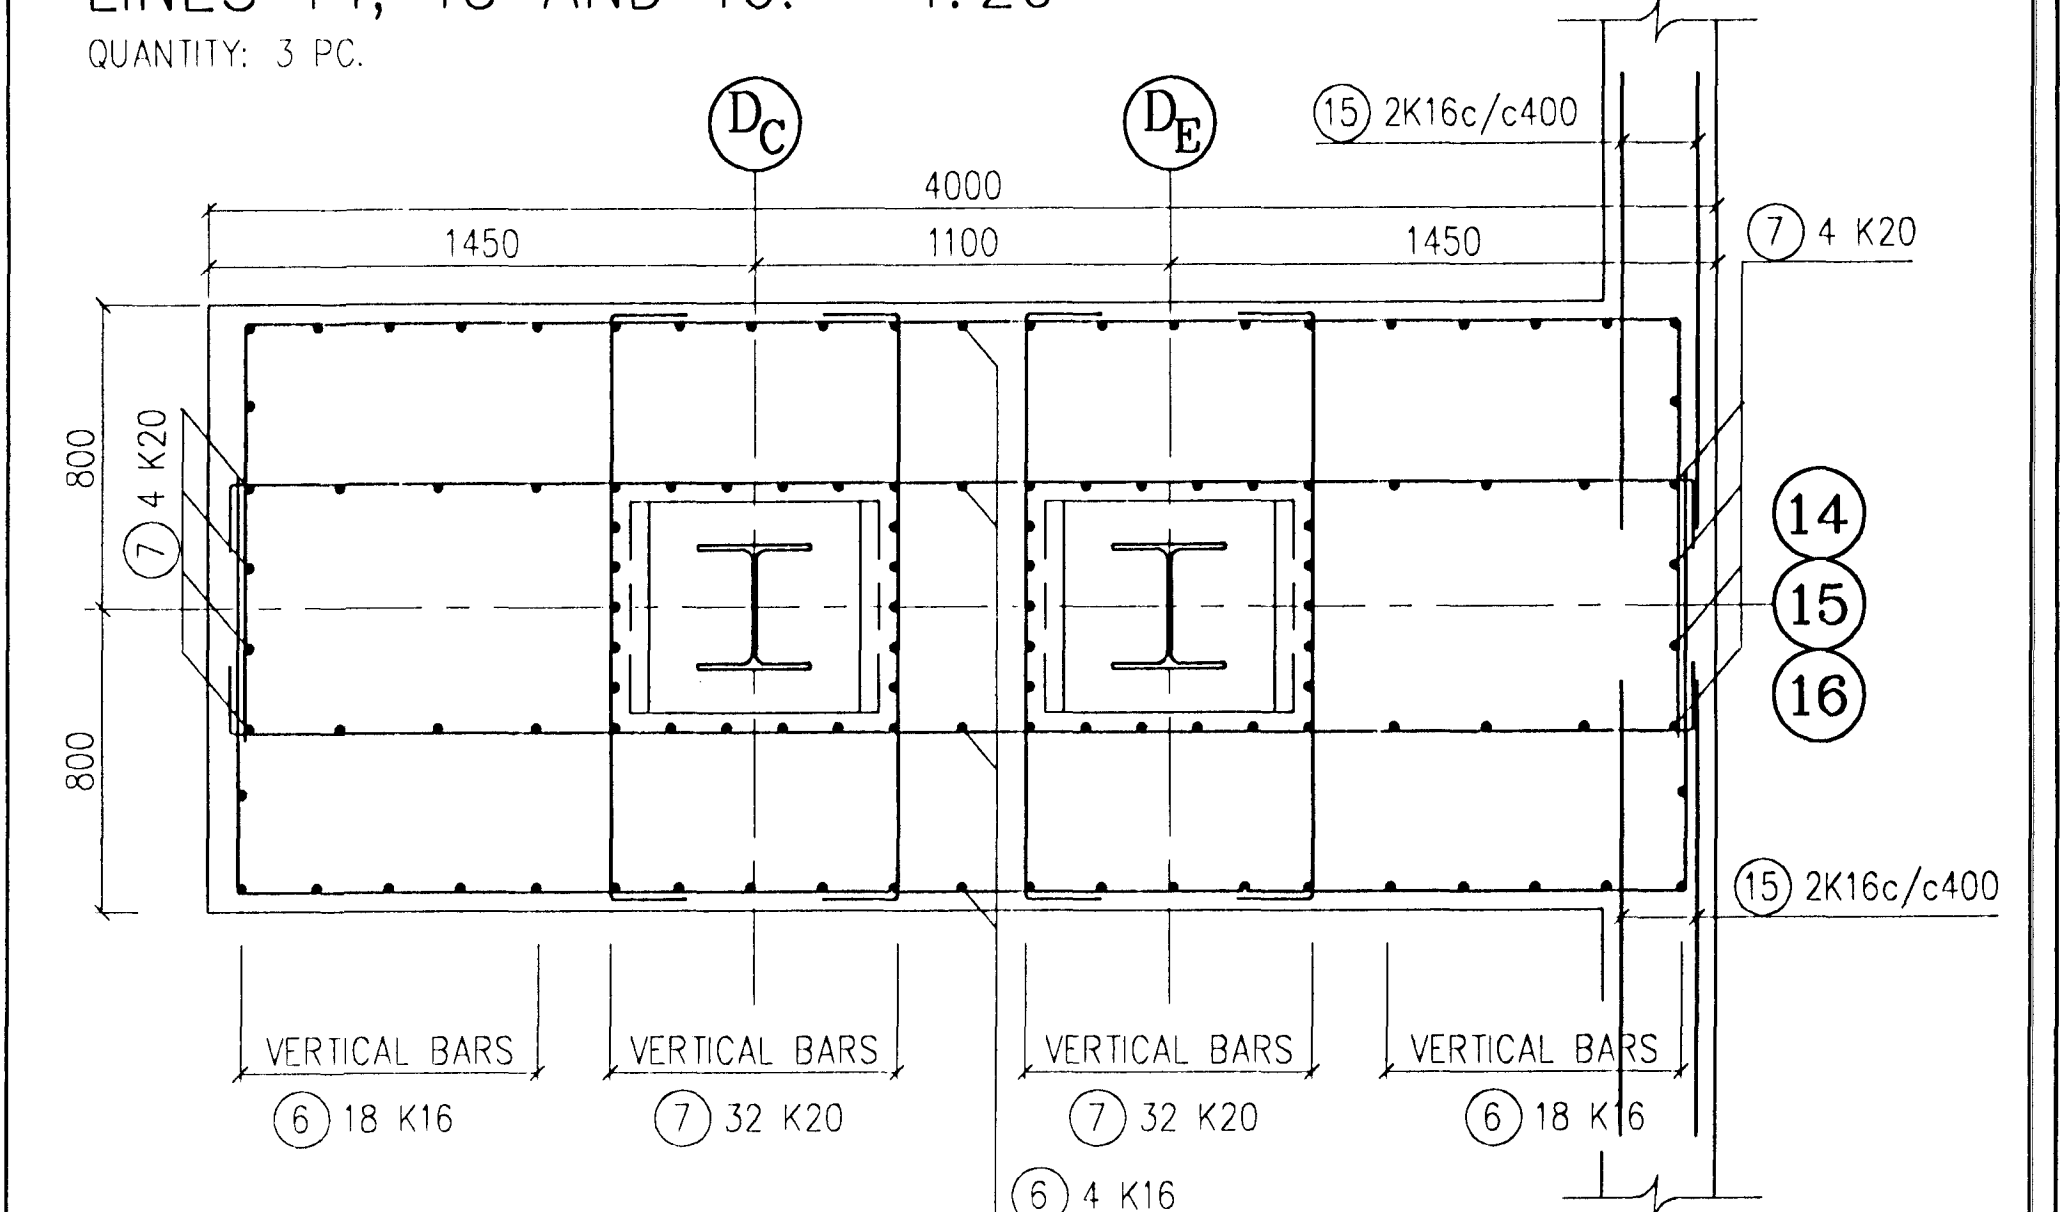


a-a. 1:20

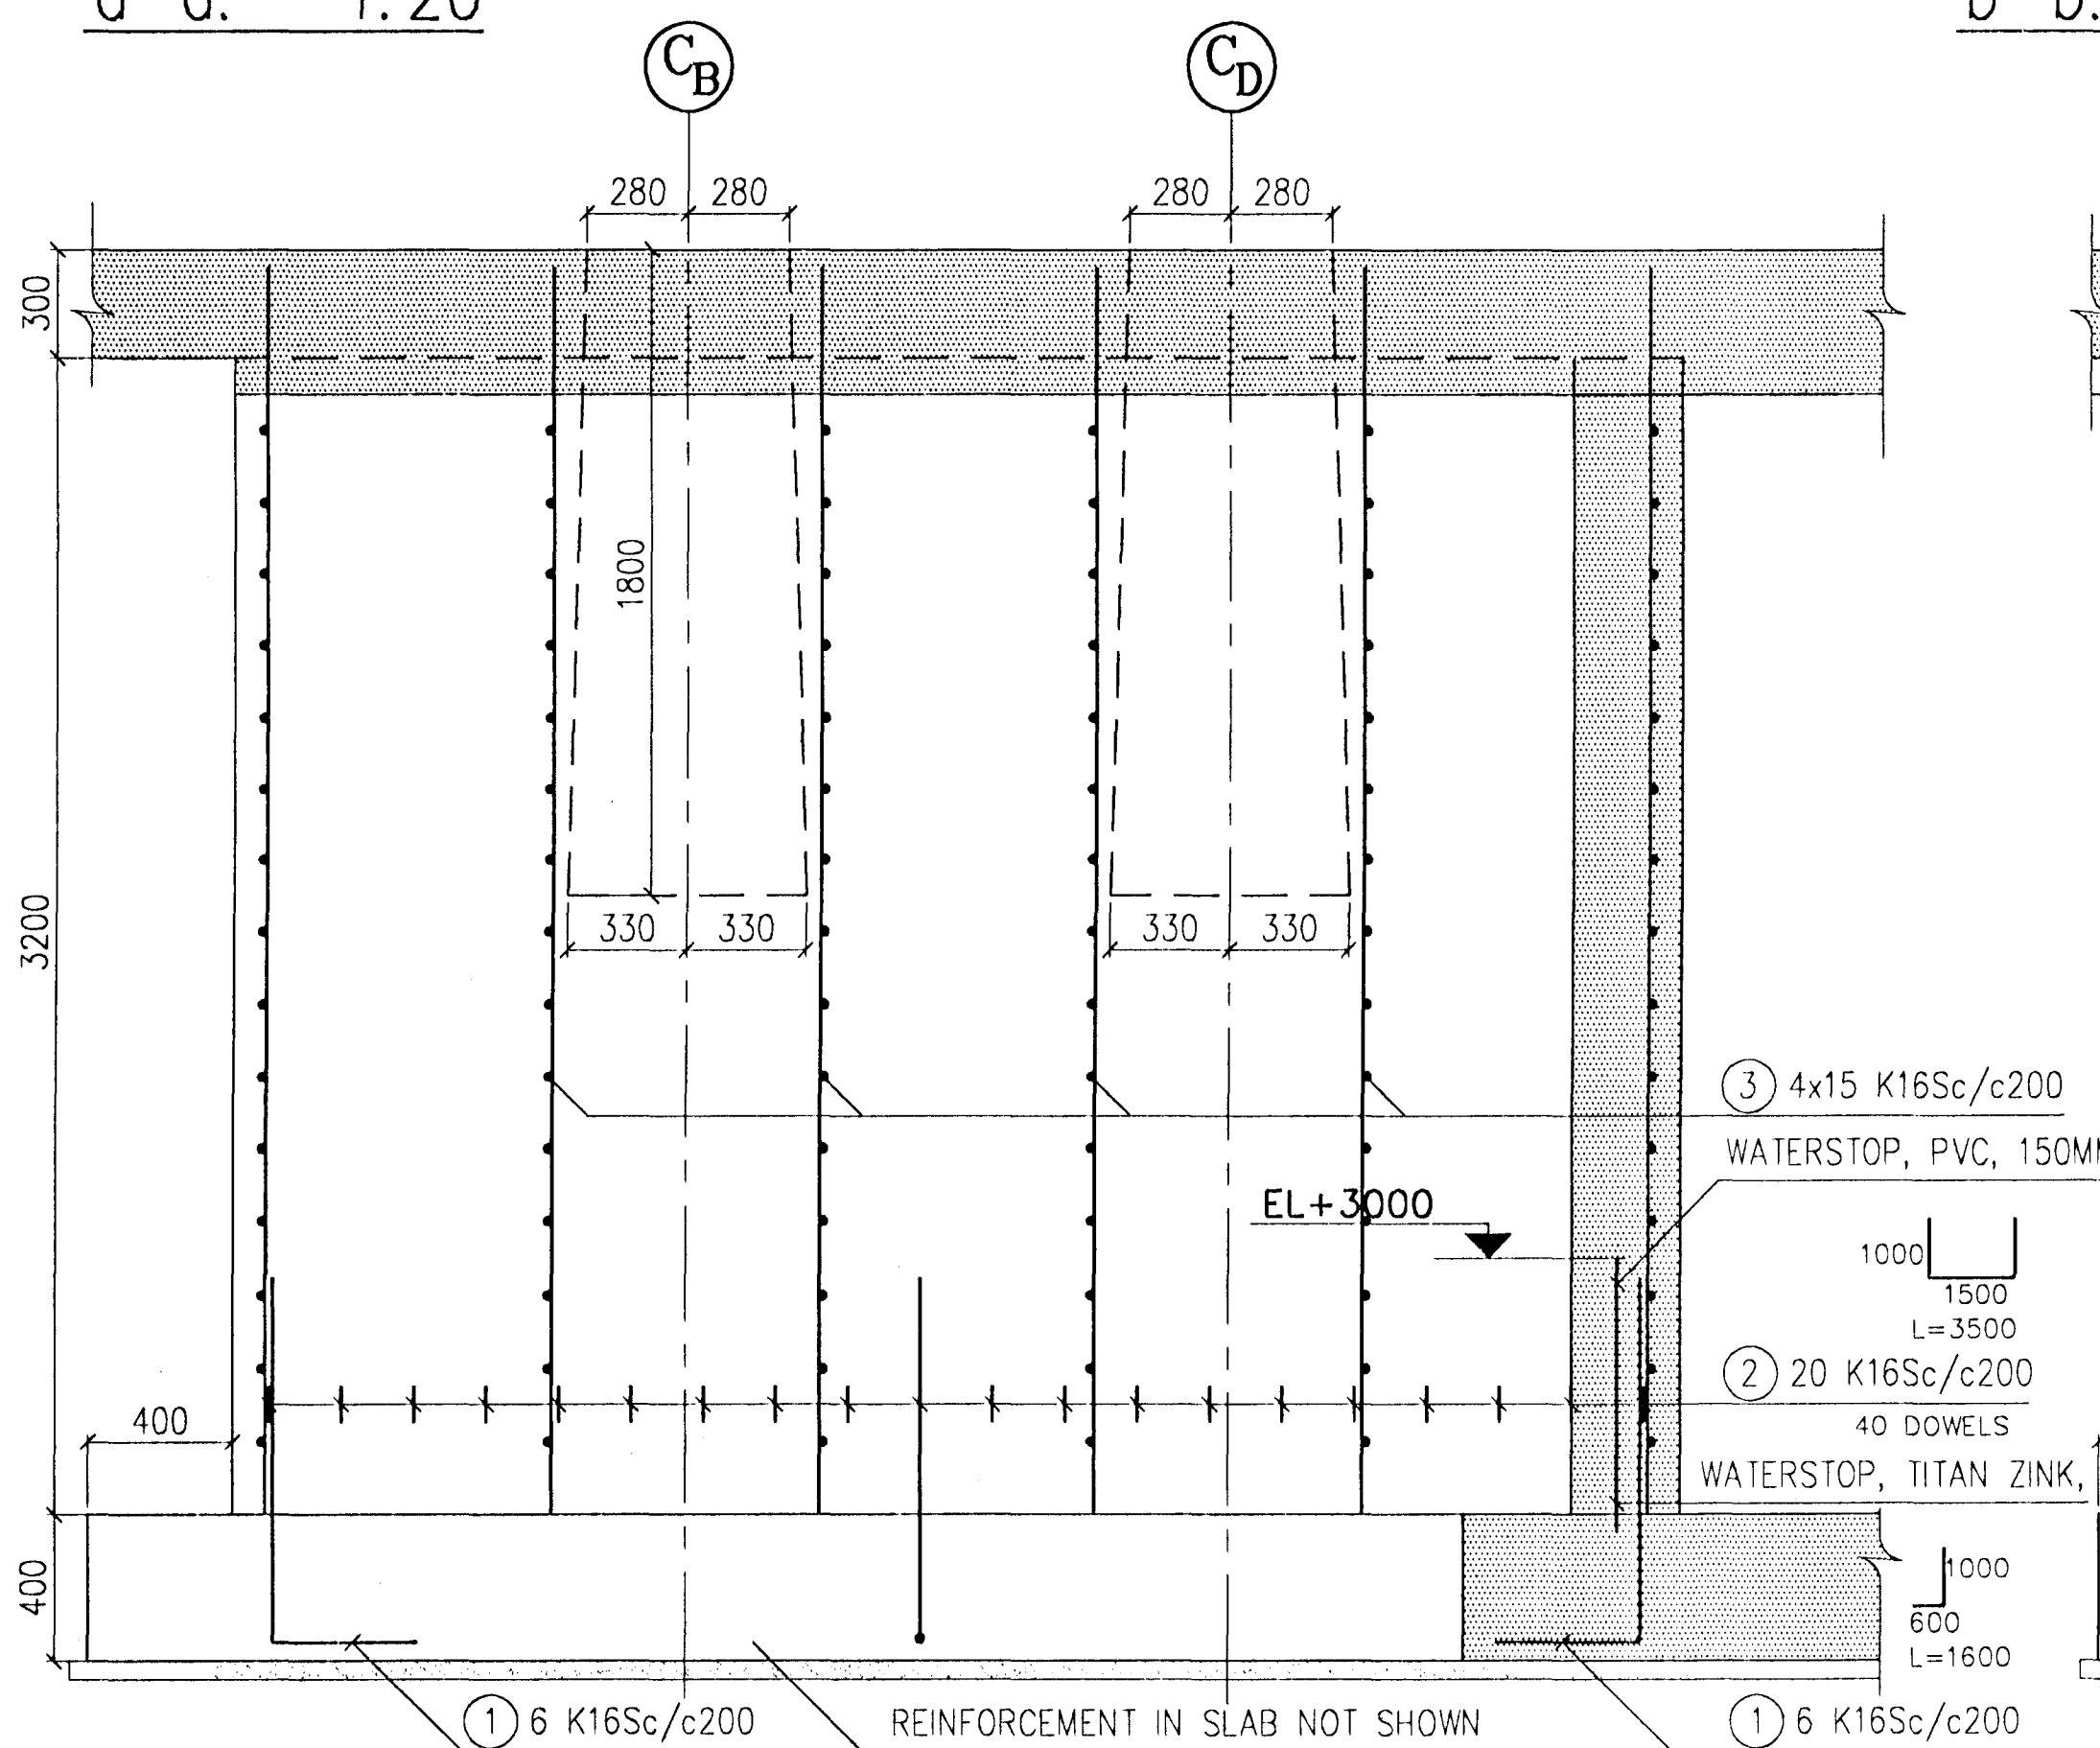

b-b. 1:20

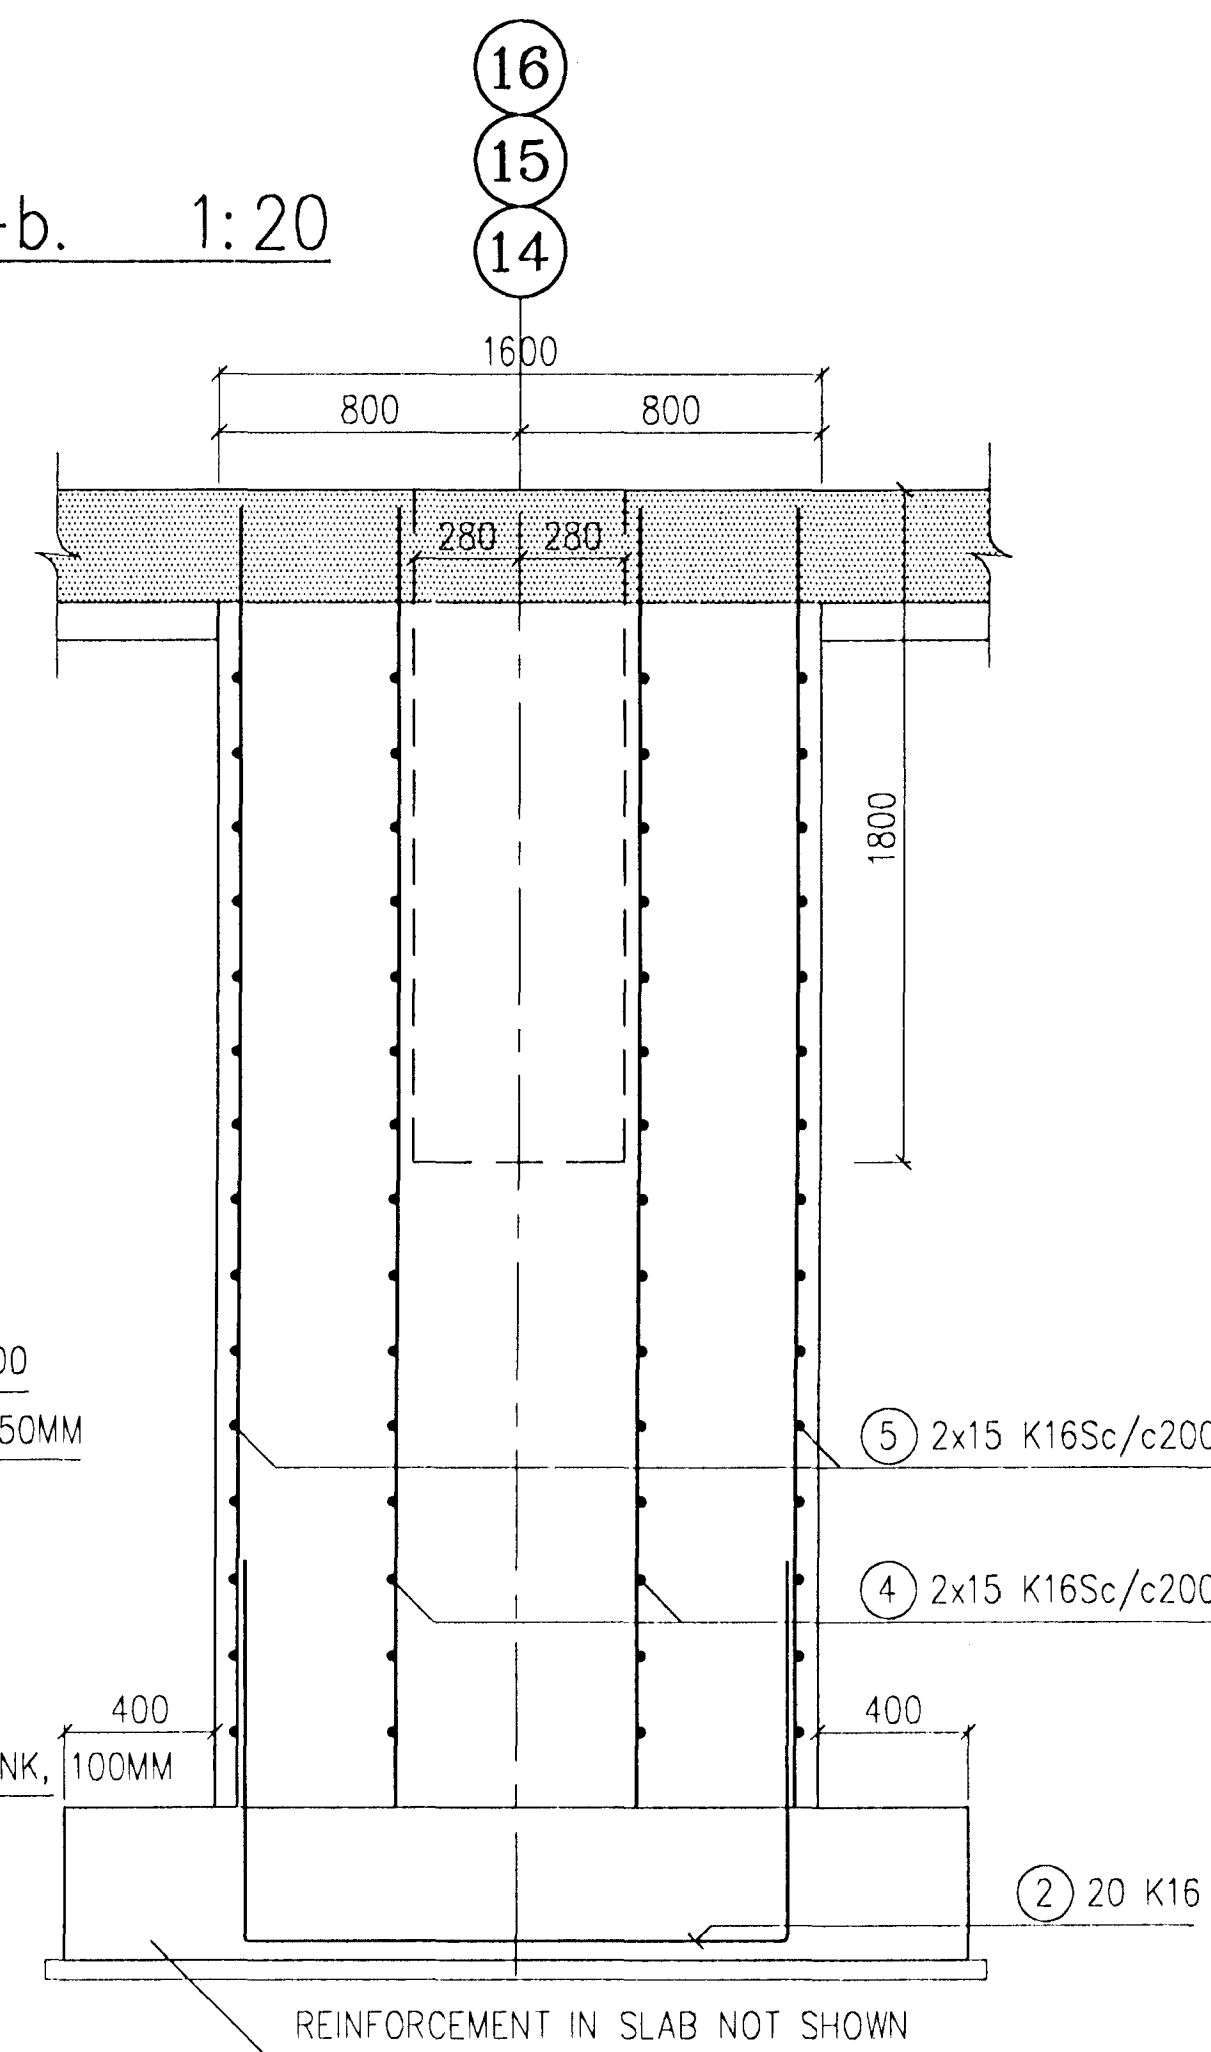


COLUMN C3. EXTRA BOTTOM BARS. SHEAR REINFORCEMENT. 1:20

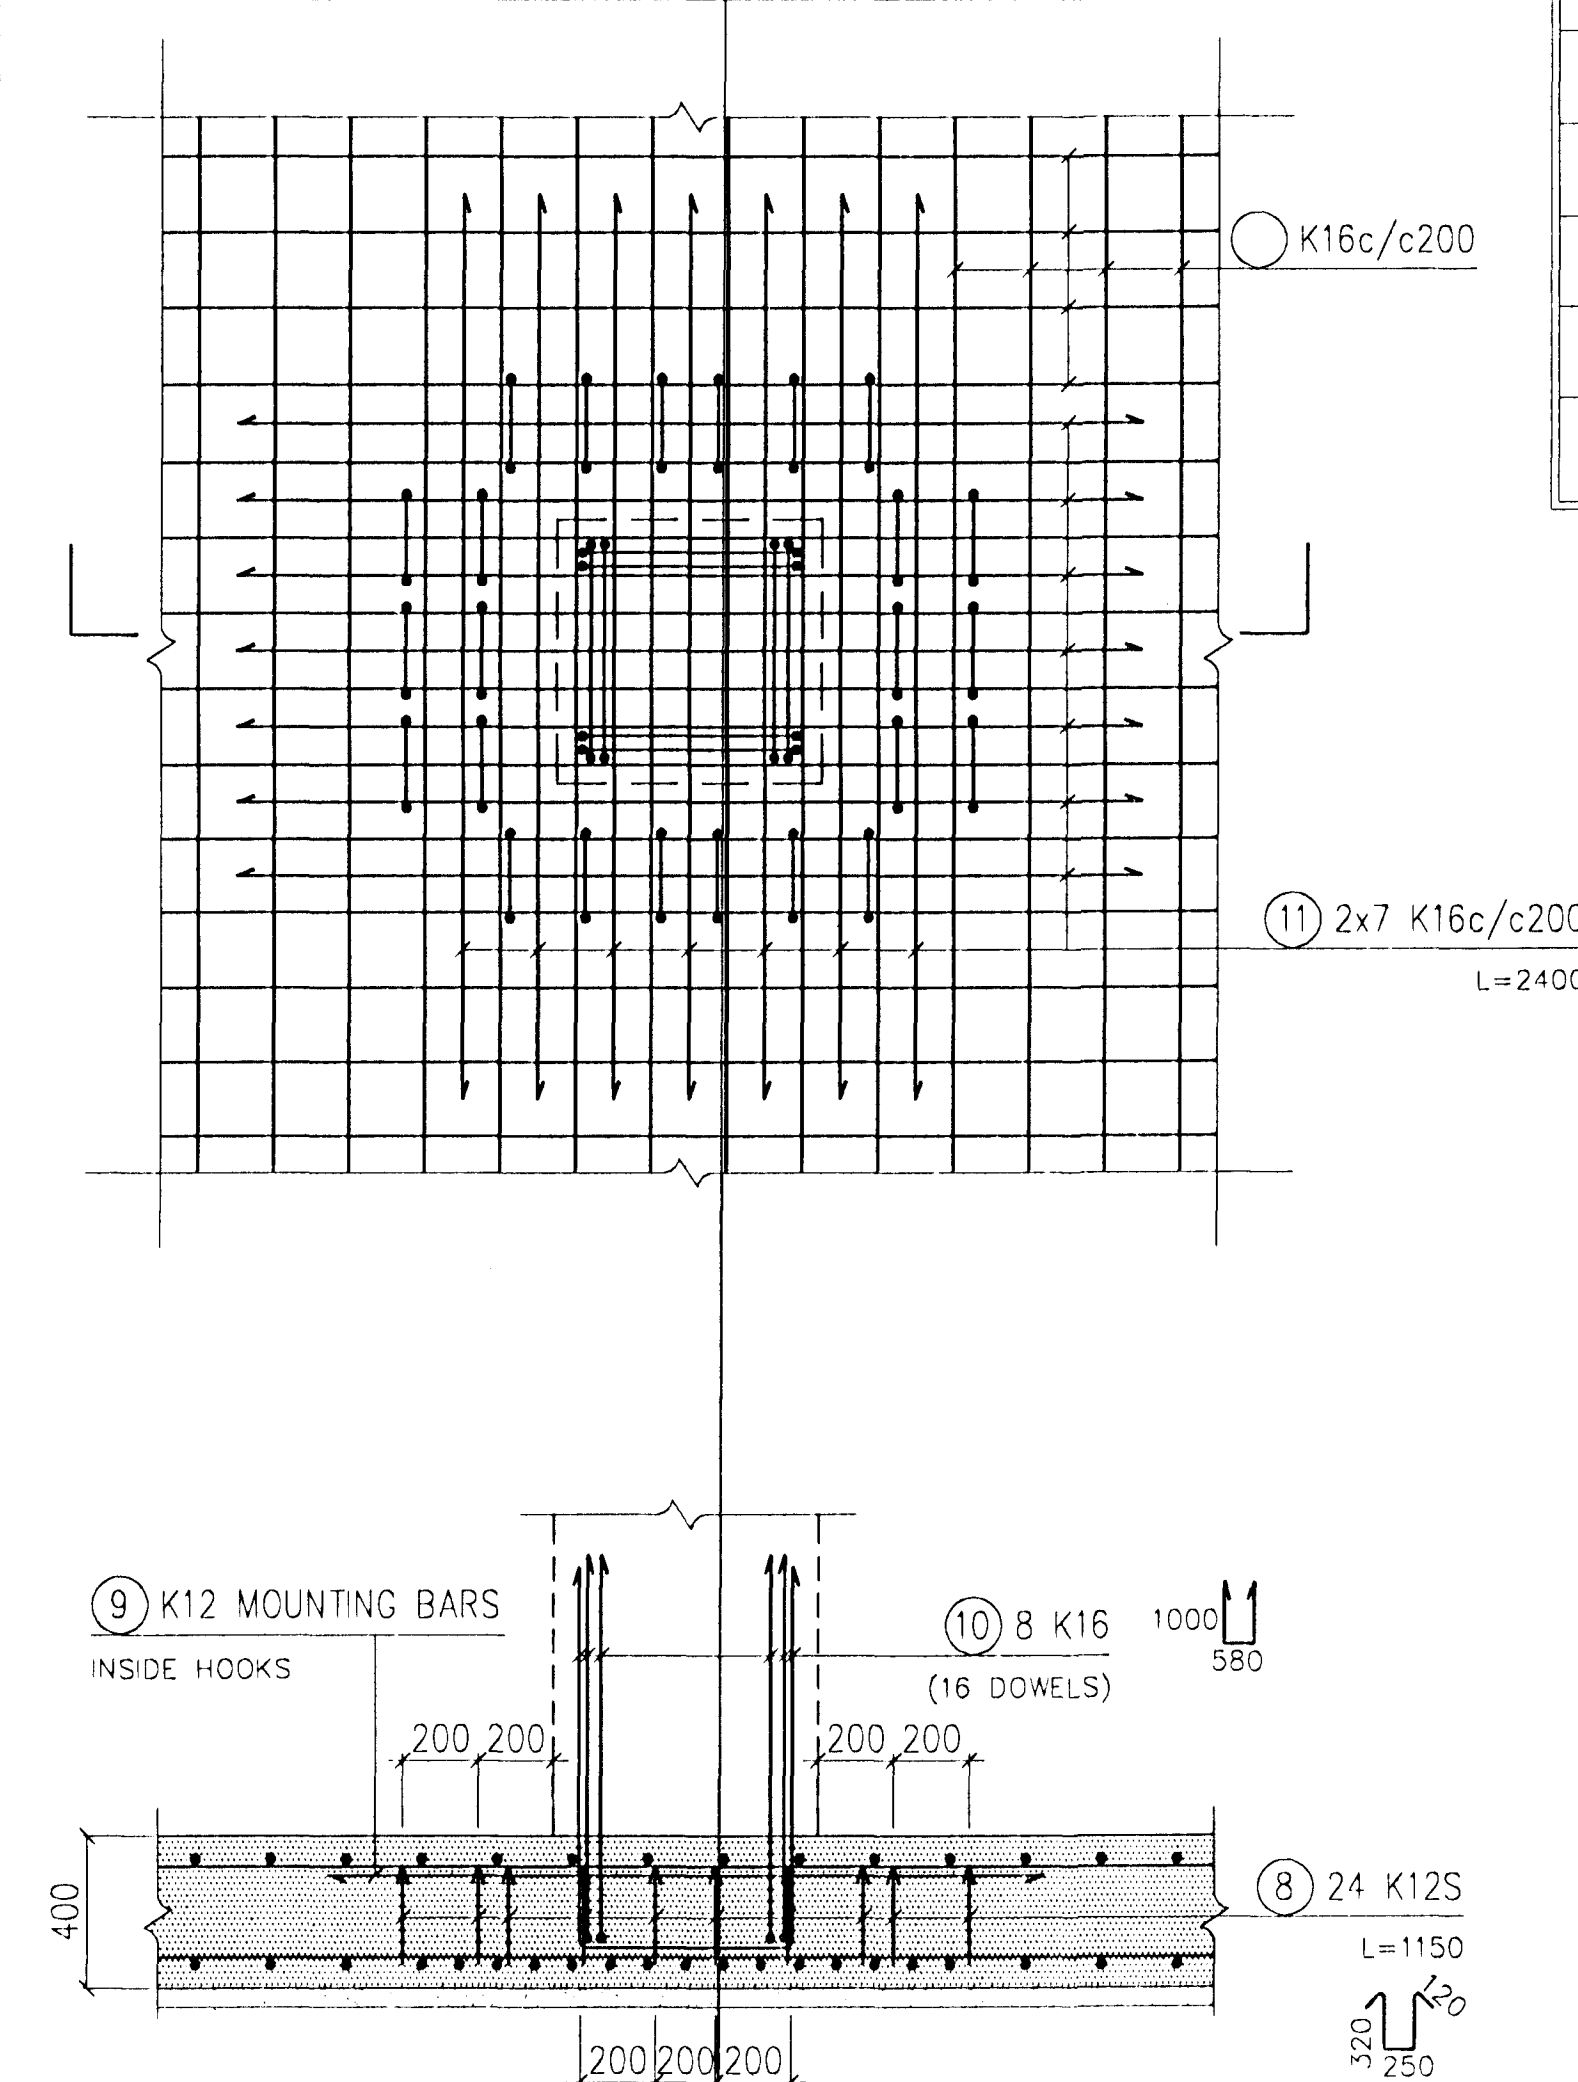

COLUMNS C1, C1\*, C3 & C6. EXTRA REINFORCEMENT IN SLAB.

COLUMN	QUANTITY	REINFORCEMENT IN SLAB
C1	4 PC.	NO EXTRA BOTTOM BARS. NO SHEAR REINFORCEMENT IN SLAB.
C1*	1 PC.	EXTRA BOTTOM BARS AS SHOWN FOR C3. NO SHEAR REINFORCEMENT IN SLAB.
C3	24 PC.	SEE DETAIL
C6	8 PC.	NO EXTRA BOTTOM BARS. NO SHEAR REINFORCEMENT IN SLAB.

C1, C1\*, C3 AND C6. 1:20

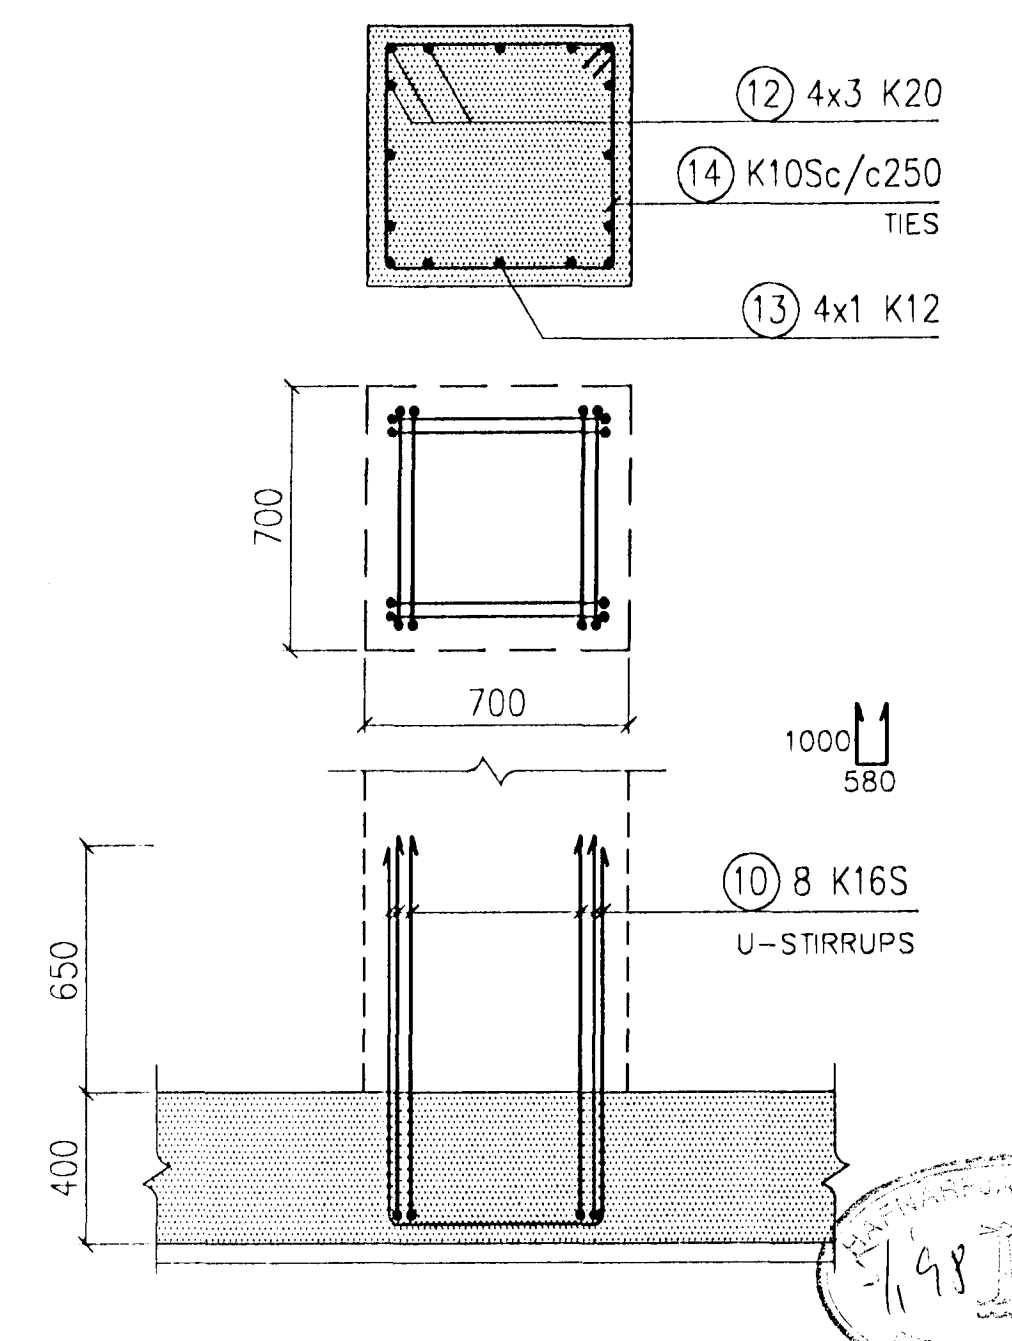

REV. NO.	DATE	REVISION	BY	APP.	REV. NO.	DATE	REVISION	BY	APP.	NOTES
2 B	14.12.1997	AS BUILD								
1	15.8.1996	ISSUED FOR CONSTRUCTION								
0	20.5.1996	ISSUED FOR TENDER								

REFERENCE DRAWING	DRAWING NUMBER

This drawing is our property and given for personal use only. It may not be copied or made available to others without our permission. The receiver is responsible for any misuse.

**ICELANDIC ALUMINIUM COMPANY LTD.**

**ALUSUISSE ALESA** **ALUSUISSE ENGINEERING LTD. ZURICH SWITZERLAND**

VERKFRÆDISTOFAN ONN SF. TÆKNITHJONUSTAN SF.

STRUCTURAL CASTHOUSE EXTENSION FOUNDATIONS IN AXES CB/CD, DC/DE AND LINES 14, 15 & 16. COLUMNS C1, C3 & C6

SCALE: 1:20

79000-34213

193.413

2

B