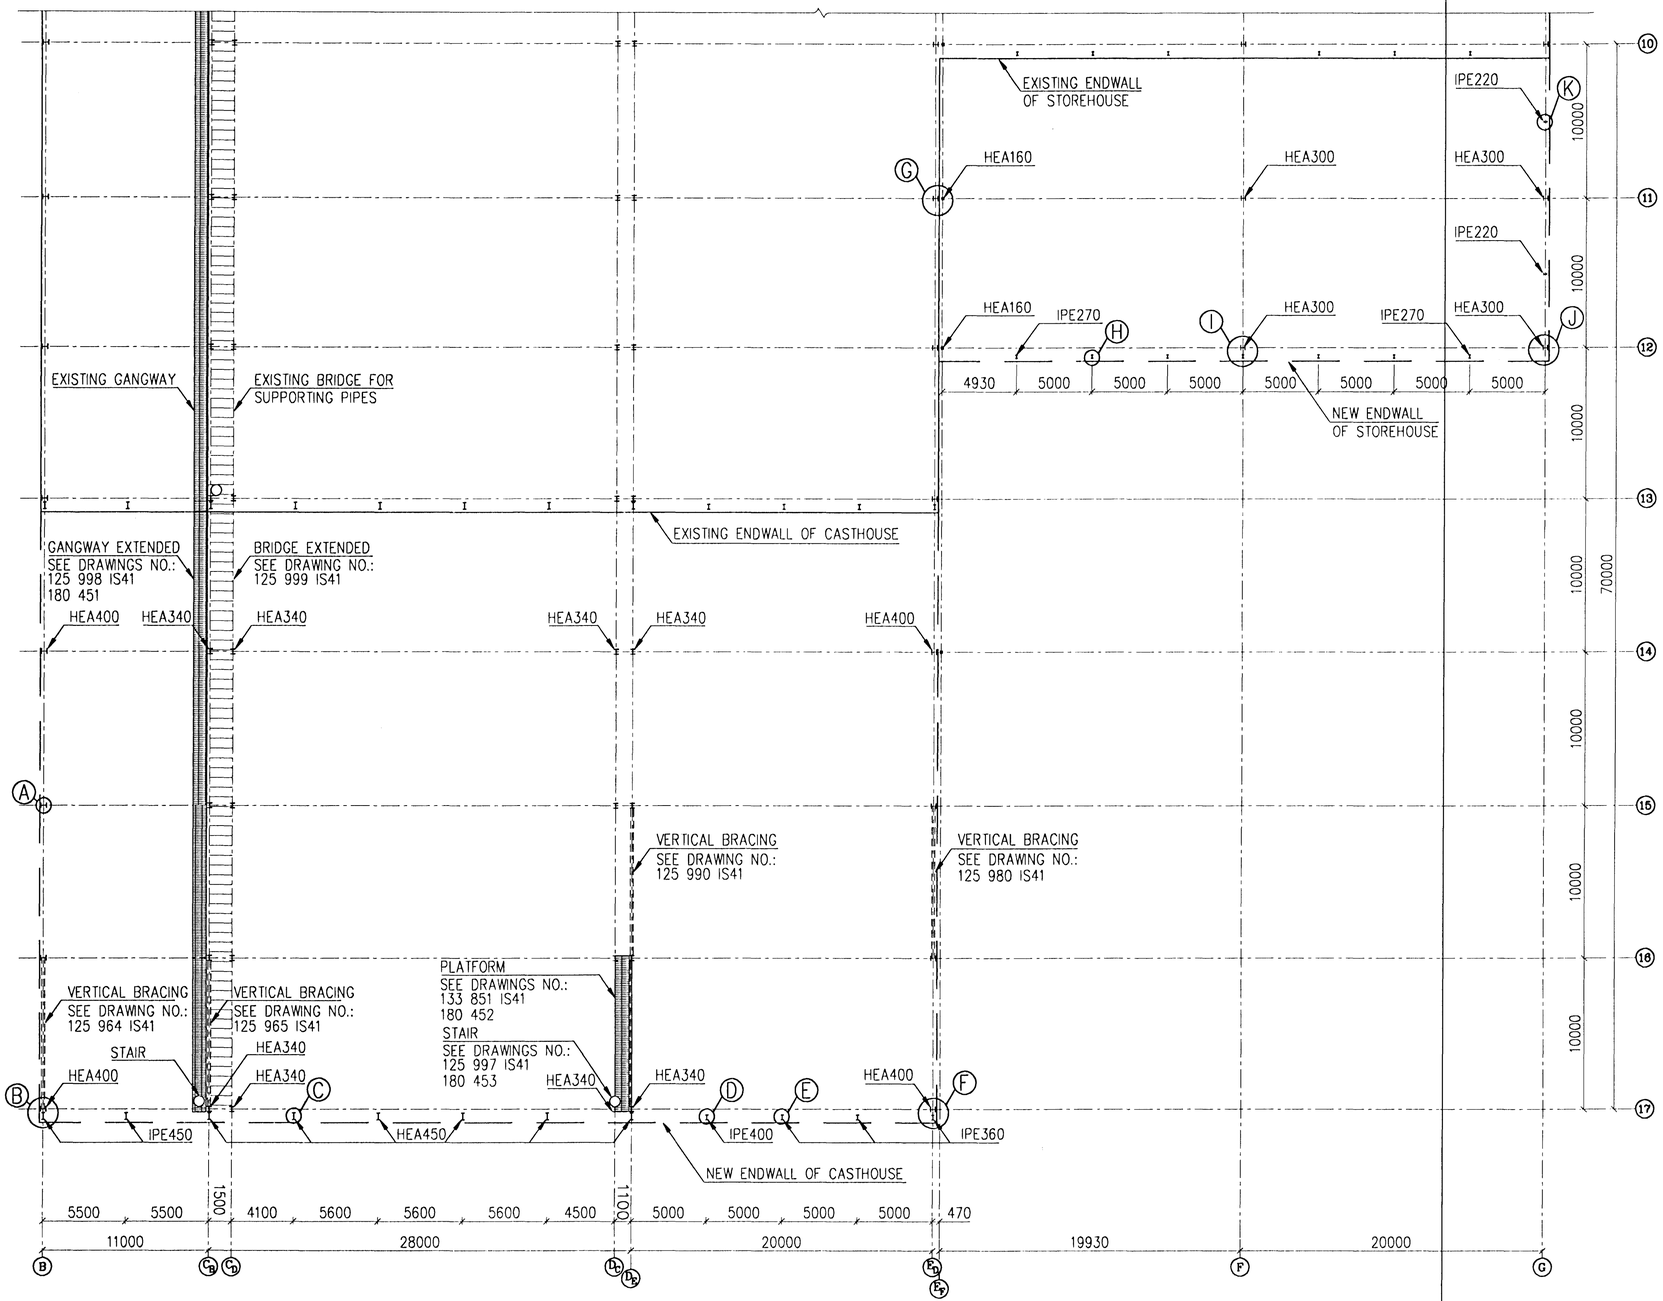

REV. NO.	DATE	REVISION	BY	APP.
1 A	5.11.1997	AS BUILD	UH	
0	20.5.1996	ISSUED FOR TENDER		

NOTES

DETAILS A TO K

REFERENCE DRAWING

193.430

DRAWING NUMBER

This drawing is our property and given for personal use only. It may not be copied or made available to others without our permission. The receiver is responsible for any misuse.

ICELANDIC ALUMINIUM COMPANY LTD.

DRAWN	28.4.1996	HHH
APPROVED	28.4.1996	UH
PROCESS		
PROJECT		
SCALE 1:200		FORMAT A1

CASTHOUSE AND STORAGE AREA EXTENSION
STRUCTURAL
PLAN OF COLUMNS.
PLAN OF GANGWAYS AND PLATFORMS.

ALUSUISSE ALESA
ALUSUISSE ENGINEERING LTD. ZURICH SWITZERLAND
VERKFRAEDISTOFAN ONN SF. TAEKNITHJONUSTAN SF.

79000-34228 REVISION 1

193.428 A