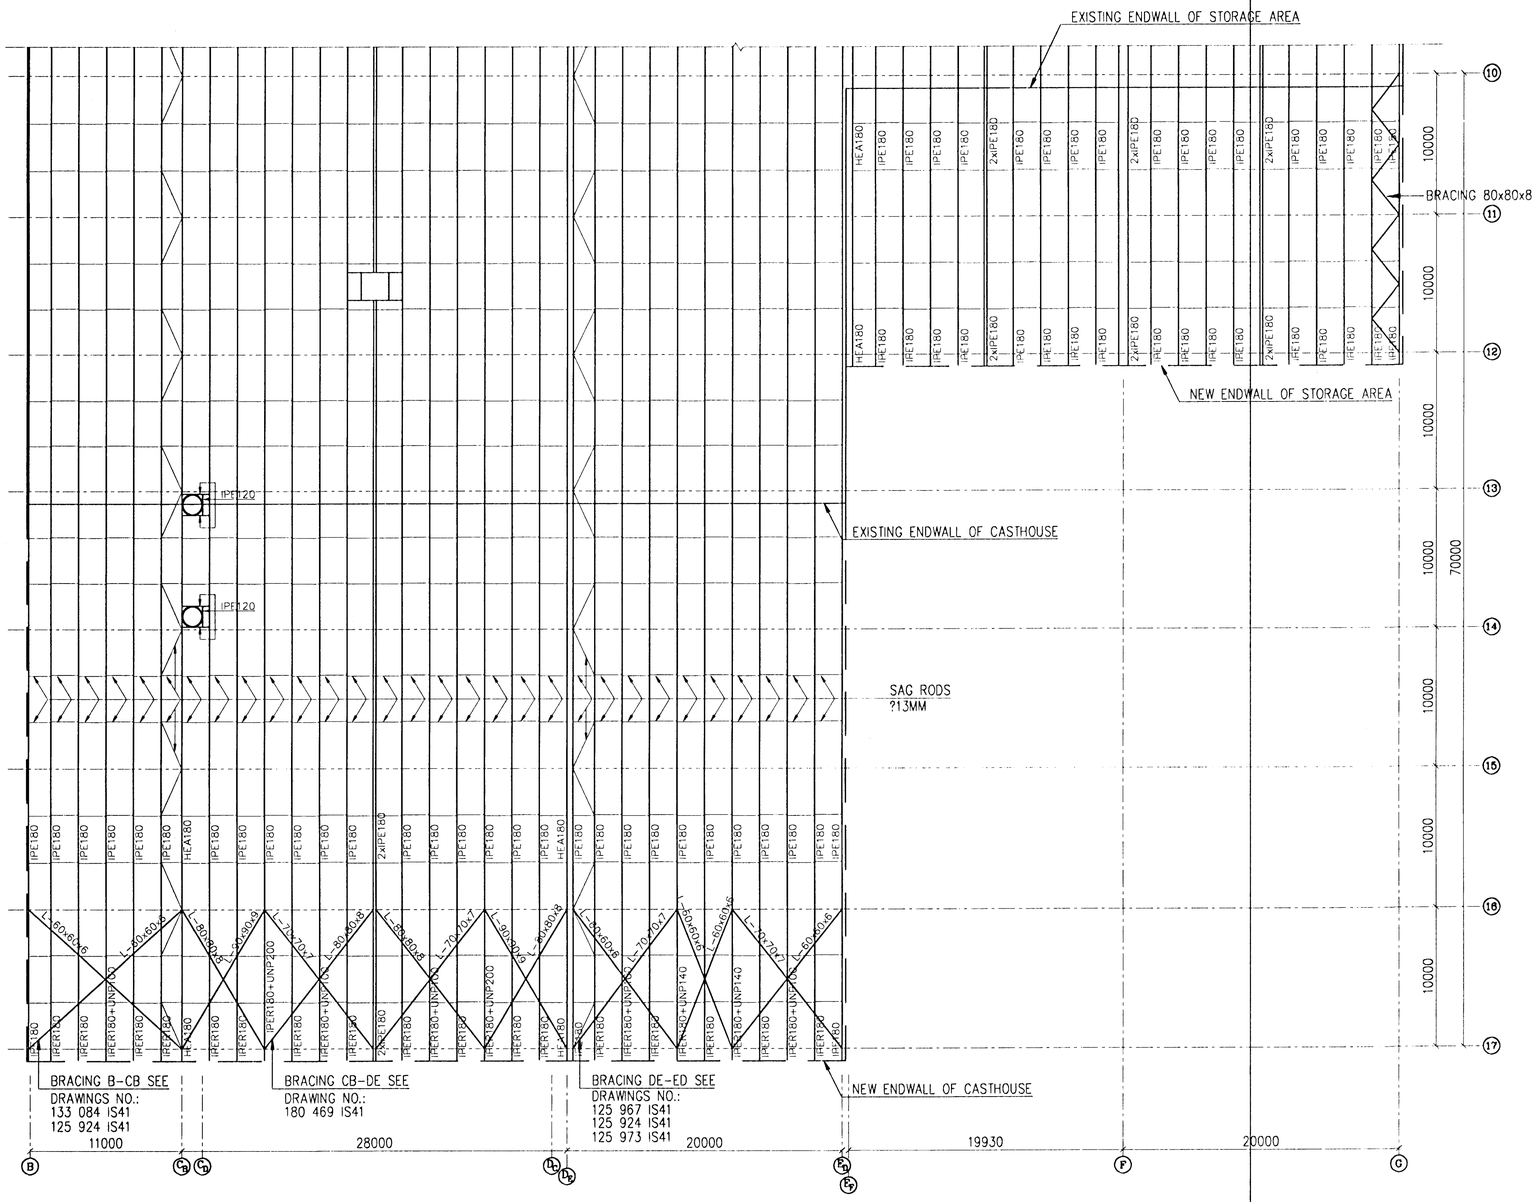

REV. NO.	DATE	REVISION	BY	APP.
1 A	10.11.1997	AS BUILD	UH	
0	20.5.1996	ISSUED FOR TENDER		

REV. NO.	DATE	REVISION	BY	APP.

NOTES

REFERENCE DRAWING

DRAWING NUMBER

This drawing is our property and given for personal use only. It may not be copied or made available to others without our permission. The receiver is responsible for any misuse.

ICELANDIC ALUMINIUM COMPANY LTD.

DRAWN	3.5.1996	HHH
APPROVED	3.5.1996	UH/JK
PROCESS		
PROJECT		
SCALE 1:200	FORMAT A1	

CASTHOUSE AND STORAGE AREA EXTENSION
STRUCTURAL
ROOF PLAN
PURLINS, BRACING AND SAG RODS.

ALUSUISSE ALESA — ALESA ALUSUISSE ENGINEERING LTD. ZURICH SWITZERLAND

79000-34229 — REVISION 1

VERKFRAEDISTOFAN ONN SF.
TAEKNITHJONUSTAN SF.

193.429 — A1