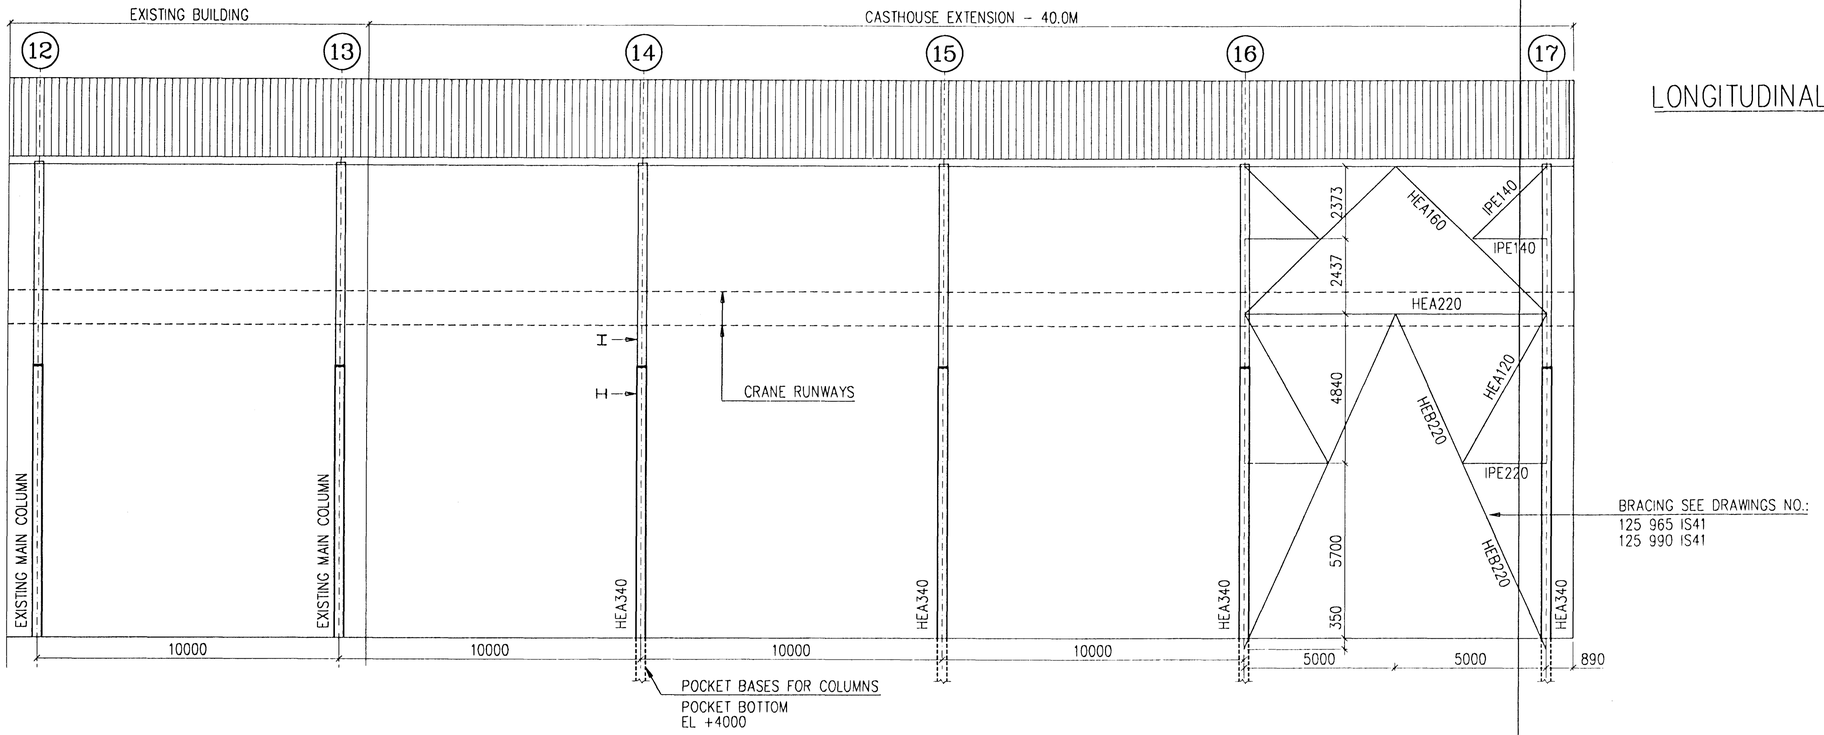

LONGITUDINAL ELEVATION AXIS (CB) 1:100

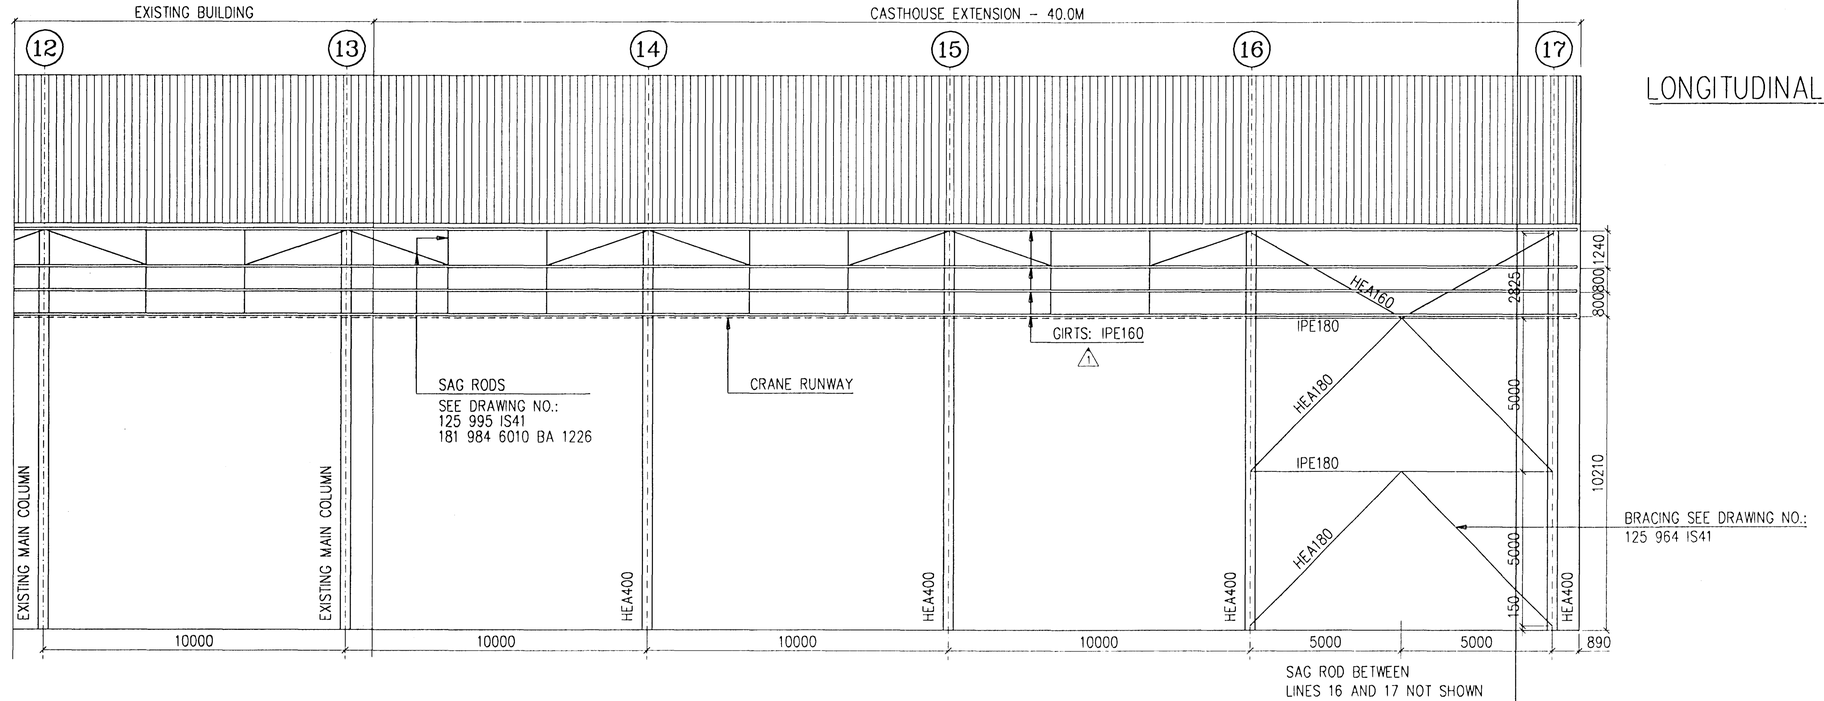

LONGITUDINAL ELEVATION AXIS (B) 1:100

REV. NO.	DATE	REVISION	BY	APP.
2 B	14.12.1997	AS BUILD	UH	
1	11.6.1996	GIRTS ADJUSTED TO OLDER BUILDING	HHH	UH
0	20.5.1996	ISSUED FOR TENDER		

REV. NO.	DATE	REVISION	BY	APP.

NOTES

REFERENCE DRAWING

DRAWING NUMBER

This drawing is our property and given for personal use only. It may not be copied or made available to others without our permission. The receiver is responsible for any misuse.

ICELANDIC ALUMINIUM COMPANY LTD.

DRAWN	3.5.1996	HHH
APPROVED	3.5.1996	UH
PROCESS		
PROJECT		
SCALE	1:100	FORMAT A1

CASTHOUSE EXTENSION
STRUCTURAL
LONGITUDINAL ELEVATION
AXES B AND CB

ALUSUISSE ALESA — ALESA ALUSUISSE ENGINEERING LTD. ZURICH SWITZERLAND

VERKFRAEDISTOFAN ONN SF.
TAEKNITHJONUSTAN SF.

79000-34233 REVISION 2

193.433 B