CRANE RUNWAY IN AXIS (C_B) 1:50

CRANE RUNWAY IN AXIS B IS A MIRROR IMAGE OF THIS ONE.

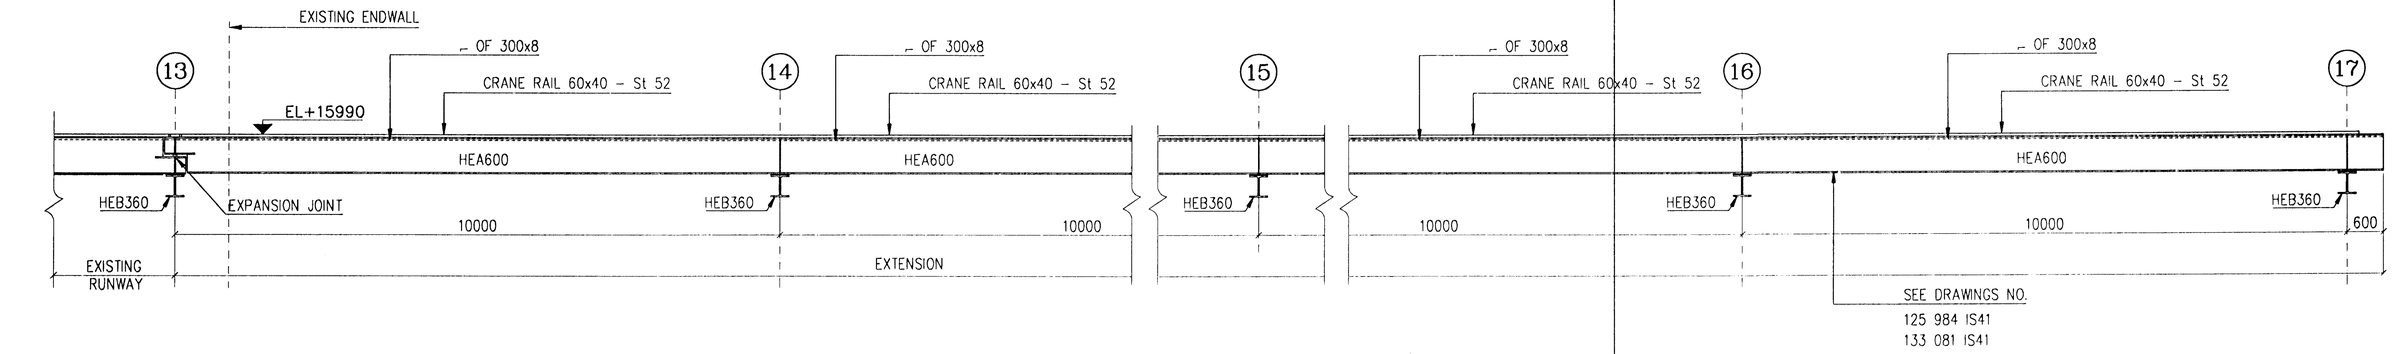

CRANE RUNWAY IN AXIS (D_C) 1:50

CRANE RUNWAY IN AXIS CD IS A MIRROR IMAGE OF THIS ONE.

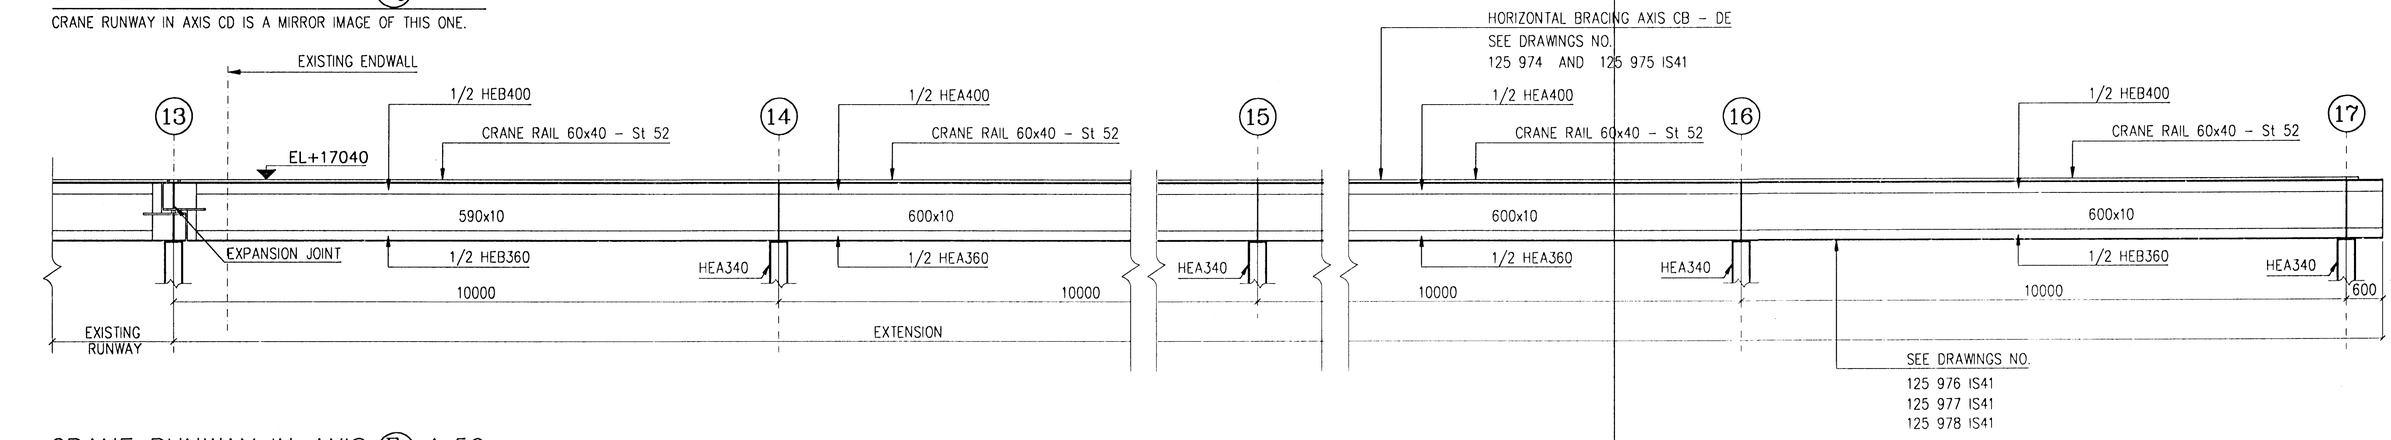

CRANE RUNWAY IN AXIS (E_D) 1:50

CRANE RUNWAY IN AXIS DE IS A MIRROR IMAGE OF THIS ONE.

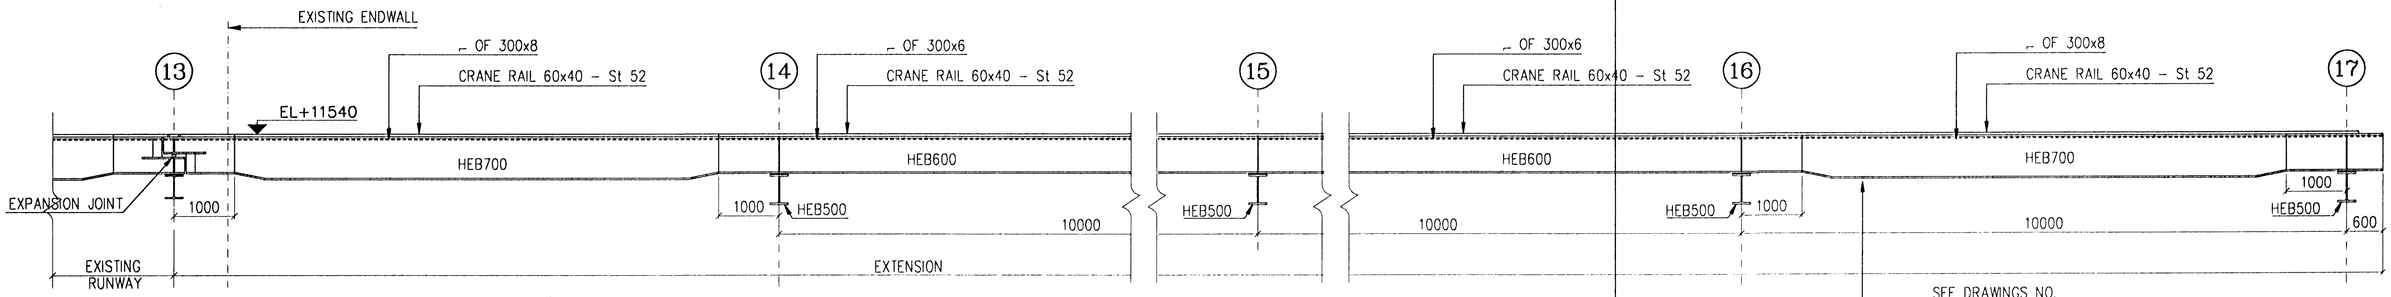

REV. NO.	DATE	REVISION	BY	APP.
1 A	14.12.1997	AS BUILD	UH	
0	20.5.1996	ISSUED FOR TENDER		

REV. NO.	DATE	REVISION	BY	APP.

NOTES

EXPANSION JOINTS — REFERENCE DRAWING

193.436 — DRAWING NUMBER

This drawing is our property and given for personal use only. It may not be copied or made available to others without our permission. The receiver is responsible for any misuse.

ICELANDIC ALUMINIUM COMPANY LTD.

DRAWN	3.5.1996	HHH
APPROVED	3.5.1996	UH
PROCESS		
PROJECT		
SCALE 1:50	FORMAT A1	

CASTHOUSE EXTENSION
STRUCTURAL
CRANE RUNWAYS BETWEEN LINES 13 AND 17

ALUSUISSE ALESA — ALUSUISSE ENGINEERING LTD. ZURICH SWITZERLAND

VERKFRAEDISTOFAN ONN SF.
TAEKNITHJONUSTAN SF.

79000-34234 — REVISION 1

193.434 — A