SECTION X–X. 1:20
FRESH–AIR INTAKE. STEEL FRAME.

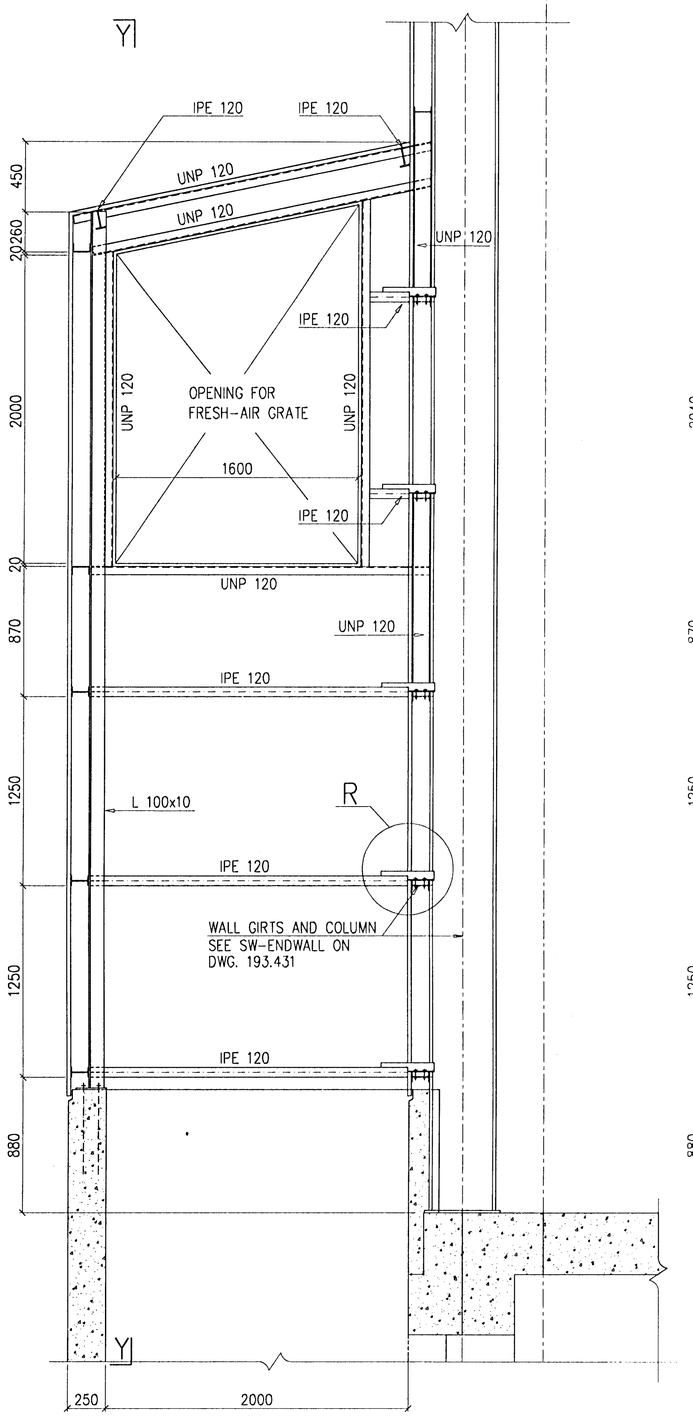

SECTION Y–Y. 1:20

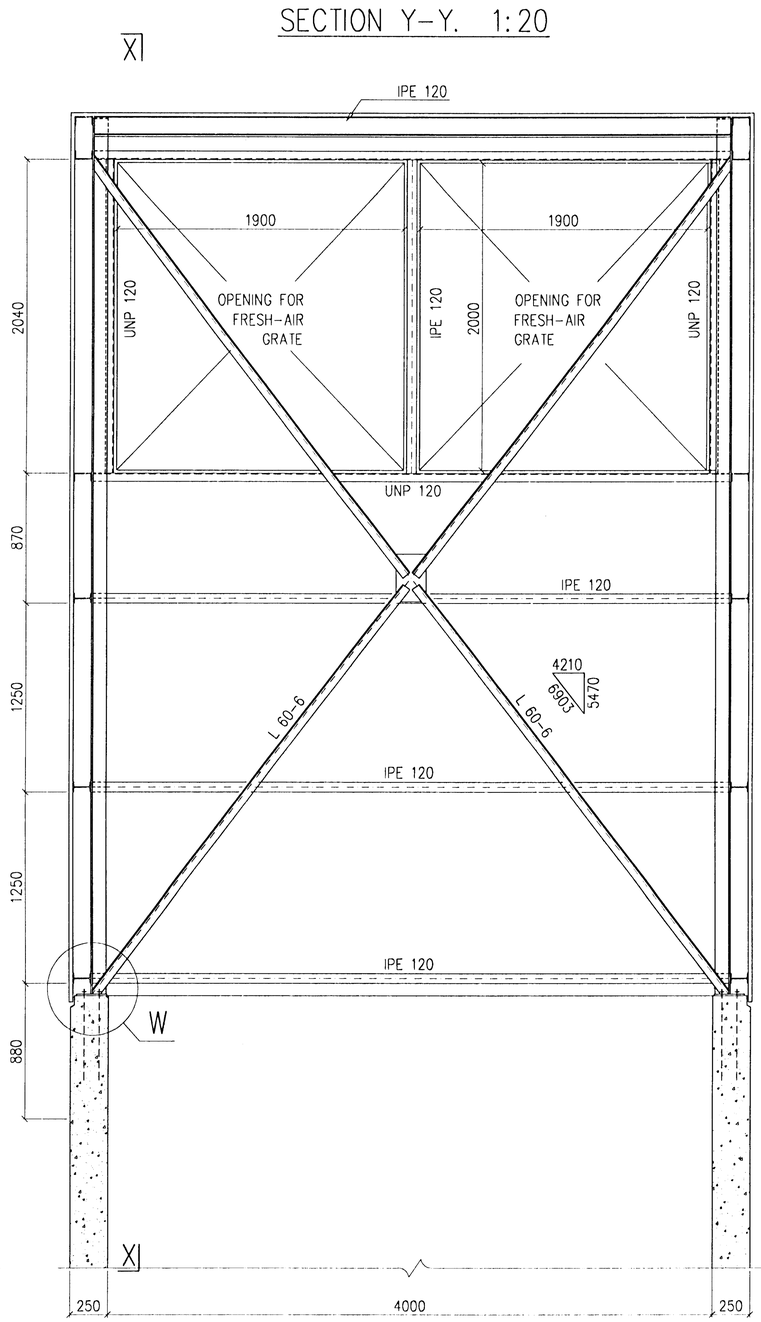

Z. 1:10

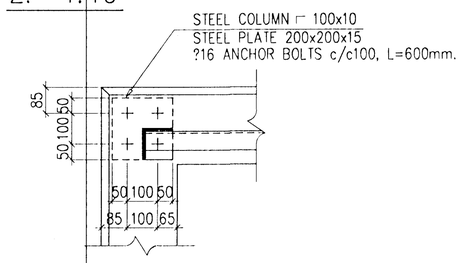

W. 1:10

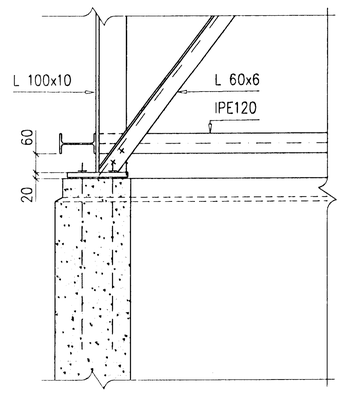

R. 1:10

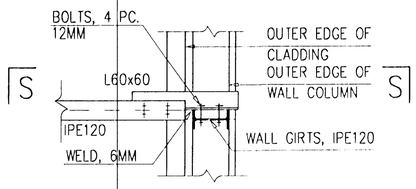

SECTION S–S. 1:10

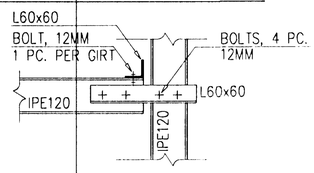

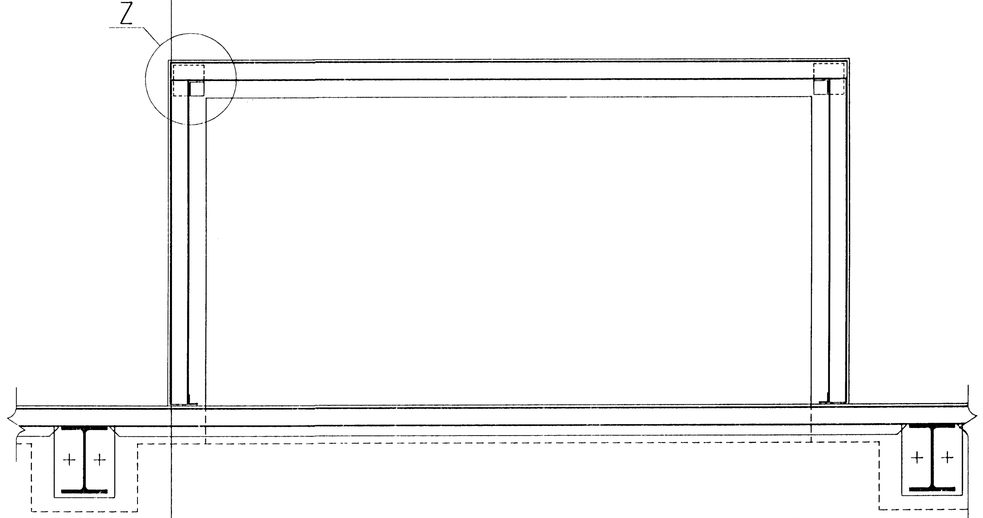

REV. NO.	DATE	REVISION	BY	APP.
1 A	15.11.1997	AS BUILD	UH	
0	19.9.1996	ISSUED FOR APPROVAL	UH	

REV. NO.	DATE	REVISION	BY	APP.

NOTES

REFERENCE DRAWING

DRAWING NUMBER

This drawing is our property and given for personal use only. It may not be copied or made available to others without our permission. The receiver is responsible for any misuse.

ICELANDIC ALUMINIUM COMPANY LTD.

DRAWN	9.9.1996	HHH
APPROVED	9.9.1996	UH
PROCESS		
PROJECT		
SCALE 1:20	FORMAT A1	

CASTHOUSE EXTENSION
STRUCTURAL
FRESH–AIR INTAKE STEEL FRAME
ELEVATIONS

ALUSUISSE ALESA
ALESA
ALUSUISSE ENGINEERING LTD.
ZURICH SWITZERLAND

VERKFRAEDISTOFAN ONN SF.
TAEKNITHJONUSTAN SF.

79000–34237

193.437

REVISION 1

A