4. 1:20

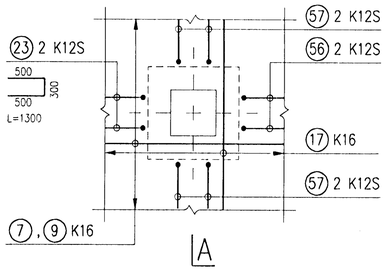

A–A. 1:20

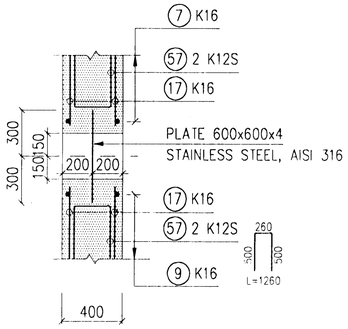

5. 1:2

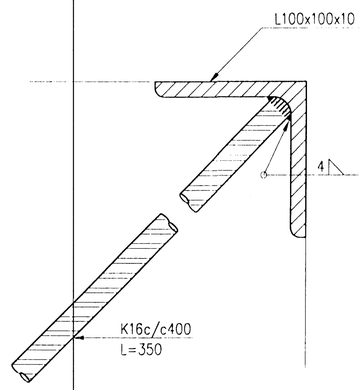

6. 1:2

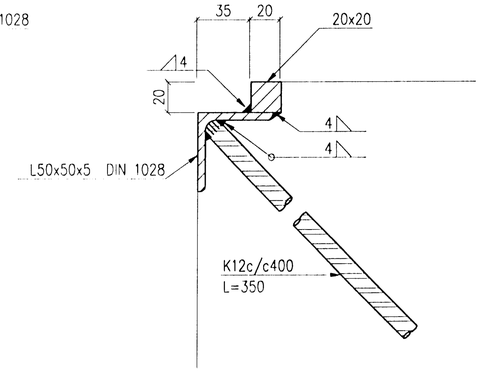

t–t. 1:50

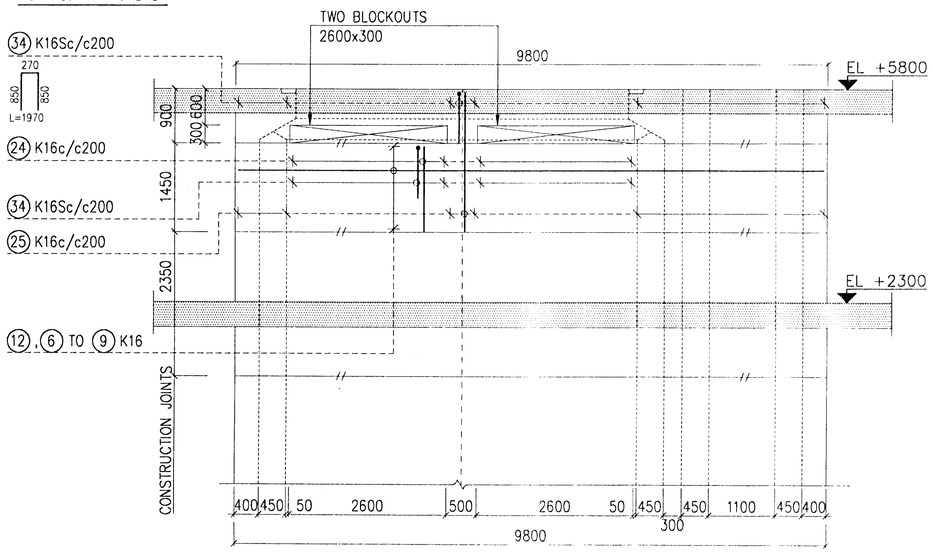

7. 1:2

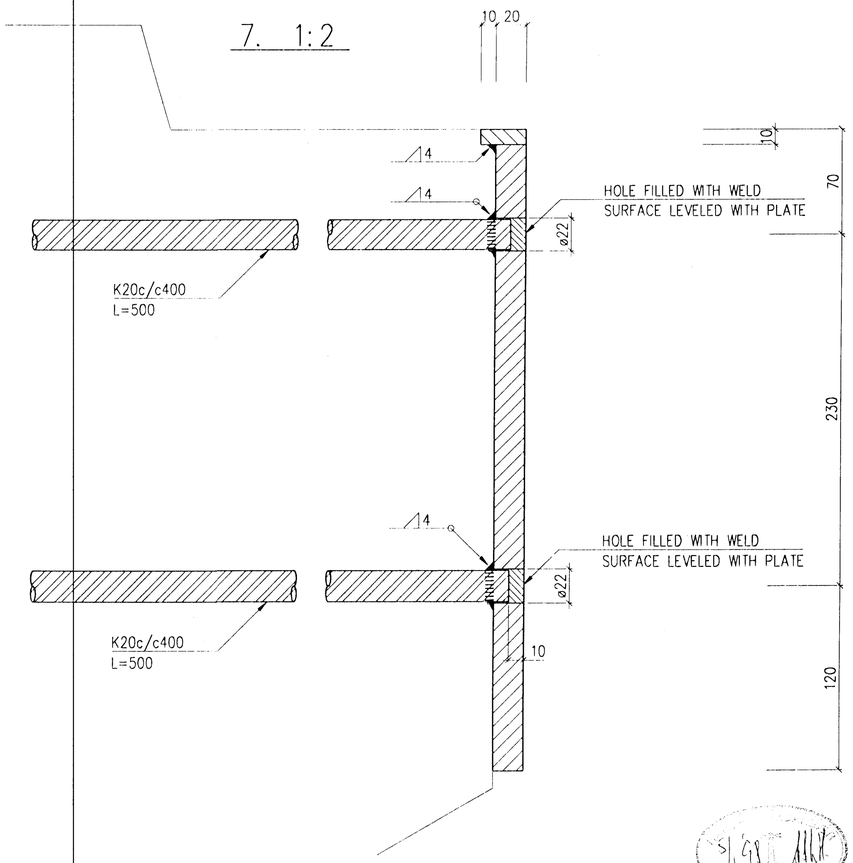

REV. NO.	DATE	REVISION	BY	APP.
2 B	14.12.1997	AS BUILD	UH	
1	15.8.1996	ISSUED FOR CONSTRUCTION	UH	
0	20.5.1996	ISSUED FOR TENDER		

REV. NO.	DATE	REVISION	BY	APP.

NOTES

REFERENCE DRAWING	DRAWING NUMBER
DETAILS 5, 6 AND 7 TAKEN FROM	193.443
SECTION t AND DETAIL 1 TAKEN FROM	193.442
MAIN DIMENSIONS	193.441

This drawing is our property and given for personal use only it may not be copied or made available to others without our permission. The receiver is responsible for any misuse.

ICELANDIC ALUMINIUM COMPANY LTD.

DRAWN	16.5.1996	HHH
APPROVED	16.5.1996	UH
PROCESS		
PROJECT		
SCALE 1:2		FORMAT A1

ALUSUISSE ALESA — ALESA ALUSUISSE ENGINEERING LTD. ZURICH SWITZERLAND

VERKFRAEDISTOFAN ONN SF.
TAEKNITHJONUSTAN SF.

CASTHOUSE EXTENSION
STRUCTURAL
CASTING MACHINE PIT
SECTION t. DETAILS 4, 5, 6 AND 7.

79000-34245 — REVISION 2

193.445 — B