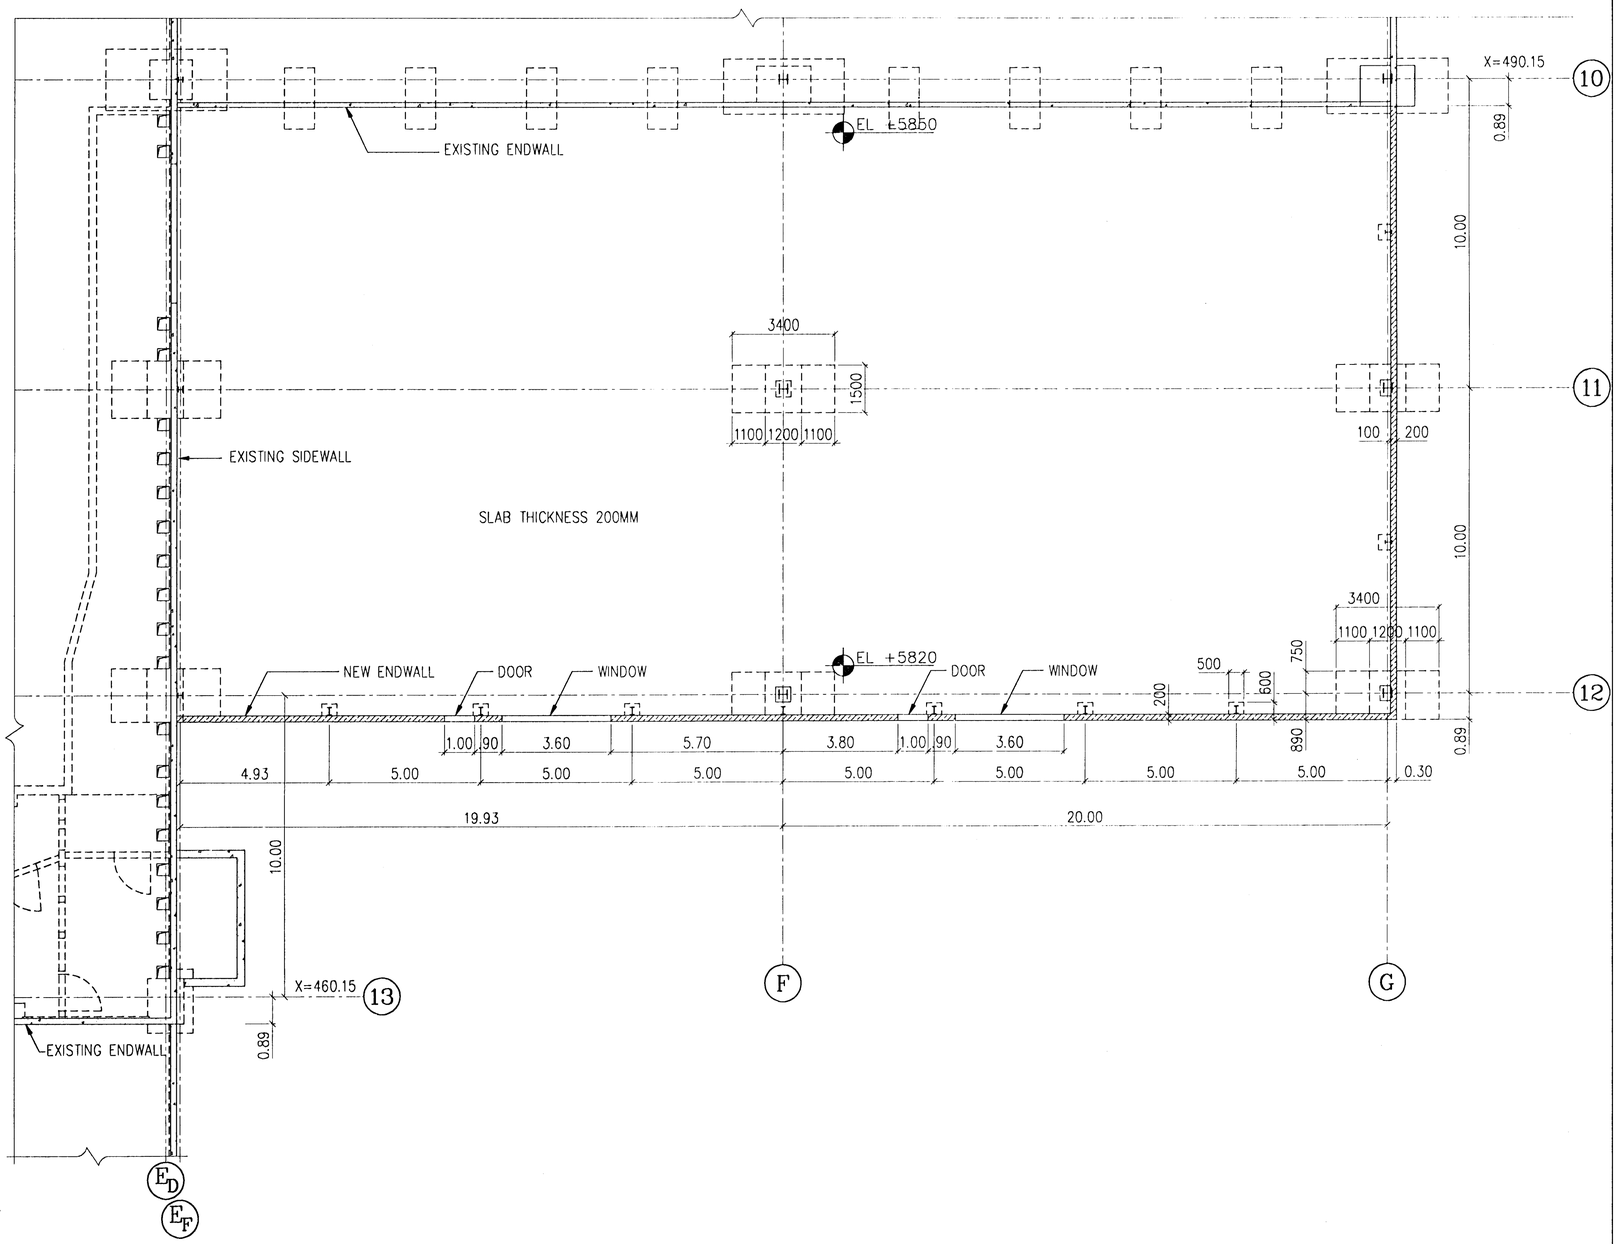

REV. NO.	DATE	REVISION	BY	APP.	REV. NO.	DATE	REVISION	BY	APP.	NOTES	REFERENCE DRAWING	DRAWING NUMBER
2 B	3.11.1997	AS BUILD	UH									
1	15.8.1996	ISSUED FOR CONSTRUCTION	UH									
0	20.5.1996	ISSUED FOR TENDER										

This drawing is our property and given for personal use only. It may not be copied or made available to others without our permission. The receiver is responsible for any misuse.

ICELANDIC ALUMINIUM COMPANY LTD.

DRAWN	5.5.1996	HHH
APPROVED	5.5.1996	UH
PROCESS		
PROJECT		
SCALE	1:100	FORMAT A1

CASTHOUSE EXTENSION - STORAGE AREA
STRUCTURAL
GROUND FLOOR
E-G / 10-12

ALUSUISSE ALESA
ALUSUISSE ENGINEERING LTD.
ZURICH SWITZERLAND

79000-34251 REVISION 2

VERKFRAEDISTOFAN ONN SF.
TAEKNITHJONUSTAN SF.

193.451 B