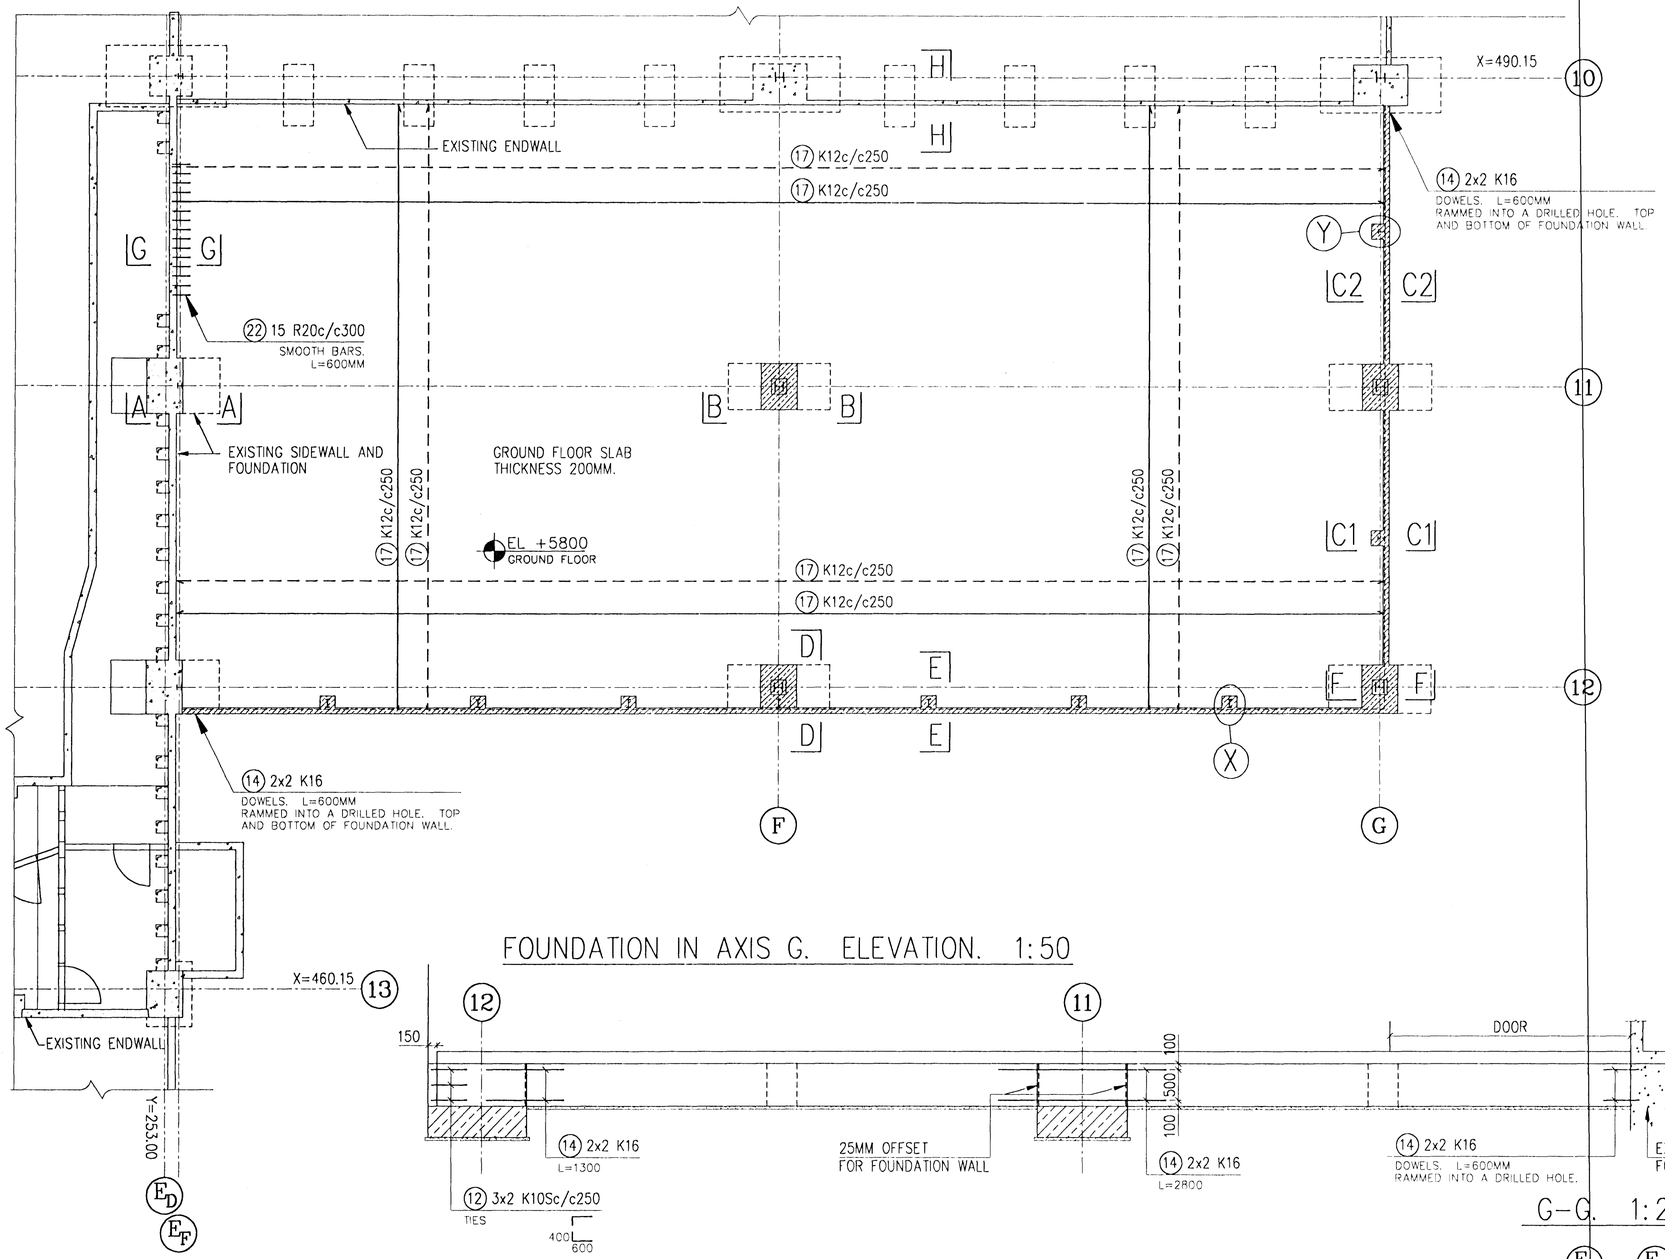

FOUNDATION IN AXIS G. ELEVATION. 1:50

C2–C2. 1:20

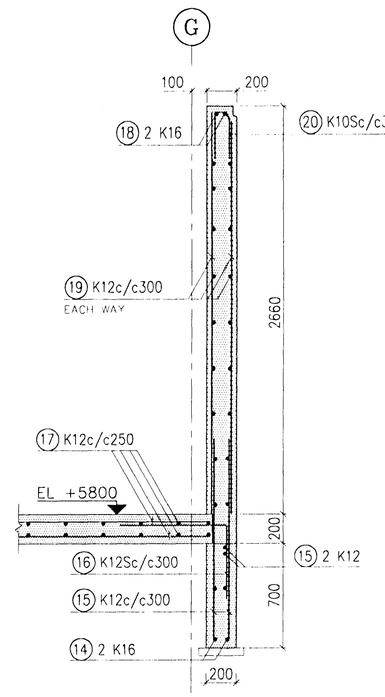

C1–C1. 1:20

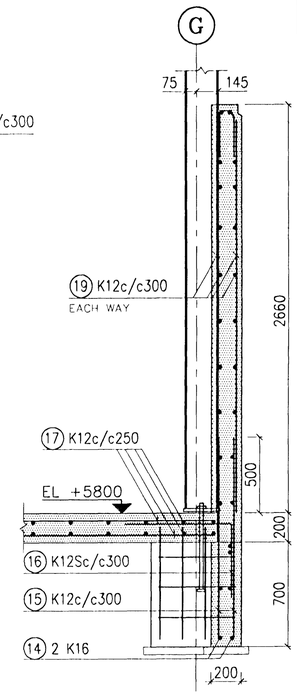

H – H. 1:20

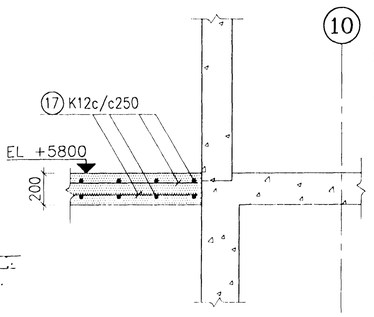

Y. 1:20

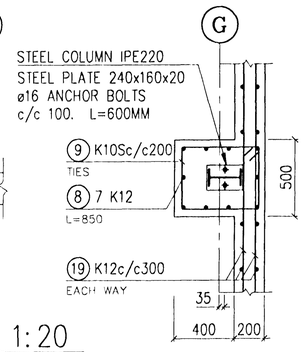

A–A. 1:20

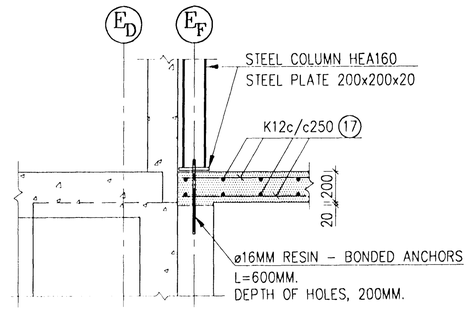

G–G. 1:20

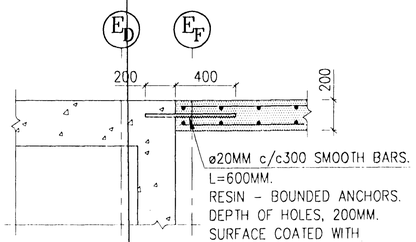

REV. NO.	DATE	REVISION	BY	APP.
2 B	14.12.1997	AS BUILD	UH	
1	15.8.1996	ISSUED FOR CONSTRUCTION	UH	
0	20.5.1996	ISSUED FOR TENDER		

REV. NO.	DATE	REVISION	BY	APP.

NOTES

REFERENCE DRAWING	DRAWING NUMBER
DETAIL X	193.453
SECTIONS B, D, E AND F	193.453

This drawing is our property and given for personal use only. It may not be copied or made available to others without our permission. The receiver is responsible for any misuse.

ICELANDIC ALUMINIUM COMPANY LTD.

DRAWN	4.5.1996	HHH
APPROVED	4.5.1996	UH
PROCESS		
PROJECT		
SCALE 1:100	FORMAT A1	

CASTHOUSE EXTENSION – STORAGE AREA
STRUCTURAL
GROUND FLOOR REINFORCEMENT
E-G / 10-12, FOUNDATIONS

ALUSUISSE ALESA
ALUSUISSE ALESA ENGINEERING LTD. ZURICH SWITZERLAND
VERKFRAEDISTOFAN ONN SF.
TAEKNITHJONUSTAN SF.

79000-34252 REVISION 2
193.452 B