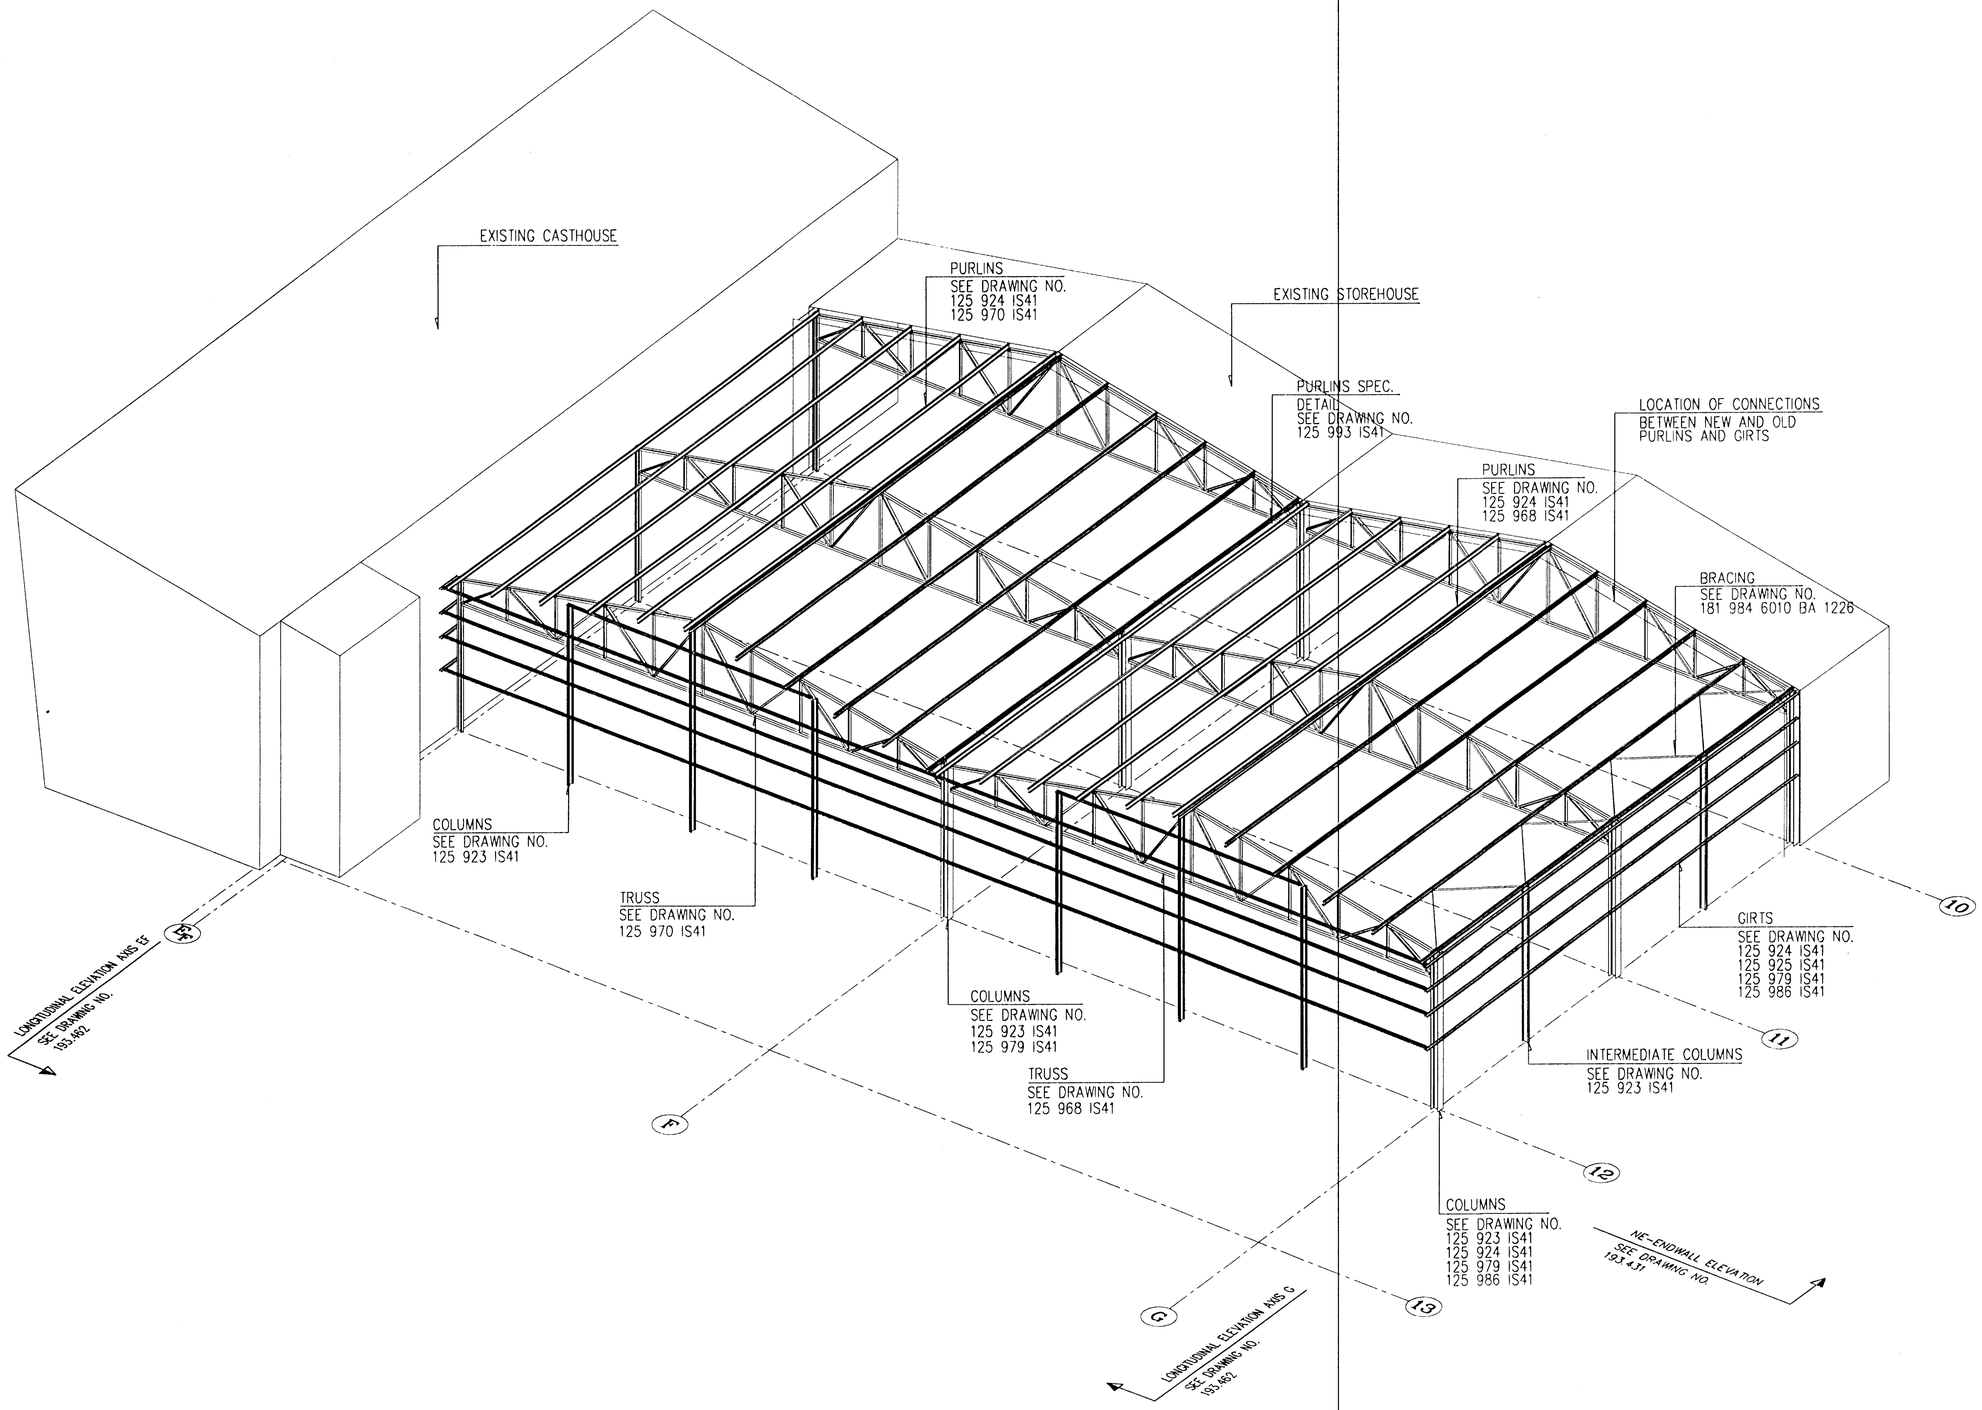

REV. NO.	DATE	REVISION	BY	APP.	REV. NO.	DATE	REVISION	BY	APP.
1 A	14.12.1997	AS BUILD	UH						
0	20.5.1996	ISSUED FOR TENDER							

NOTES

REFERENCE DRAWING

DRAWING NUMBER

This drawing is our property and given for personal use only. It may not be copied or made available to others without our permission. The receiver is responsible for any misuse.

ICELANDIC ALUMINIUM COMPANY LTD.

DRAWN	3.5.1996	HHH	
APPROVED	3.5.1996	UH/JK	
PROCESS			
PROJECT			
SCALE N.T.S.		FORMAT A1	

CASTHOUSE EXTENSION – STORAGE AREA
STRUCTURAL
SCHEMATIC OF STEEL CONSTRUCTION
EF-G/10-12

ALUSUISSE ALESA
ALESA
ALUSUISSE ENGINEERING LTD.
ZURICH SWITZERLAND

VERKFRAEDISTOFAN ONN SF.
TAEKNITHJONUSTAN SF.

79000-34261

REVISION 1

193.461 A