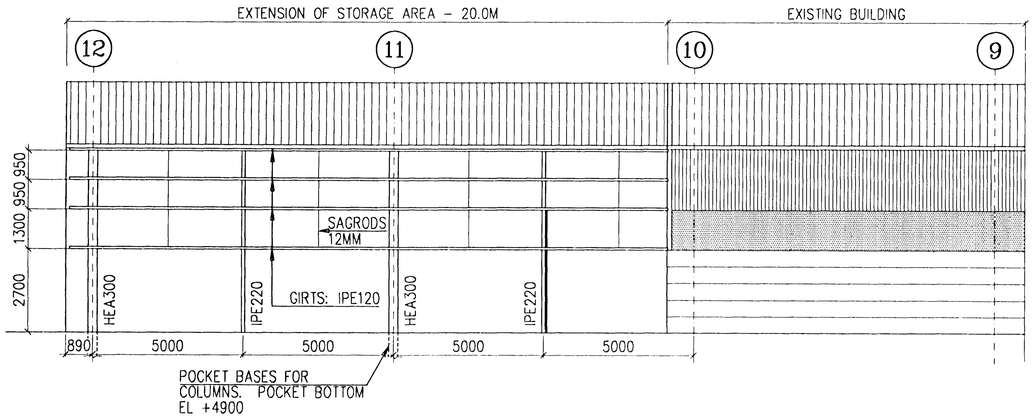

LONGITUDINAL ELEVATION AXIS (G) 1:100

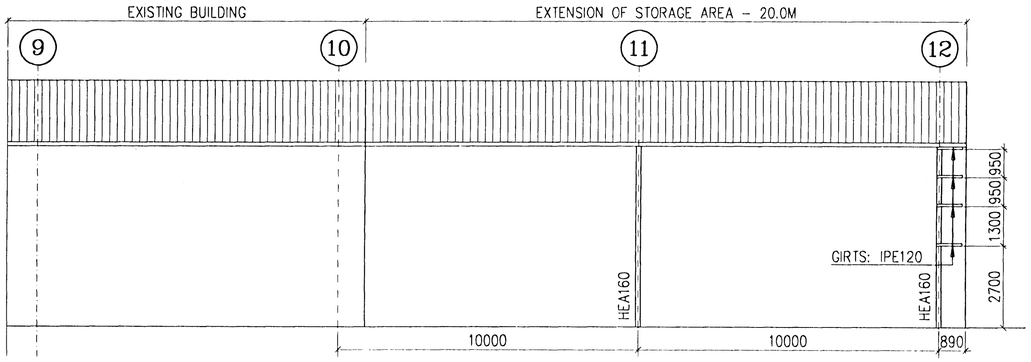

LONGITUDINAL ELEVATION AXIS (EF) 1:100

REV. NO.	DATE	REVISION	BY	APP.
1 A	5.11.1997	AS BUILD	UH	
0	20.5.1996	ISSUED FOR TENDER		

REV. NO.	DATE	REVISION	BY	APP.

NOTES

REFERENCE DRAWING

DRAWING NUMBER

This drawing is our property and given for personal use only. It may not be copied or made available to others without our permission. The receiver is responsible for any misuse.

ICELANDIC ALUMINIUM COMPANY LTD.

DRAWN	3.5.1996	HHH
APPROVED	3.5.1996	UH/JK
PROCESS		
PROJECT		
SCALE	1:100	FORMAT A1

CASTHOUSE EXTENSION – STORAGE AREA
STRUCTURAL
LONGITUDINAL ELEVATION
AXES G AND EF

ALUSUISSE ALESA
ALESA
ALUSUISSE ENGINEERING LTD.
ZURICH SWITZERLAND

VERKFRAEDISTOFAN ONN SF.
TAEKNITHJONUSTAN SF.

79000-34262 REVISION 1

193.462 A