


EL. +5800
GROUND FLOOR

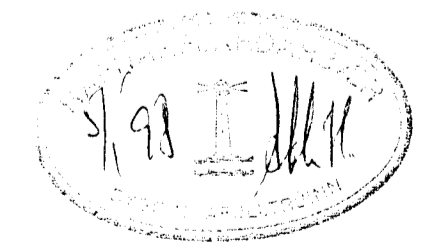

REV. NO.	DATE	REVISION	BY	APP.	REV. NO.	DATE	REVISION	BY	APP.	NOTES
2 B	22.11.1997	AS BUILD		UH						
1	11.9.1996	WIDTH OF BUILDING ADJUSTED TO ADJ. BUILDING IN LINE A		UH						
0	30.8.1996	ISSUED FOR CONSTRUCTION								

SECTIONS A AND B	193.512
FOUNDATIONS F6, F7, F8 AND F9	193.513
FOUNDATIONS F1 THROUGH F5	193.512
COLUMNS, SECTION AND ELEVATION	193.518
REFERENCE DRAWING	DRAWING NUMBER

This drawing is our property and given for personal use only. It may not be copied or made available to others without our permission. The receiver is responsible for any misuse.

ICELANDIC ALUMINIUM COMPANY LTD. 	DRAWN 28.8.1996 HHH APPROVED 28.8.1996 UH/JK PROCESS PROJECT SCALE 1:50 FORMAT A1	CASTHOUSE EXTENSION - BALCONY AREA STRUCTURAL FOUNDATION PLAN - DIMENSIONS -1 - 1/A-C	REVISION
	ALESA ALUSUISSE ENGINEERING LTD. ZURICH SWITZERLAND	79000-34311	2
	VERKFRÆDISTOFAN ONN SF. TAEKNITHJONUSTAN SF.	193.511	B