
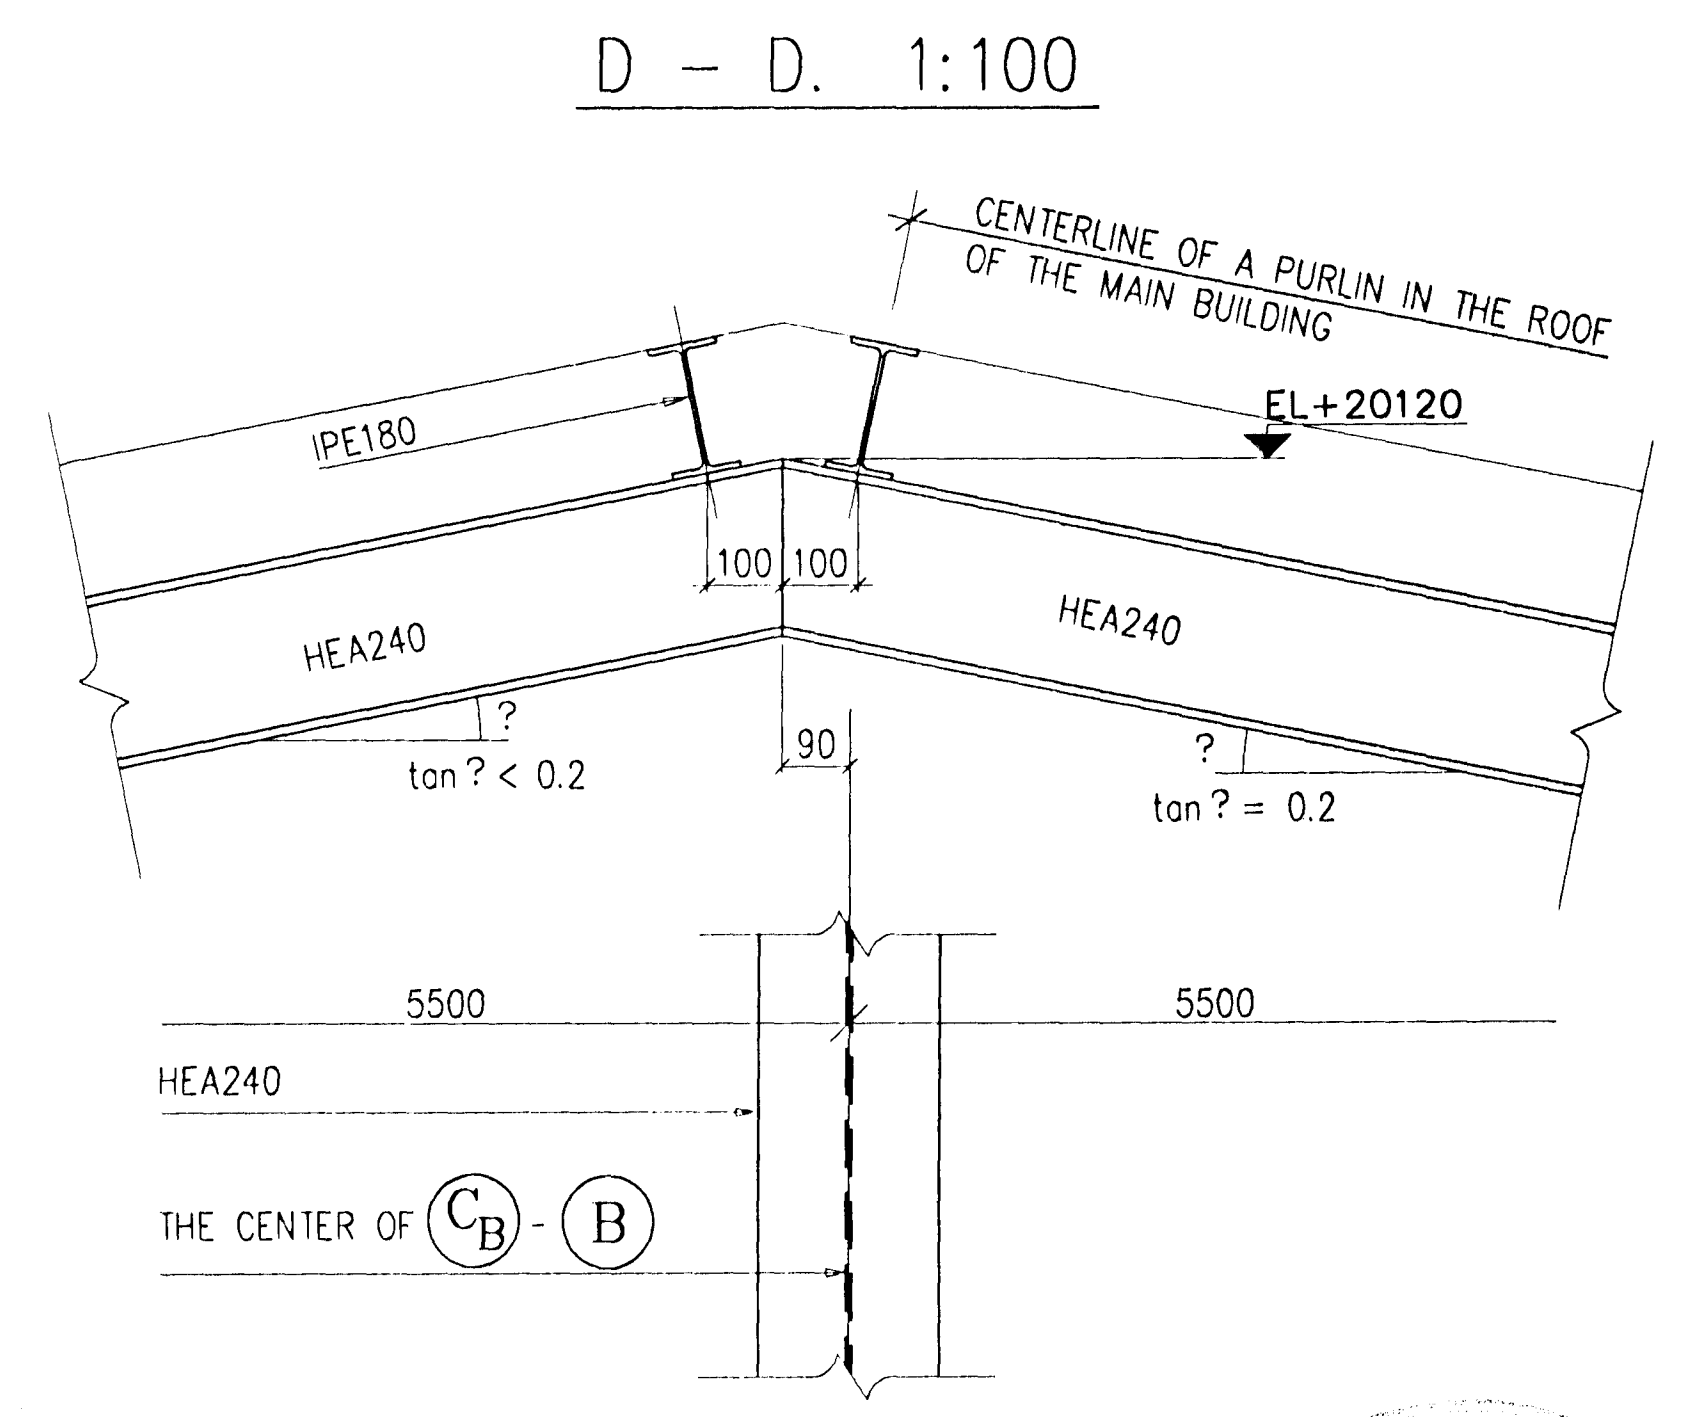
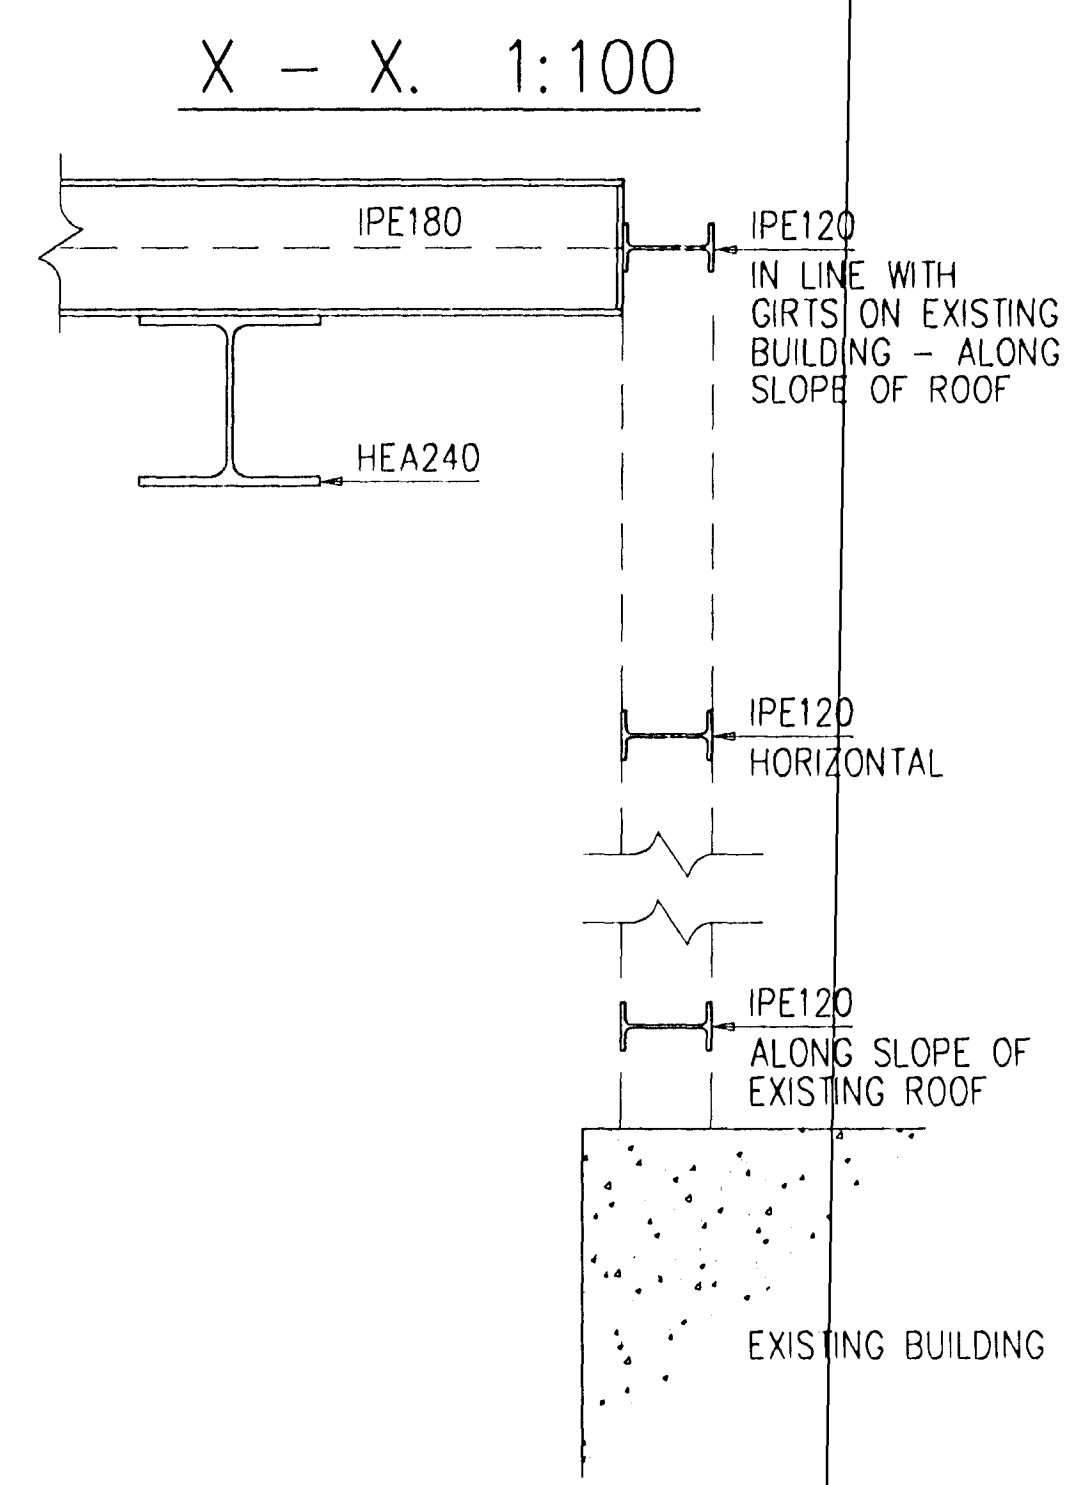


ROOF PLAN. 1:100

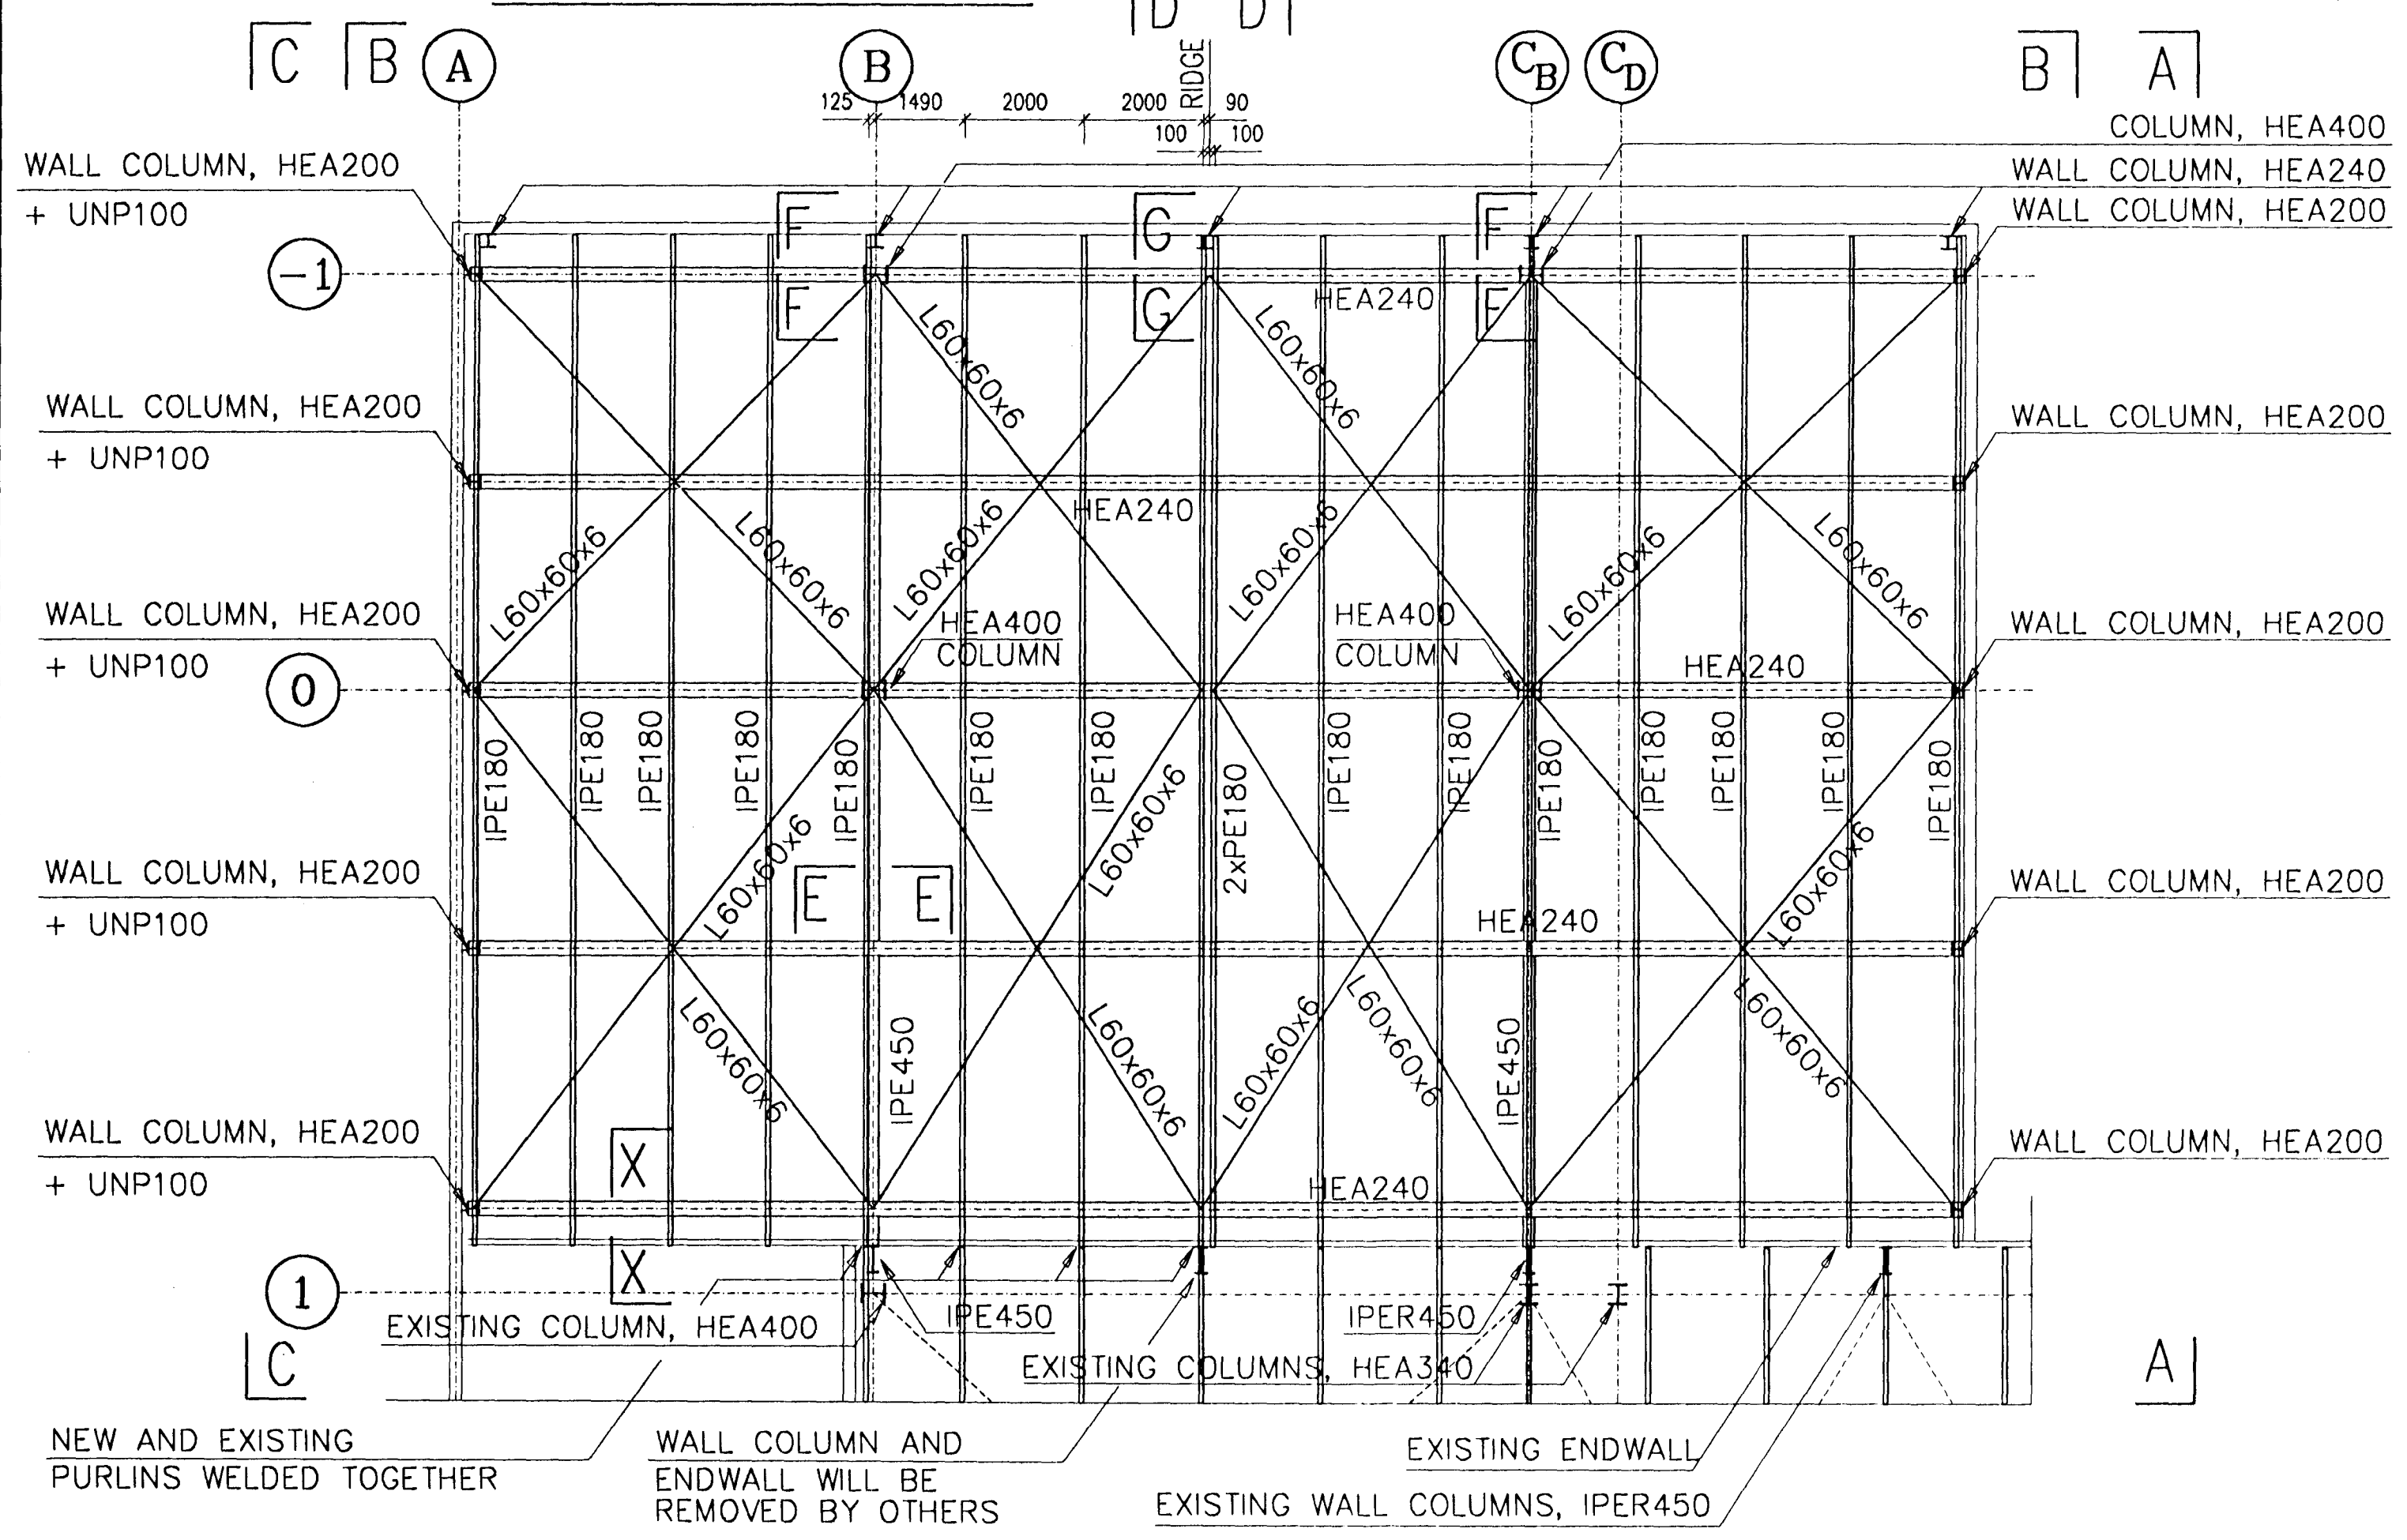

REV. NO.	DATE	REVISION	BY	APP.	REV. NO.	DATE	REVISION	BY	APP.	NOTES
2 B	26.11.1997	AS BUILD								
1	11.9.1996	WIDTH OF BUILDING ADJUSTED TO ADJ. BUILDING IN LINE A								
0	3.9.1996	ISSUED FOR CONSTRUCTION								

SECTION	DRAWING NUMBER
SECTIONS E, F AND G	193.522
DETAILS H, I, J, K AND L	193.522
PLAN OF COLUMNS	193.511

<p>This drawing is our property and given for personal use only. It may not be copied or made available to others without our permission. The receiver is responsible for any misuse.</p>	<p>ICELANDIC ALUMINIUM COMPANY LTD.</p>	<p>DRAWN 3.9.1996 HHH</p> <p>APPROVED 3.9.1996 UH/JK</p> <p>PROCESS</p> <p>PROJECT</p> <p>SCALE 1:100</p>	<p>CASTHOUSE EXTENSION - BALCONY AREA</p> <p>STRUCTURAL</p> <p>ROOF PLAN AND WALL ELEVATIONS</p>
	<p>ALUSUISSE ALESA</p>	<p>ALUSUISSE ENGINEERING LTD. ZURICH SWITZERLAND</p>	<p>79000-34321</p>
	<p>VERKFRÆDISTOFAN ÖNN SF. TÆKNITHJONUSTAN SF.</p>	<p>193.521</p>	<p>2</p>
	<p>©</p>	<p>REVISION</p> <p>B</p>	