YFIRLITSMYND 1:1000

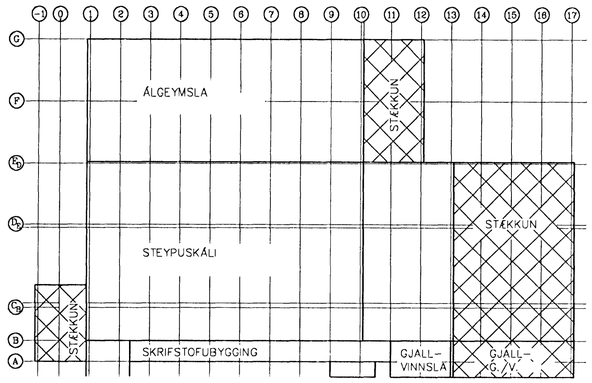

SA-HLIÐ. 1:250

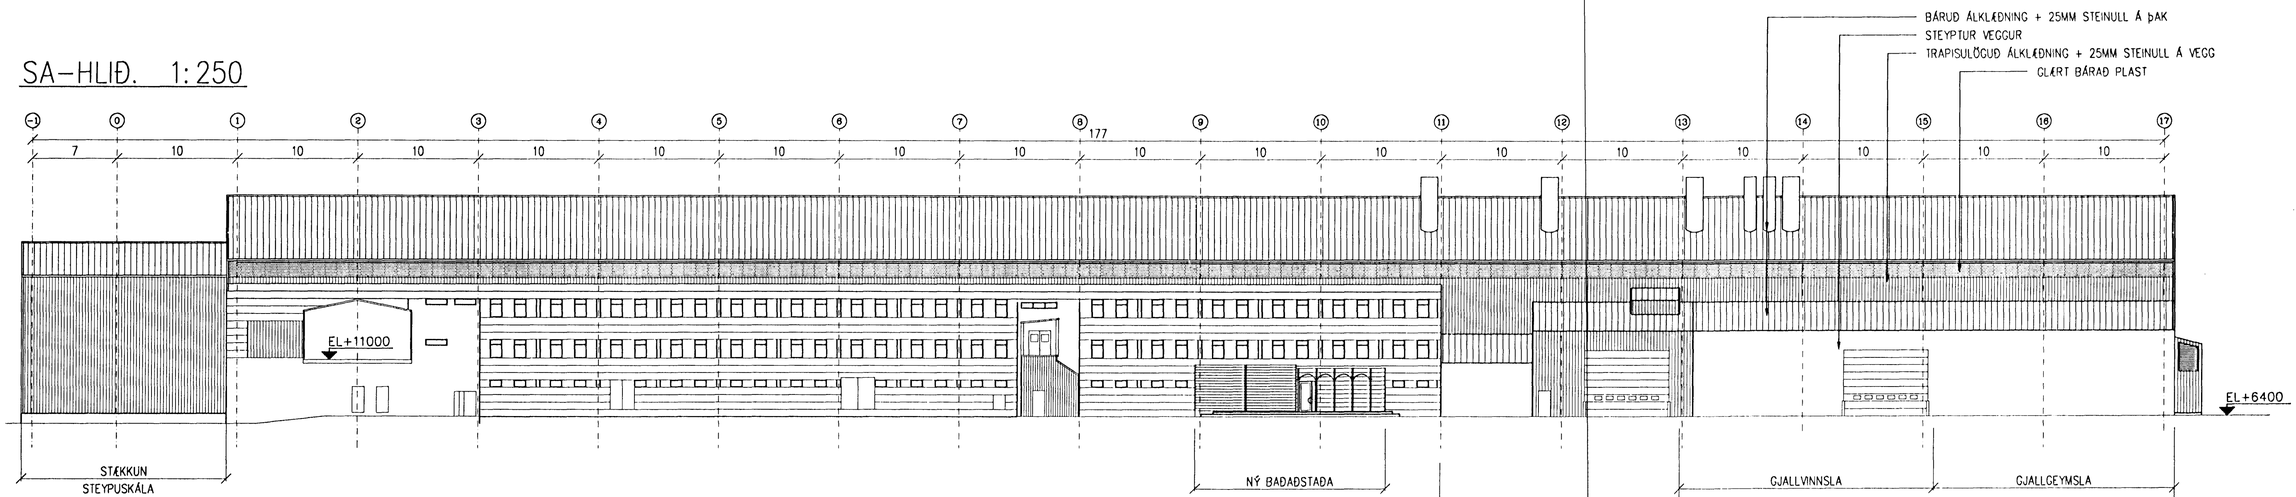

NV-HLIÐ. 1:250

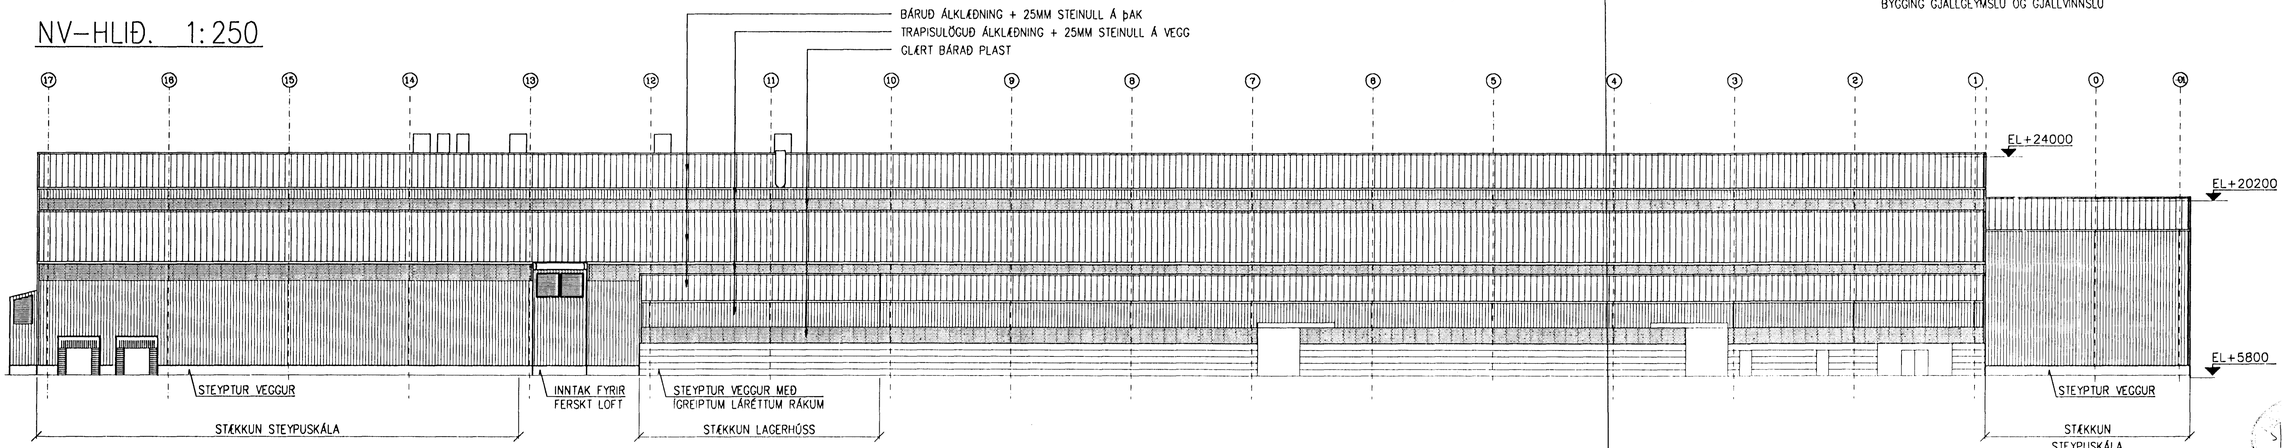

REV. NO.	DATE	REVISION	BY	APP.
3 C	25.11.1197	EINS OG BYGGT ER, "AS BUILD"	UH	
2	10.2.1997	BÚNINGSHERBERGI ENDURBÆTT OG BAÐAÐSTAÐA STÆKKUÐ	UH	
1	3.9.1996	SVALASVÆÐI STÆKKAÐ ÚR 10M I 17M	UH	
0				

REV. NO.	DATE	REVISION	BY	APP.

NOTES

REFERENCE DRAWING

DRAWING NUMBER

This drawing is our property and given for personal use only. It may not be copied or made available to others without our permission. The receiver is responsible for any misuse.

ICELANDIC ALUMINIUM COMPANY LTD.

DRAWN	23.7.1996	HHH	
APPROVED	23.7.1996	UH	
PROCESS			
PROJECT			
SCALE	1:250	FORMAT	A1

STÆKKUN STEYPUSKÁLA - BRUNAHÖNNUN
ÚTLITSTEIKNING
HLIÐARMYNDIR LANGHLIÐA
YFIRLITSMYND

ALUSUISSE ALESA

ALESA
ALUSUISSE ENGINEERING LTD.
ZURICH SWITZERLAND

VERKFRAEDISTOFAN ONN SF.
TAEKNITHJONUSTAN SF.

79000-34421 REVISION 3

193.621 C