NA-GAFL. 1:250

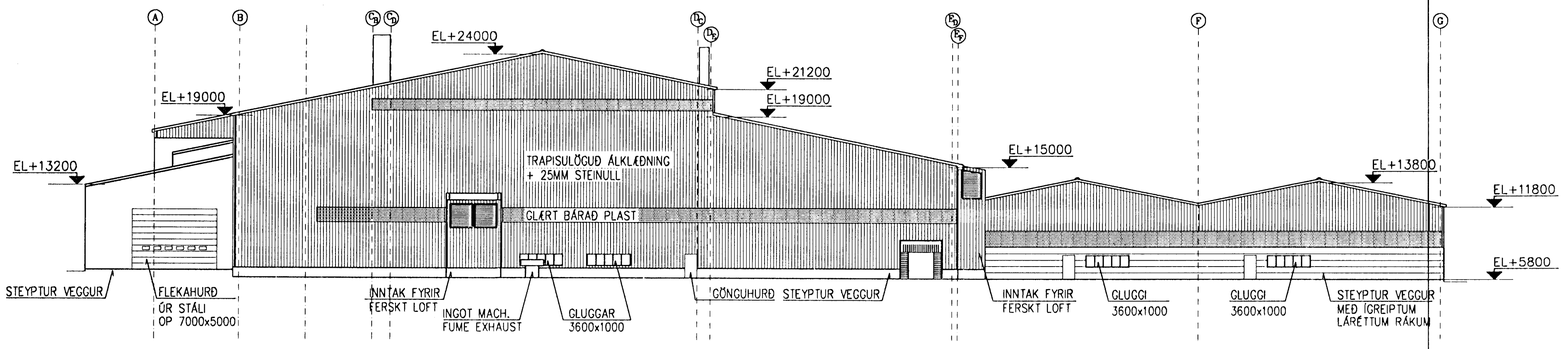

SV-GAFL. 1:250

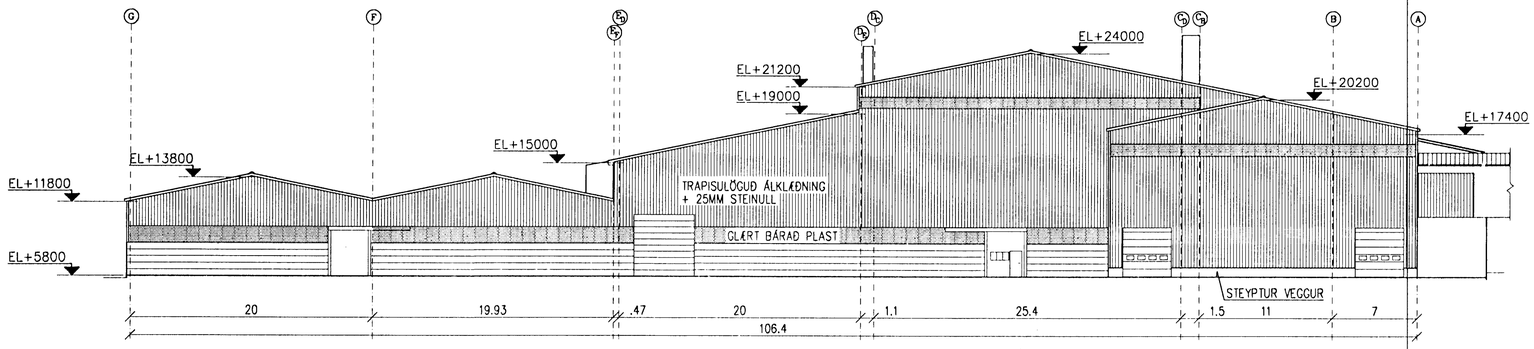

YFIRLITSMYND 1:1000

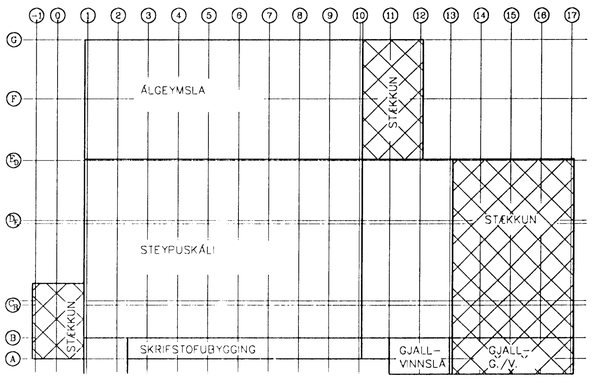

REV. NO.	DATE	REVISION	BY	APP.	REV. NO.	DATE	REVISION	BY	APP.
2 B	26.11.1997	EINS OG BYGGT ER, "AS BUILD"	UH						
1	3.9.1996	SVALASVÆÐI STÆKKAÐ ÚR 10M Í 17M	UH						

NOTES

REFERENCE DRAWING

DRAWING NUMBER

This drawing is our property and given for personal use only. It may not be copied or made available to others without our permission. The receiver is responsible for any misuse.

ICELANDIC ALUMINIUM COMPANY LTD.

DRAWN	23.7.1996	HHH
APPROVED	23.7.1996	UH
PROCESS		
PROJECT		
SCALE 1:250	FORMAT A1	

STÆKKUN STEYPUSKÁLA - BRUNAHÖNNUN
ÚTLITSTEIKNING
HLIÐARMYNDIR GAFLA
YFIRLITSMYND

ALUSUISSE ALESA
ALUSUISSE ALESA ENGINEERING LTD.
ZURICH SWITZERLAND

79000-34422 REVISION 2

VERKFRAEDISTOFAN ONN SF.
TAEKNITHJONUSTAN SF.

193.622 B