

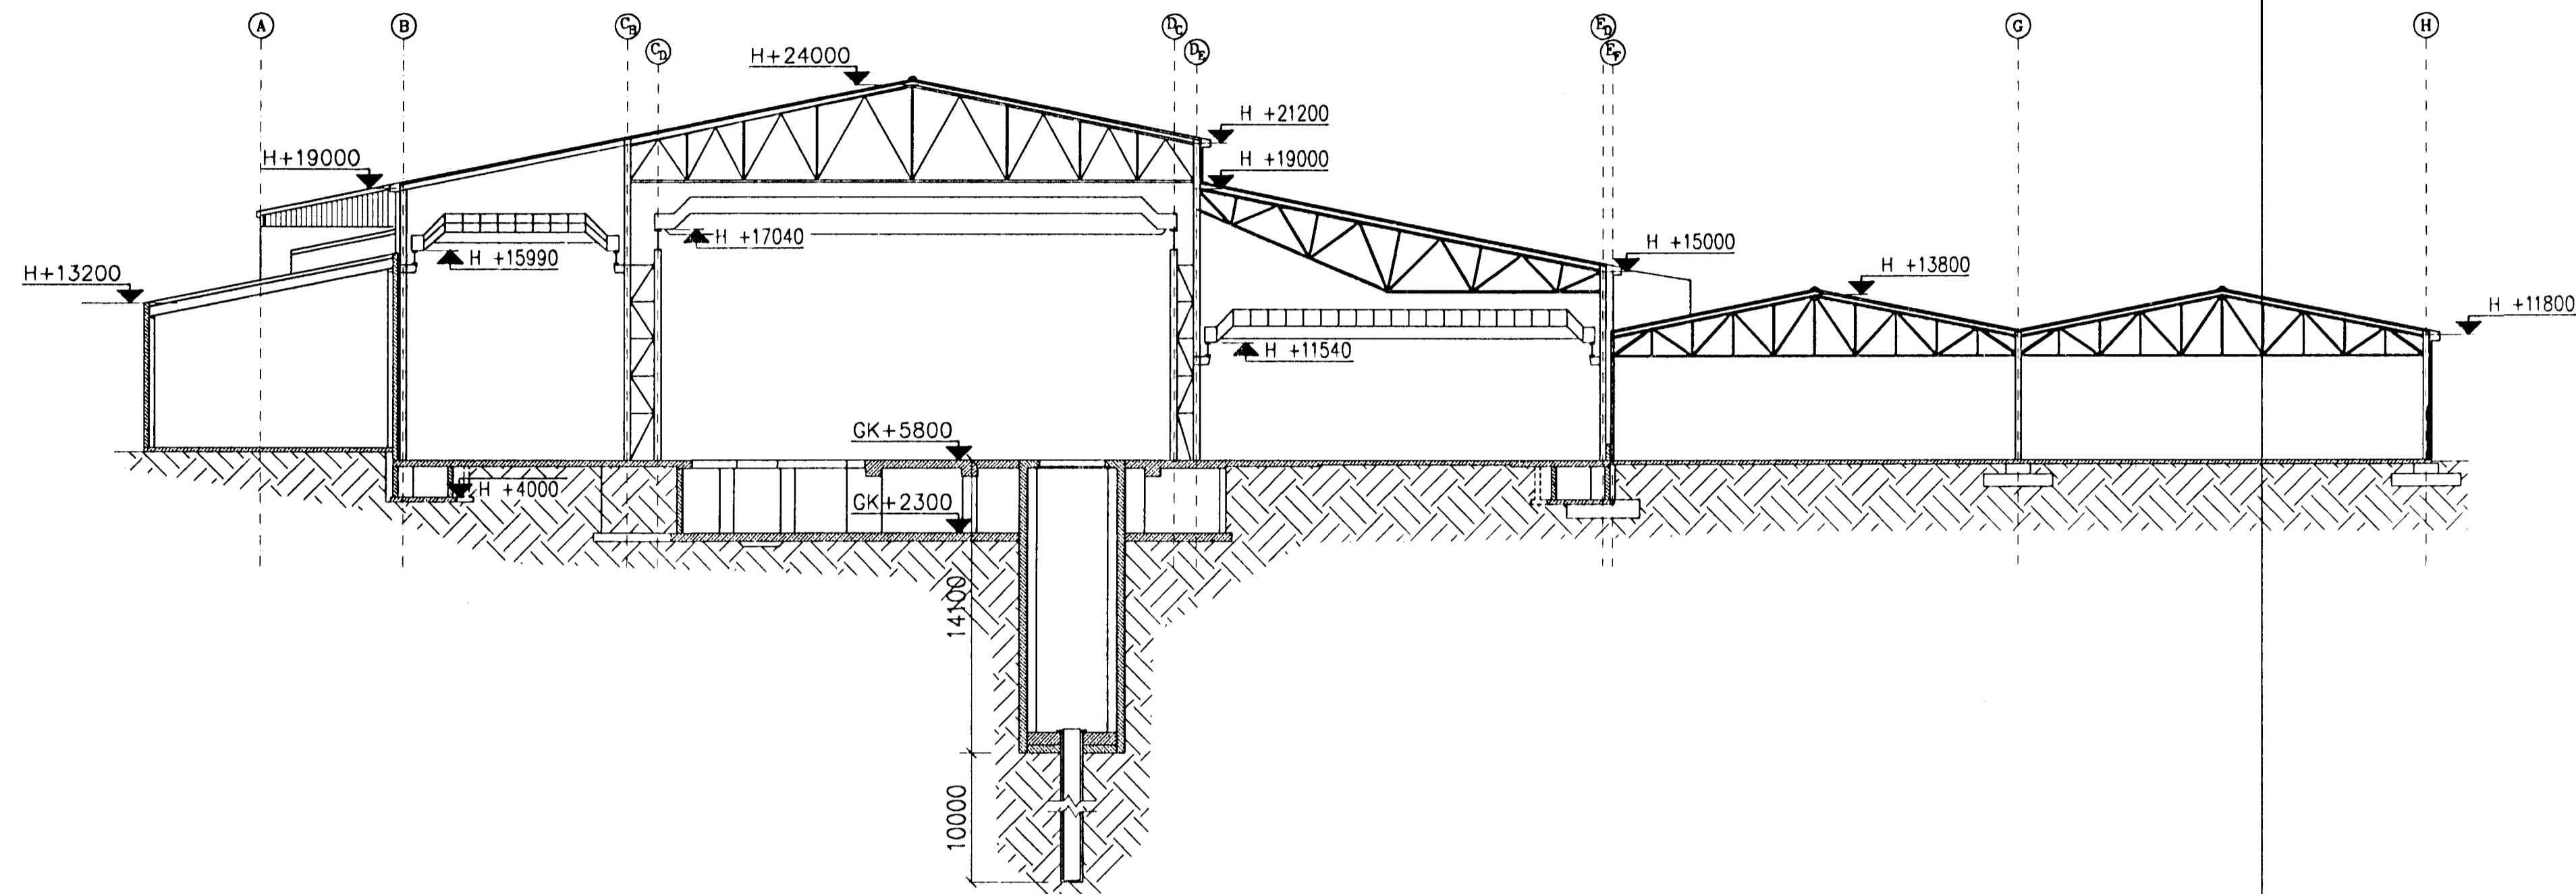
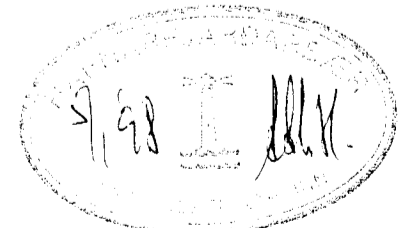


A-A. 1:250

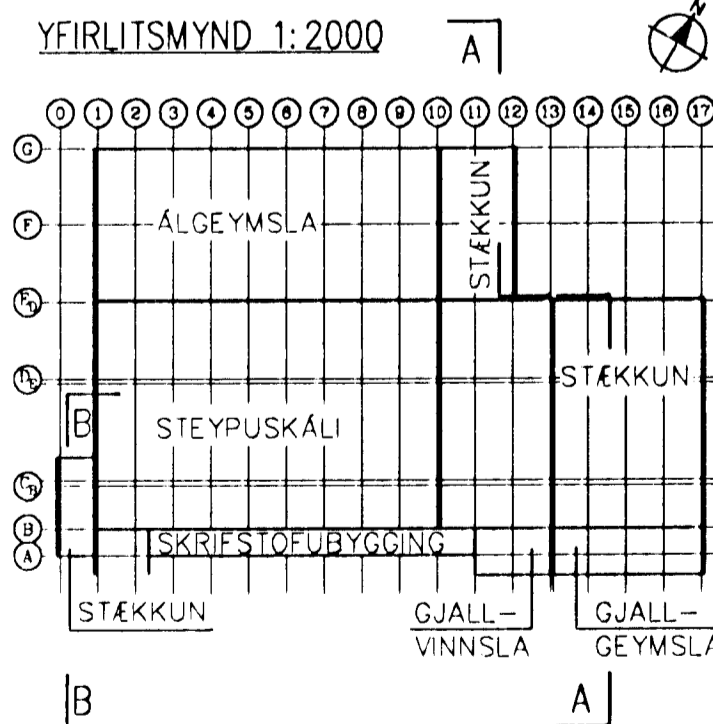

B-B. 1:250

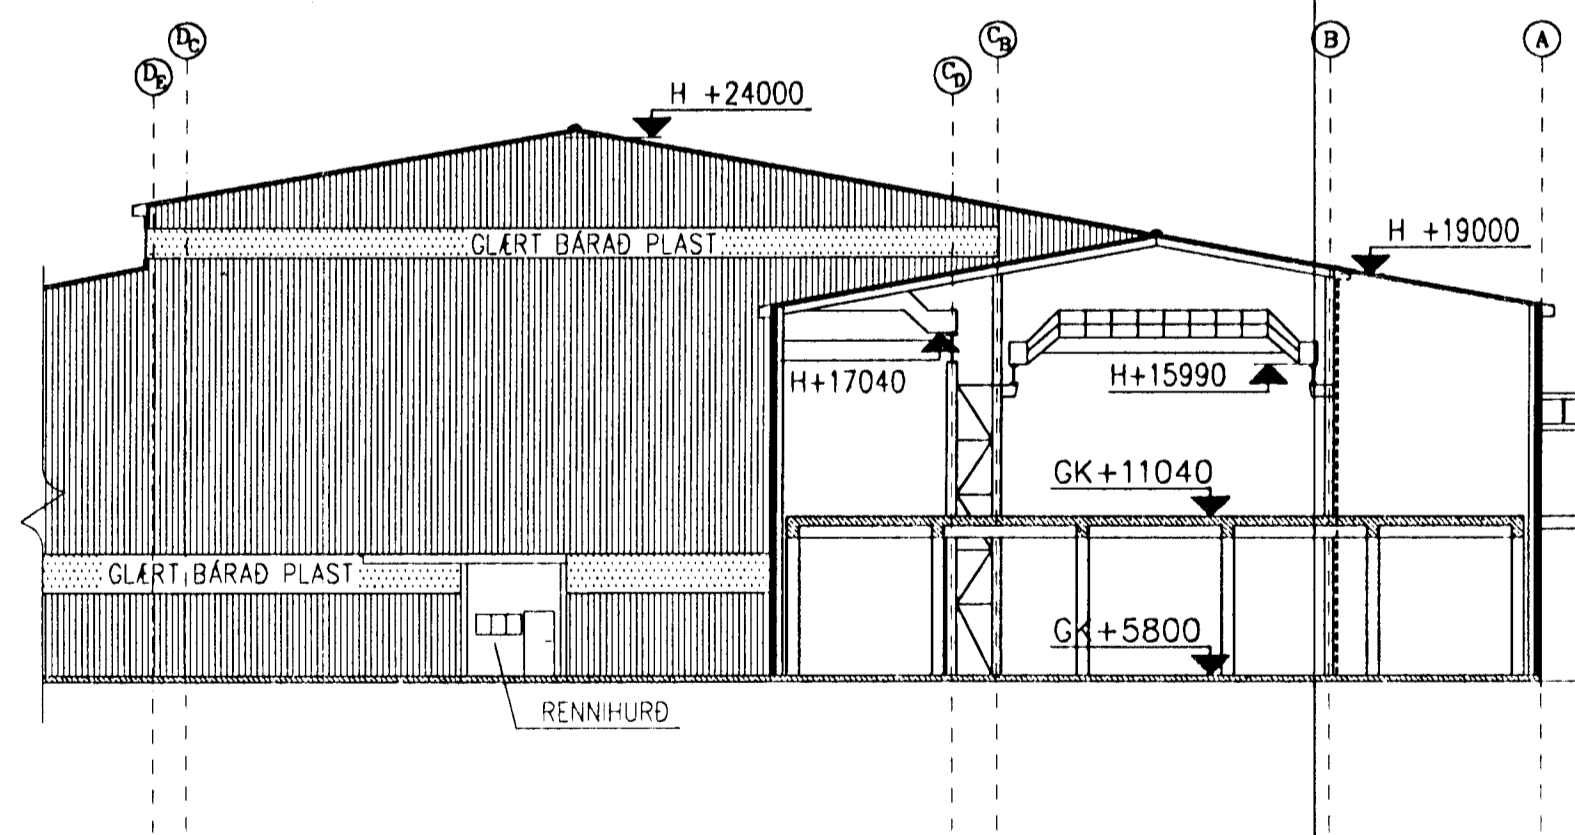

REV. NO.	DATE	REVISION	BY	APP.	REV. NO.	DATE	REVISION	BY	APP.	NOTES	REFERENCE DRAWING	DRAWING NUMBER
1	26.11.1997	EINS OG BYGGT ER, "AS BUILD"	UH									
0												

This drawing is our property and given for personal use only. It may not be copied or made available to others without our permission. The receiver is responsible for any misuse.

ICELANDIC ALUMINIUM COMPANY LTD.

ALUSUISSE ALESA

ALUSUISSE ENGINEERING LTD.
ZURICH SWITZERLAND

VERKFRÆDISTOFAN ÖNN SF.
TÆKNITHJONUSTAN SF.

DRAWN 24.7.1996
APPROVED 24.7.1996
PROCESS
PROJECT
SCALE 1:250
FORMAT A1

HHH
UH

STÆKKUN STEYPUSKÁLA
SNID

79000-34425
193.625

REVISION 1