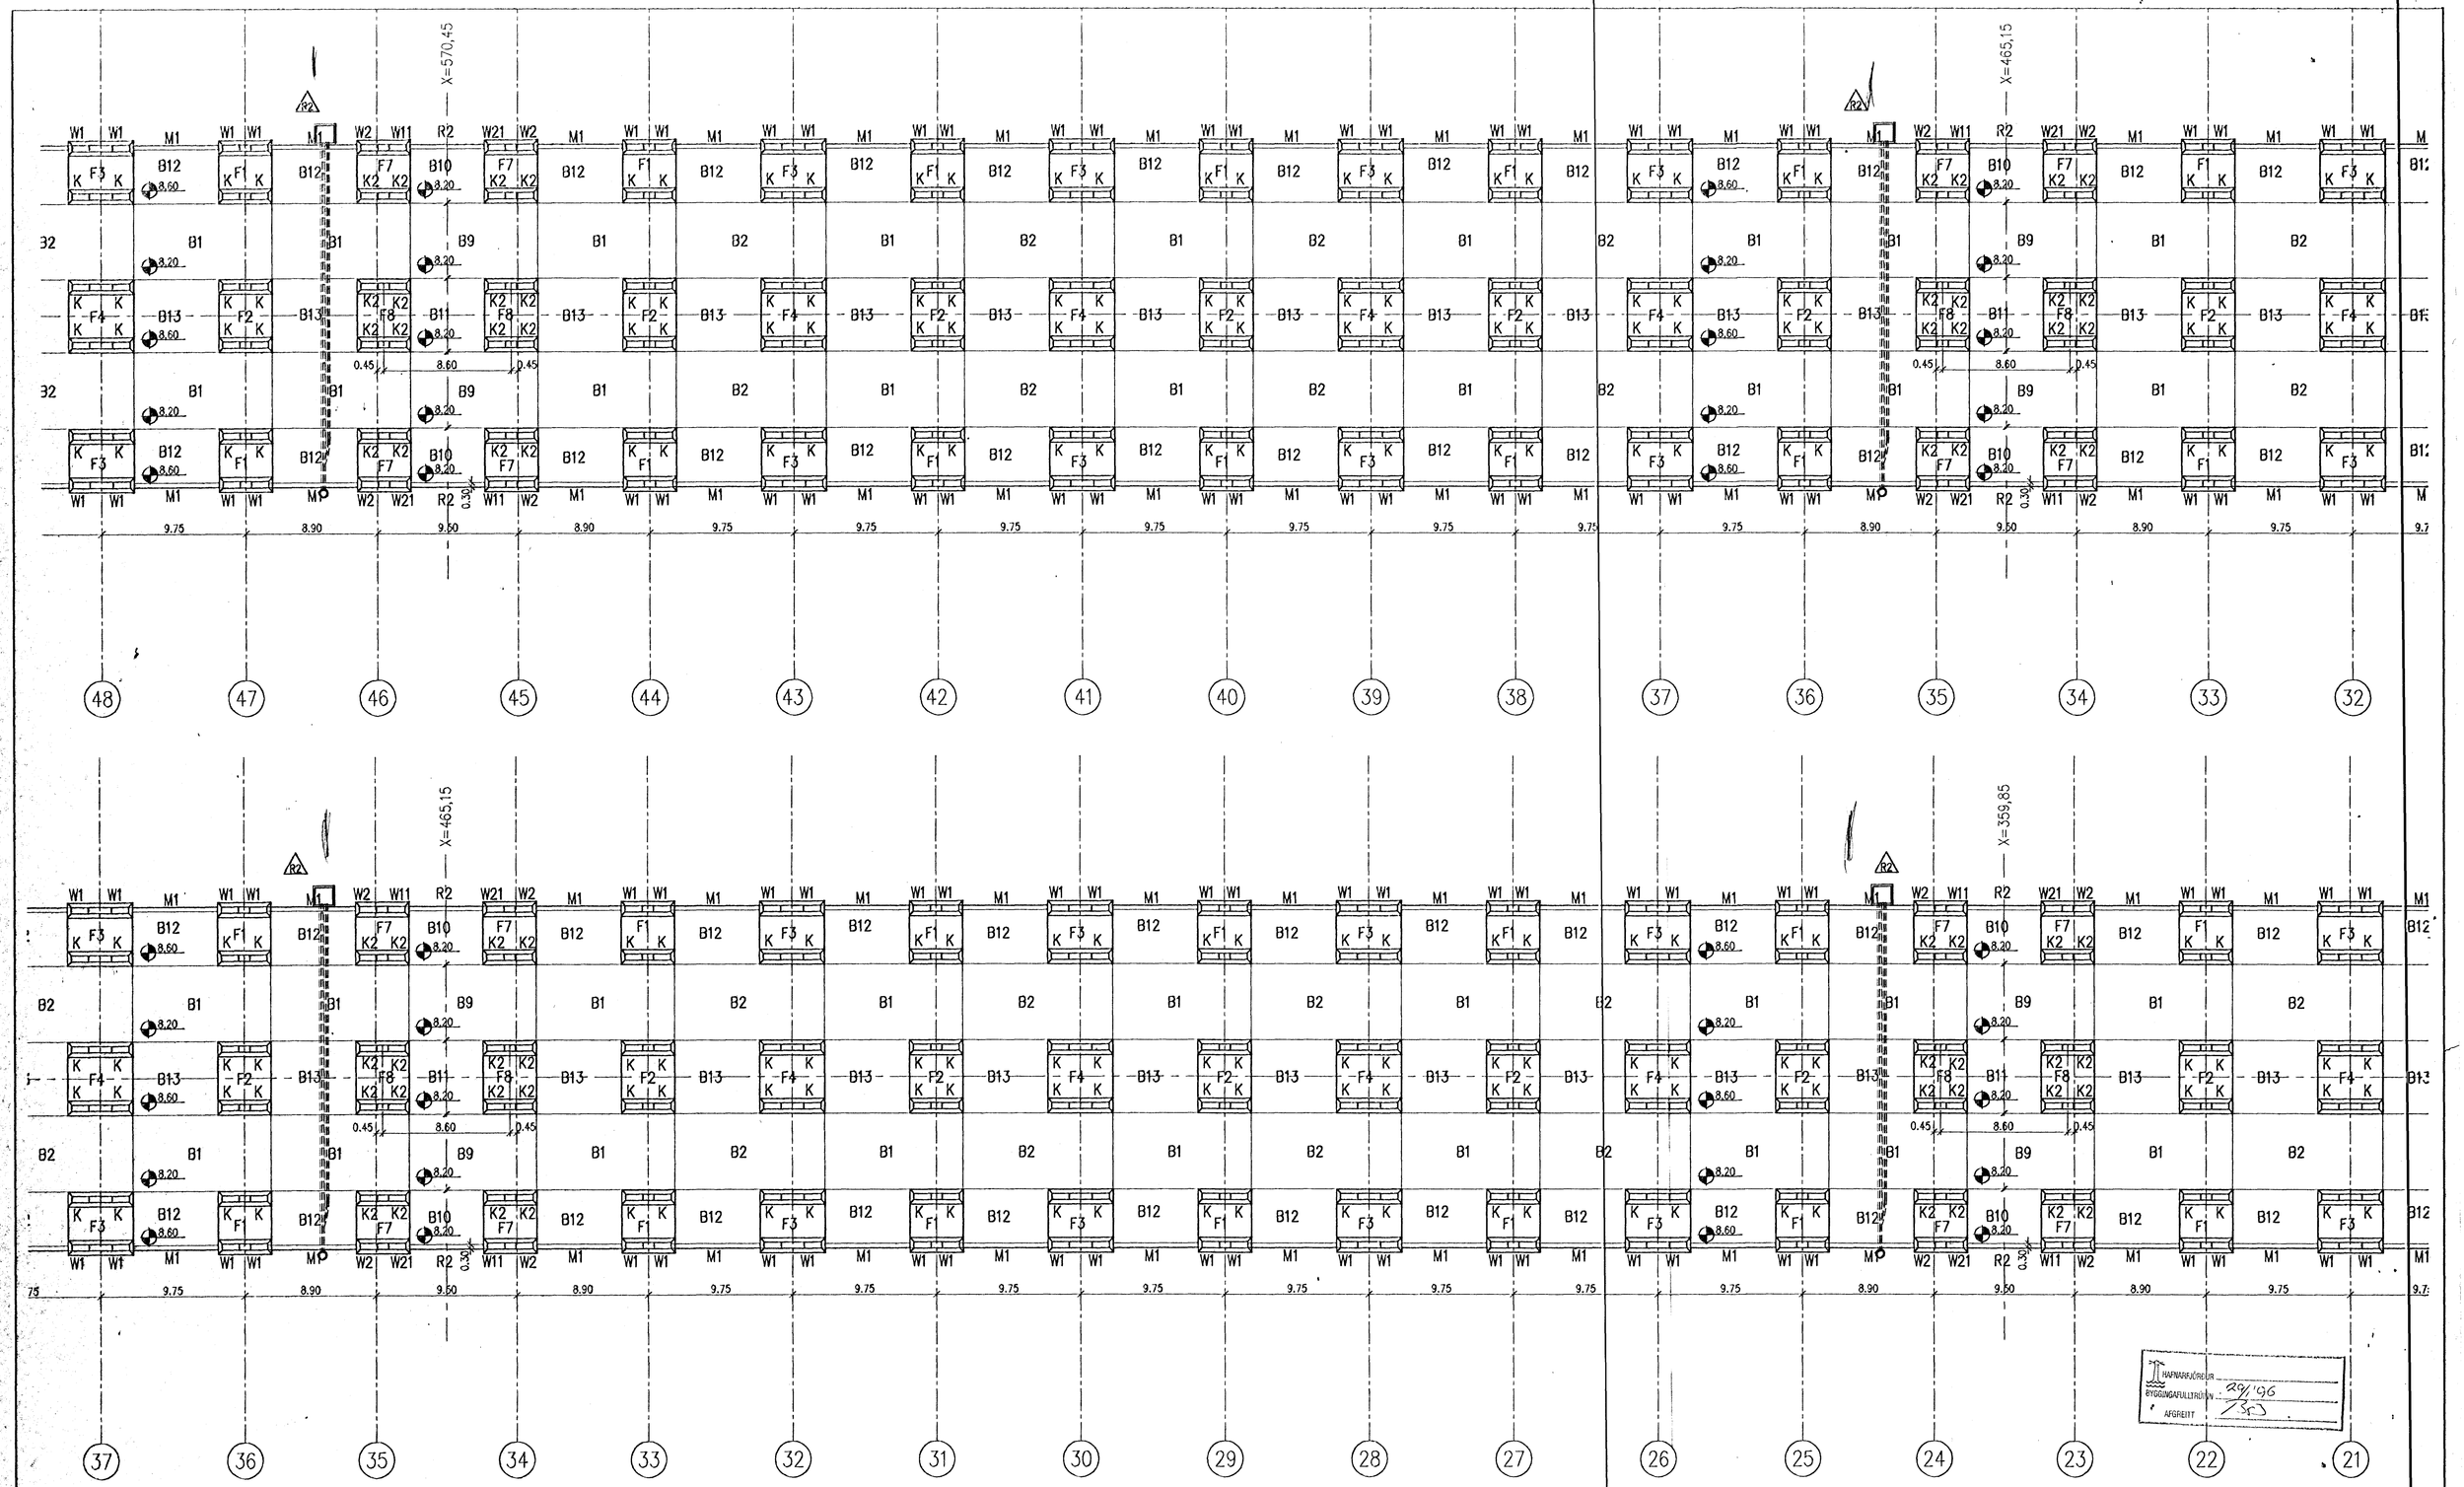

HAFNARFJÖRÐUR
BYGGINGARFULLTRÚINN
AFGREITT 29/1/96

1:200
10 0 10 20 m

REV. NO.	DATE	REVISION	BY	APP.
2	1996.01.23	SUBSTATIONS AND EL-PIPES	SHJ	N.I.
1	1996.01.02	APPROVED FOR CONSTRUCTION		N.I.

REV. NO.	DATE	REVISION	BY	APP.

NOTES	REFERENCE DRAWING	DRAWING NUMBER

This drawing is our property and given for personal use only. It may not be copied or made available to others without our permission. The receiver is responsible for any misuse.

VST CONSULTING ENGINEERS Ltd.
Armula 4 108 Reykjavik Iceland
Tel:+354 569 5000 Fax:+354 569 5010

95.120 – 12.103

ICELANDIC ALUMINIUM COMPANY LTD.

DRAWN	95.10.28	FGS	POTROOM NO. 3
APPROVED	95.10.28	KGS	CONCRETE WORK
PROCESS	95.10.28	NI	FOUNDATION PLAN, PART 2/4
PROJECT	95.10.28	NI	FORMWORK
SCALE 1:200		FORMAT A1	

ALUSUISSE ALESA — ALUSUISSE ENGINEERING LTD. ZURICH SWITZERLAND — ALESA — 79000-32303 — REVISION 2

ISAL — ICELANDIC ALUMINIUM CO. LTD — 186.603