


Substation not in contract.

SKU ER ÞETTA ALTAÐS?
SAMÞINGI INNI Í SKALA
VAR SVNT INNI Í SKALA
SKU UPPAFLAGU TEKNU

NAFNAFÖRÐUR
BYGGINGAFLUTUN
AFGREITT
29/10/96
ZS

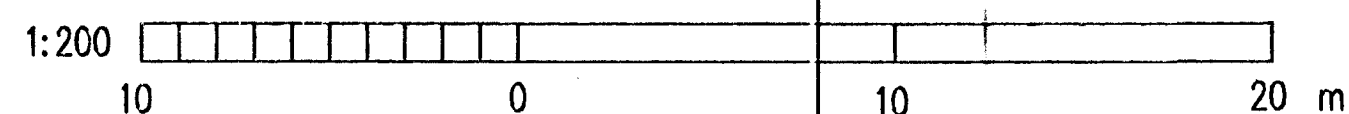

VST CONSULTING ENGINEERS LTD. Armúla 4, 108 Reykjavík, Iceland Tel: +354 569 5000 Fax: +354 569 5010		95.120 - 12.104	
ICELANDIC ALUMINIUM COMPANY LTD.		DRAWN 95.10.28 FGS APPROVED 95.10.28 KGS PROCESS 95.10.28 NI PROJECT 95.10.28 NI SCALE 1:200 FSR/AT	POTROOM NO. 3 CONCRETE WORK FOUNDATION PLAN, PART 3/4 FORMWORK
ALUSUISSE ALESA		ALESA ENGINEERING LTD. ZÜRICH SWITZERLAND	79000-32304
ISAL		ICELANDIC ALUMINIUM CO. LTD	186.604

REV. NO.	DATE	REVISION	BY	APP.	REV. NO.	DATE	REVISION	BY	APP.	NOTES	REFERENCE DRAWING	DRAWING NUMBER
2	1996.01.23	SUBSTATIONS AND EL-PIPES	SH	N.I.								
1	1996.01.02	APPROVED FOR CONSTRUCTION		N.I.								