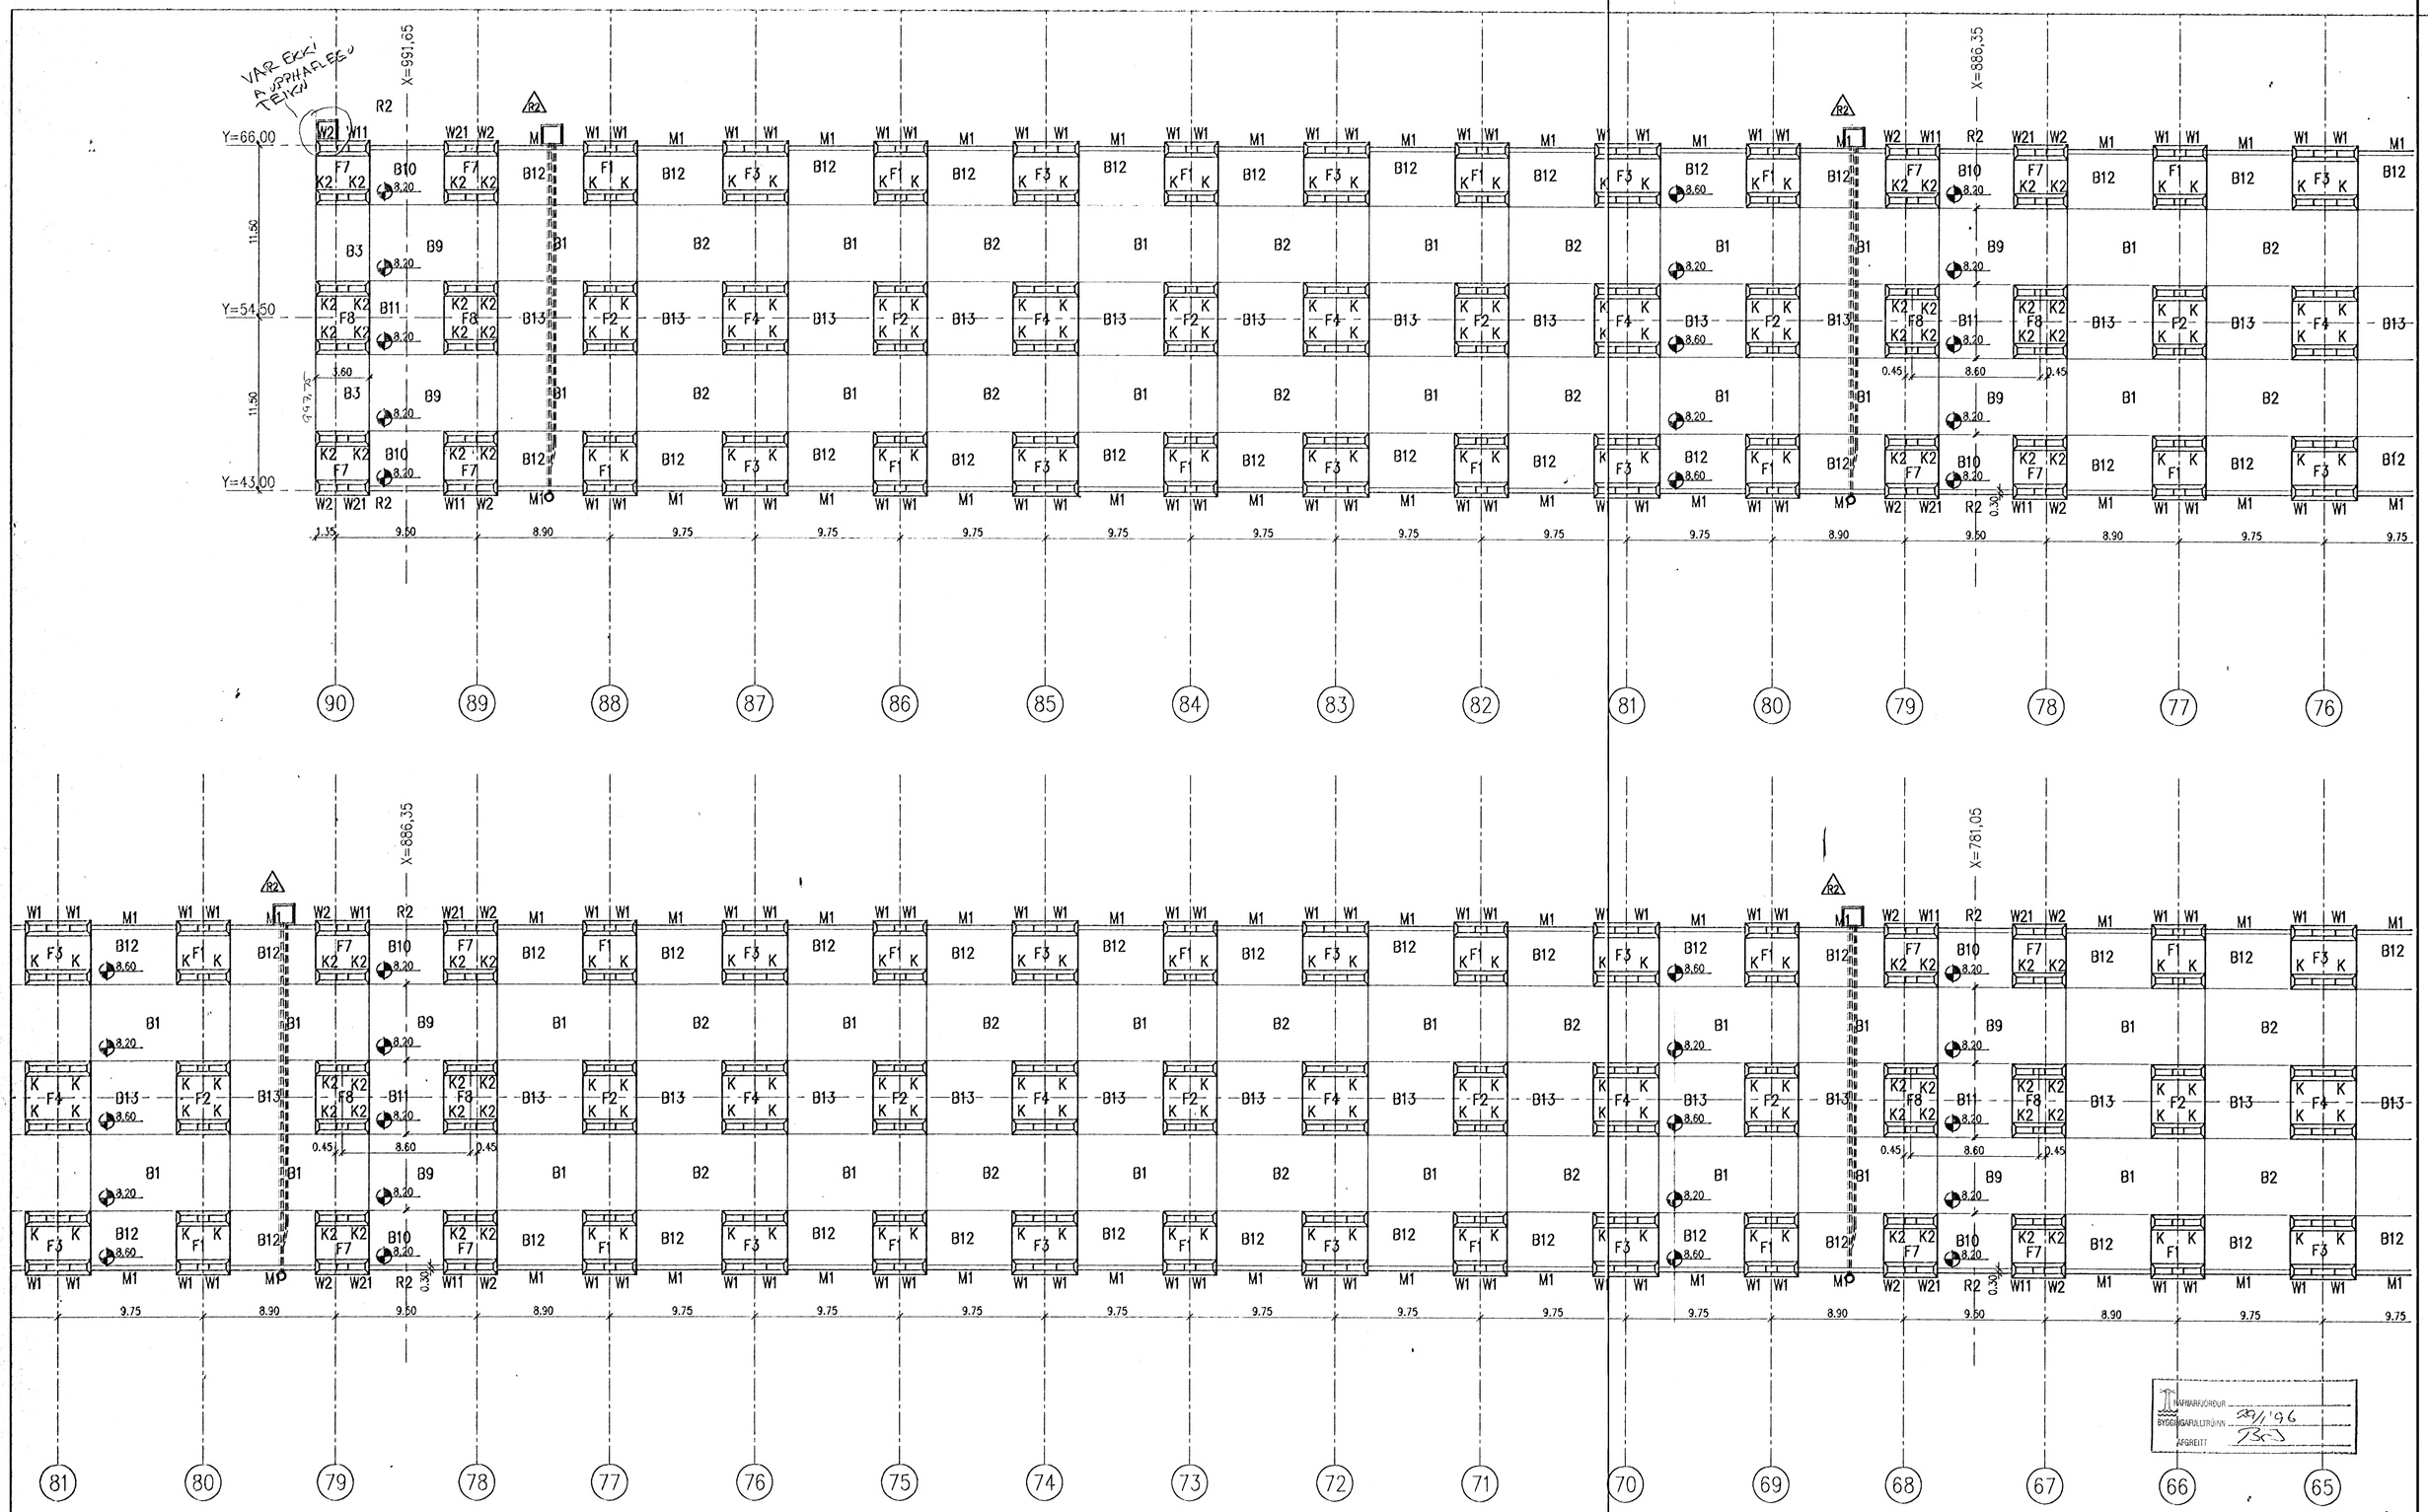

REV. NO.	DATE	REVISION	BY	APP.
2	1996.01.23	SUBSTATIONS AND EL-PIPES	SHG	N.I.
1	1996.01.02	APPROVED FOR CONSTRUCTION		N.I.

REV. NO.	DATE	REVISION	BY	APP.

NOTES

REFERENCE DRAWING

DRAWING NUMBER

This drawing is our property and given for personal use only. It may not be copied or made available to others without our permission. The receiver is responsible for any misuse.

VST CONSULTING ENGINEERS Ltd.
Armula 4 108 Reykjavik Iceland
Tel: +354 569 5000 Fax: +354 569 5010

ICELANDIC ALUMINIUM COMPANY LTD.

DRAWN	95.10.28	FGS
APPROVED	95.10.28	KGS
PROCESS	95.10.28	NI
PROJECT	95.10.28	NI
SCALE	1:200	FORMAT A1

ALESA
ALUSUISSE ENGINEERING LTD.
ZURICH SWITZERLAND

ICELANDIC ALUMINIUM CO. LTD

95.120 – 12.105

POTROOM NO. 3
CONCRETE WORK
FOUNDATION PLAN, PART 4/4
FORMWORK

79000–32305

186.605

REVISION 2