T1 — 80 pieces

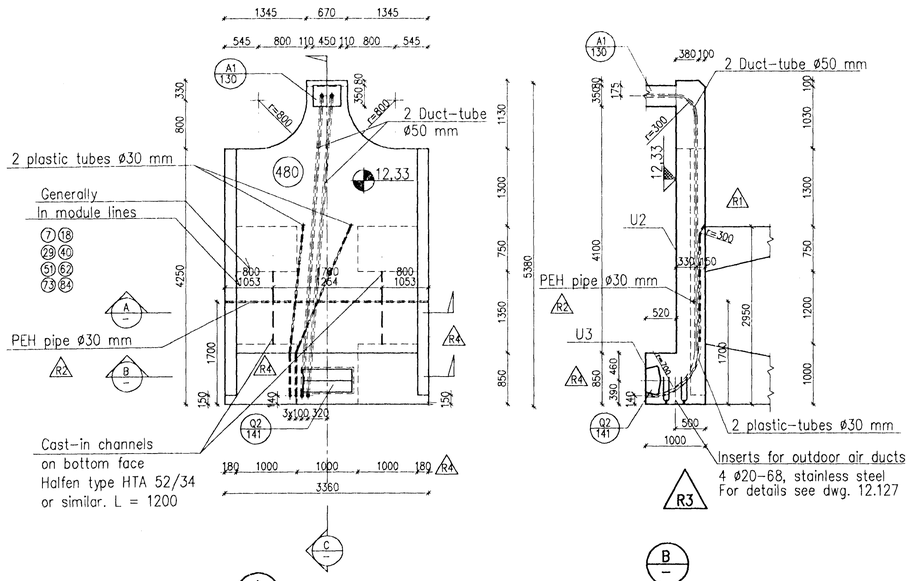

T3 — 64 pieces

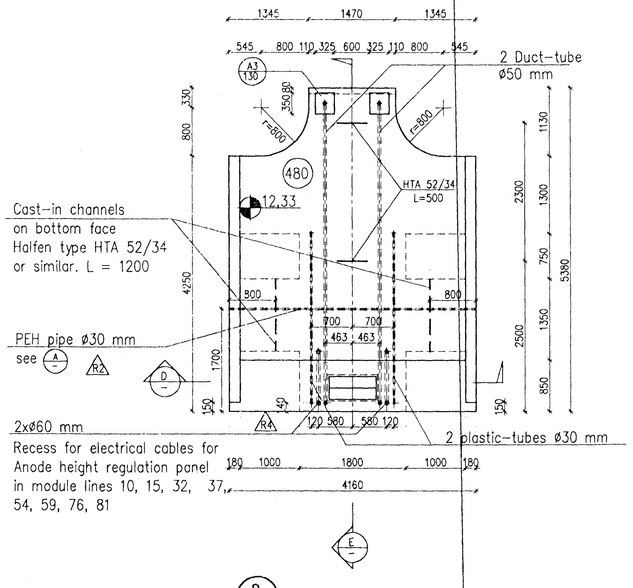

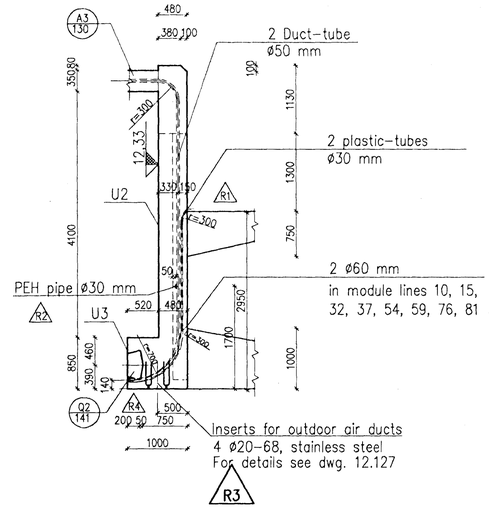

A

B

D

HAFNARFJÖRÐUR
BYGGINGARFULLTRÚI
AFGREITT 28/3 '96

CONCRETE: C30/37-38-S2

1:50

1000 0 1000 2000 3000 4000 5000 mm

REV. NO.	DATE	REVISION	BY	APP.
4	1996.03.25	LOCATION OF TUBS, MINOR REVISION	NI	N.I.
3	1996.02.14	NEW INSERTS, PLACEMENT, SIZE & TYPE	KGS	N.I.
2	1996.01.25	EMBEDDED PIPES	FGS	N.I.
1	1996.01.02	APPROVED FOR CONSTRUCTION	FGS	N.I.

NOTES

REFERENCE DRAWING

DRAWING NUMBER

This drawing is our property and given for personal use only. It may not be copied or made available to others without our permission. The receiver is responsible for any misuse.

VST CONSULTING ENGINEERS Ltd.
Armula 4 108 Reykjavik Iceland
Tel:+354 569 5000 Fax:+354 569 5010

95.120 – 12.122

ICELANDIC ALUMINIUM COMPANY LTD.

DRAWN	95.10.28	FGS	POTROOM NO. 3
APPROVED	95.10.28	KGS	CONCRETE WORK
PROCESS	95.10.28	NI	TABLE T1 & T3
PROJECT	95.10.28	NI	FORMWORK
SCALE	1:50	FORMAT A1	

ALUSUISSE ALESA — ALUSUISSE ENGINEERING LTD. ZURICH SWITZERLAND — 79000-32322 — REVISION 4

ISAL — ICELANDIC ALUMINIUM CO. LTD — 186.622

07-NOV-1995 I:\{95-1XX}\95120\DWG\DWG-C\AL-C122.DWG