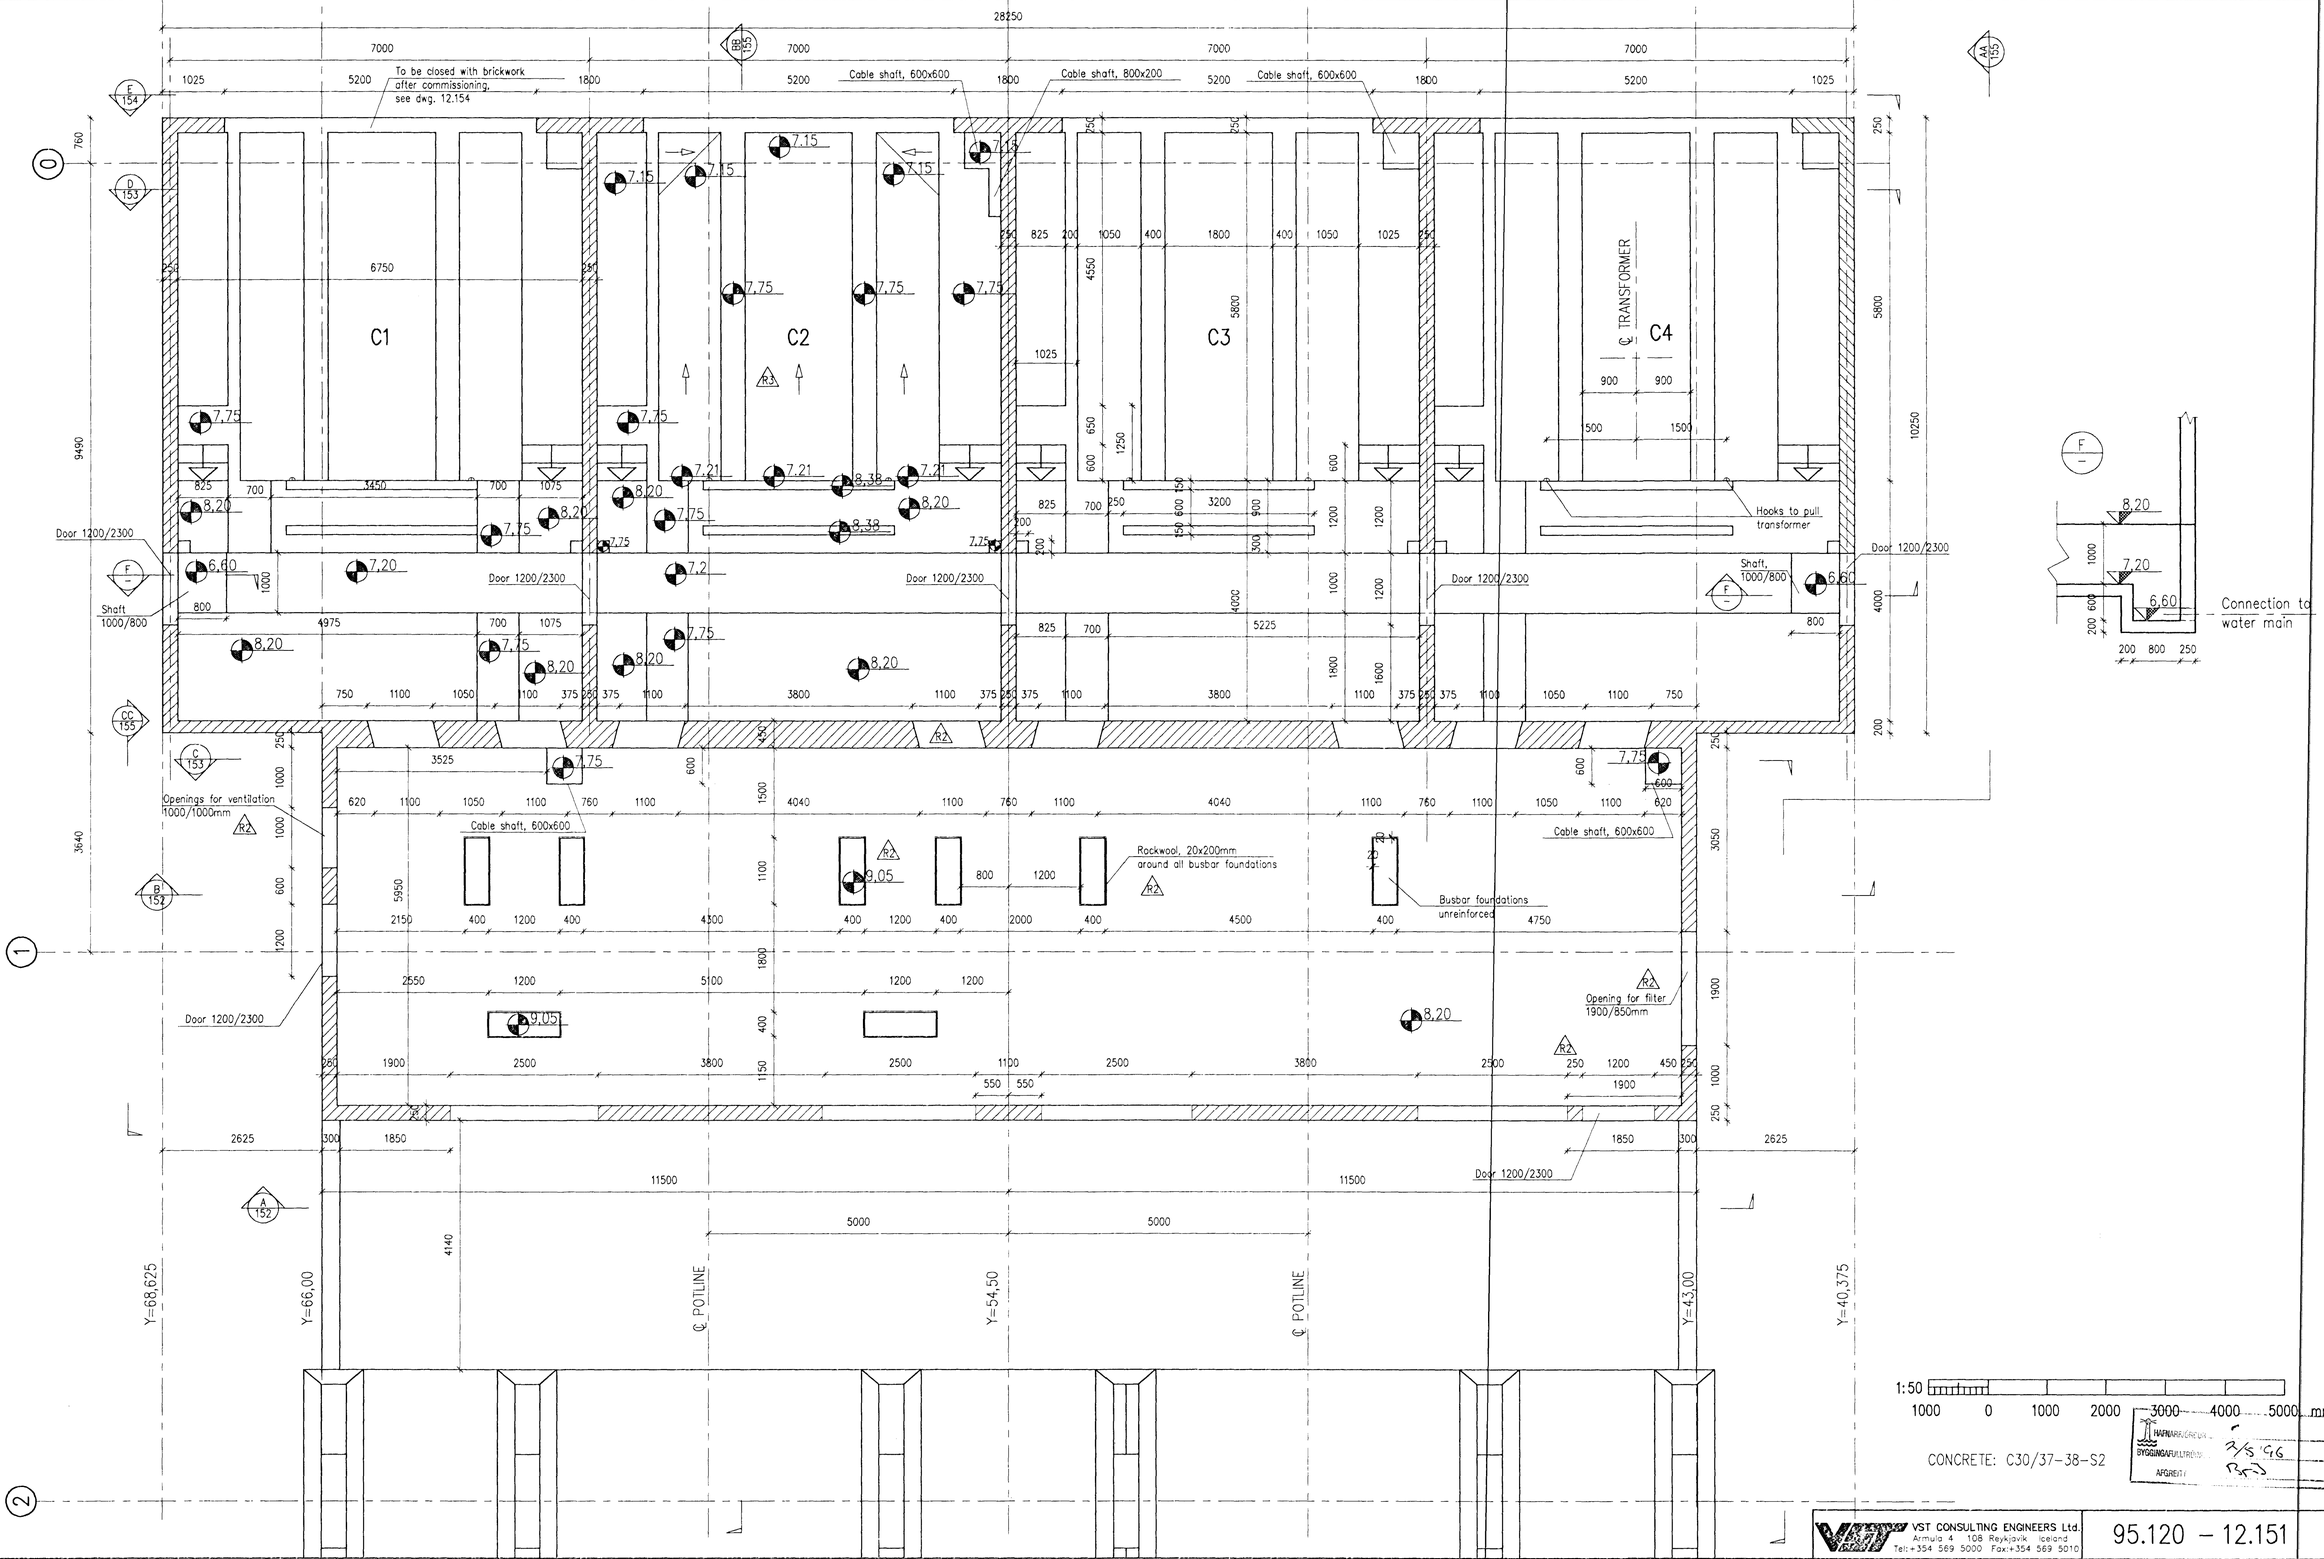

REV. NO.	DATE	REVISION	BY	APP.
3	1996.04.26	SLOPE	FGS	N.I.
2	1996.04.23	CABLE SHAFT, BUSBAR FOUNDATIONS, OPENINGS.	FGS	N.I.
1	1996.03.25	APPROVED FOR CONSTRUCTION	FGS	N.I.

REV. NO.	DATE	REVISION	BY	APP.

NOTES

REFERENCE DRAWING

DRAWING NUMBER

This drawing is our property and given for personal use only. It may not be copied or made available to others without our permission. The receiver is responsible for any misuse.

VST CONSULTING ENGINEERS Ltd.
Armula 4 108 Reykjavik Iceland
Tel:+354 569 5000 Fax:+354 569 5010

95.120 – 12.151

ICELANDIC ALUMINIUM COMPANY LTD.

DRAWN	95.10.28	FGS	
APPROVED	95.10.28	KGS	
PROCESS	95.10.28	NI	
PROJECT	95.10.28	NI	
SCALE	1:50	FORMAT	A1

RECTIFIER NO. 3
CONCRETE WORK
FOUNDATIONS, PLAN
FORMWORK

ALUSUISSE ALESA
ALESA
ALUSUISSE ENGINEERING LTD.
ZURICH SWITZERLAND

79000–32351

REVISION 3

ISAL
ICELANDIC ALUMINIUM CO. LTD

186.651

07-NOV-1995 I:\{95-1XX}\95120\DWG\DWG-C\AL-C151.DWG