TABLE T1 80 PIECES

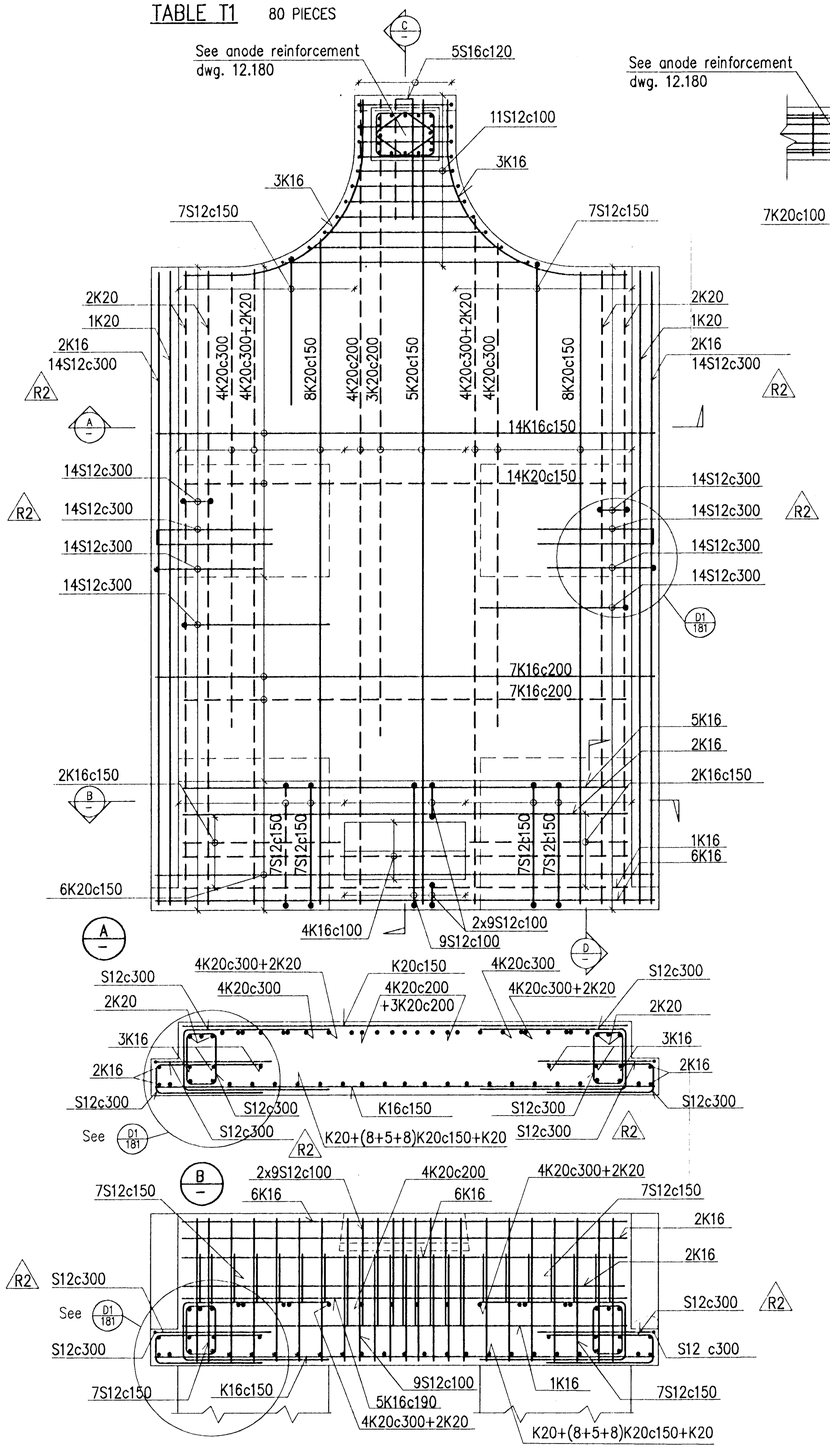

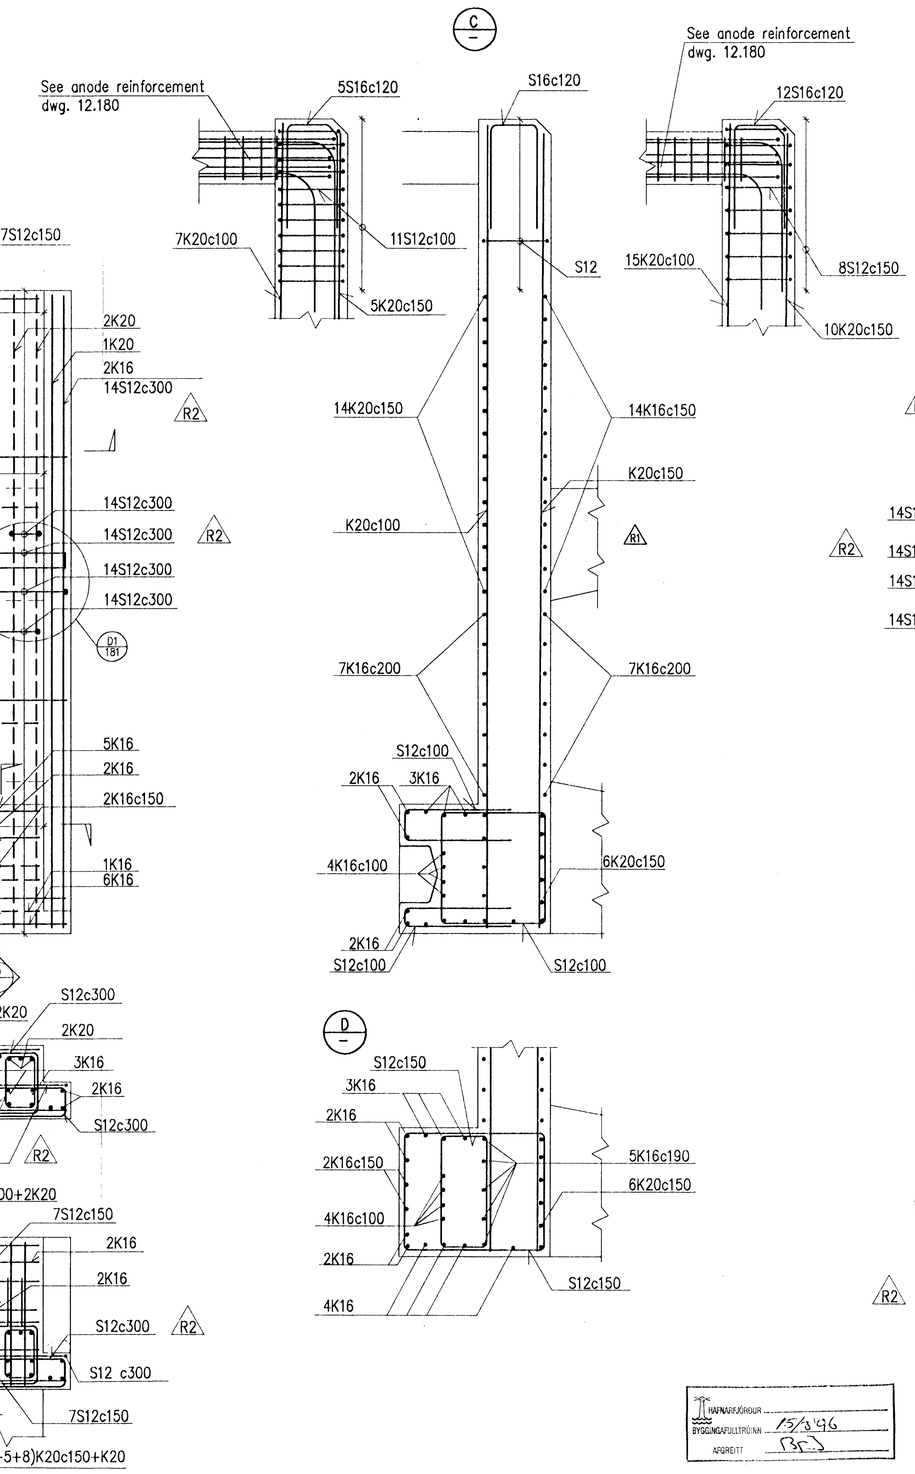

TABLE T3 64 PIECES

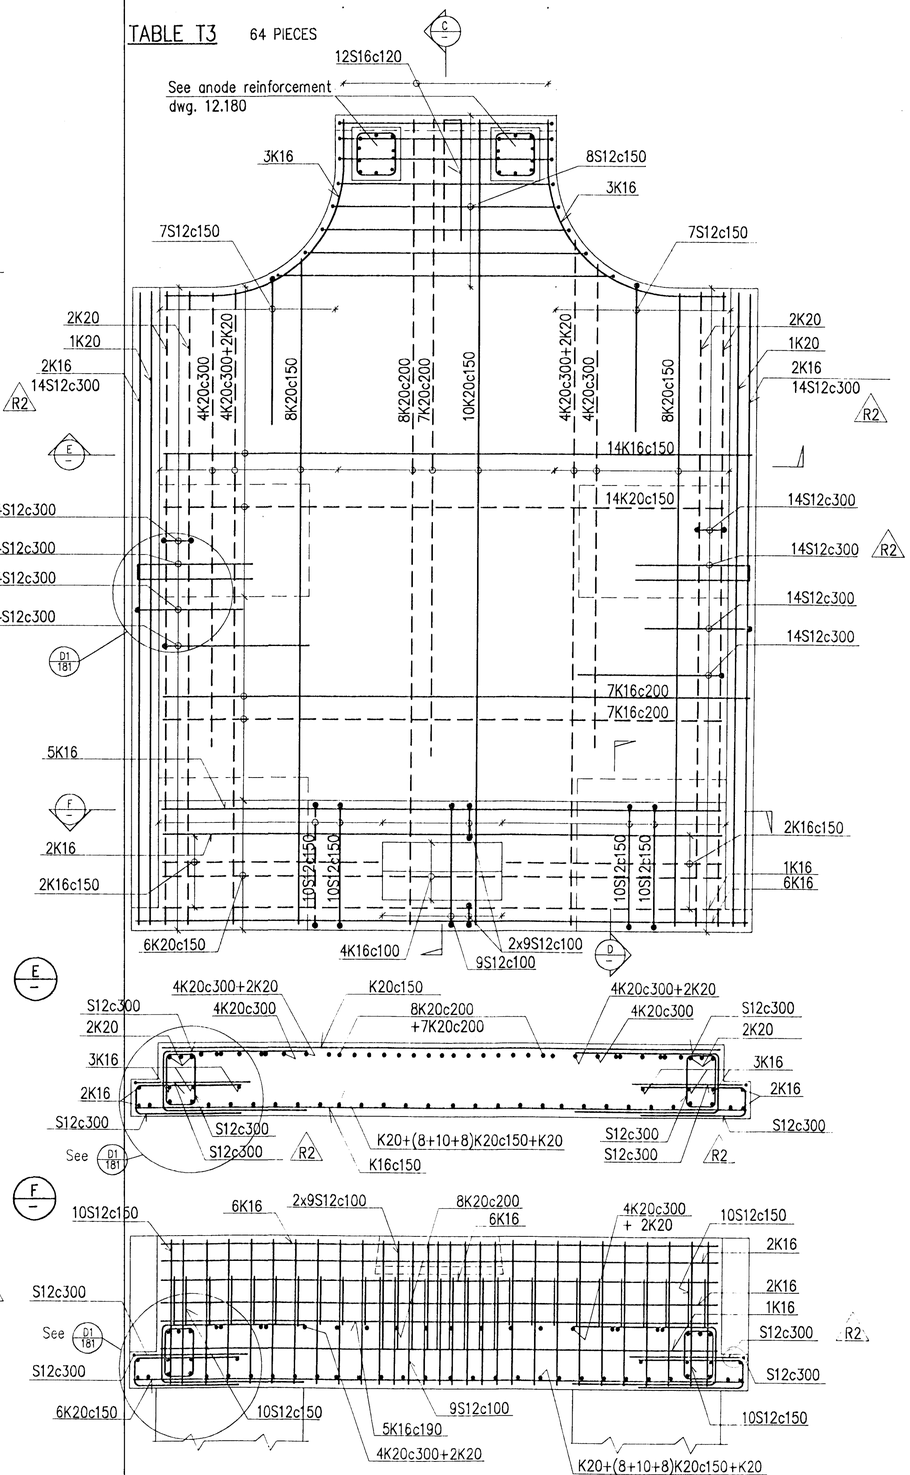

HAFNARFJÖRÐUR
BYGGINGAFULLTRÚINN 15/3 '96
AFGREITT BC

1:20
1000 0 1000 2000 mm

REV. NO.	DATE	REVISION	BY	APP.
2	1996.03.15.	Reinforcement in Corbel	KGS	N.I.
1	1996.01.02	APPROVED FOR CONSTRUCTION	FGS	N.I.

NOTES

REFERENCE DRAWING

DRAWING NUMBER

This drawing is our property and given for personal use only. It may not be copied or made available to others without our permission. The receiver is responsible for any misuse

VST CONSULTING ENGINEERS Ltd.
Ármúla 4 108 Reykjavík Iceland
Tel:+354 569 5000 Fax:+354 562 5010

95.120 – 12.172

ICELANDIC ALUMINIUM COMPANY LTD.

DRAWN	95.10.28	FGS
APPROVED	95.10.28	KGS
PROCESS	95.10.28	NI
PROJECT	95.10.28	NI
SCALE	1:20	FORMAT A1

POTROOM NO. 3
CONCRETE WORK
TABLE T1 & T3
REINFORCEMENT

ALUSUISSE ALESA
ALUSUISSE ENGINEERING LTD. ZURICH SWITZERLAND

ISAL
ICELANDIC ALUMINIUM CO. LTD

79000–32372 REVISION 2

186.672

07-NOV-1995 I:\[95-1XX]\95120\DWG\DWG-C\AL-C172.DWG