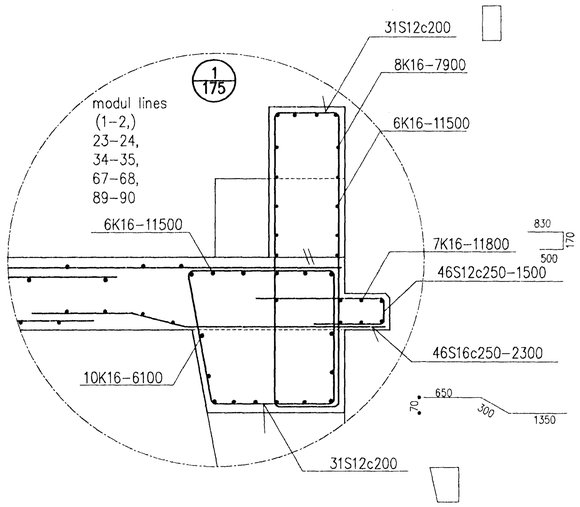

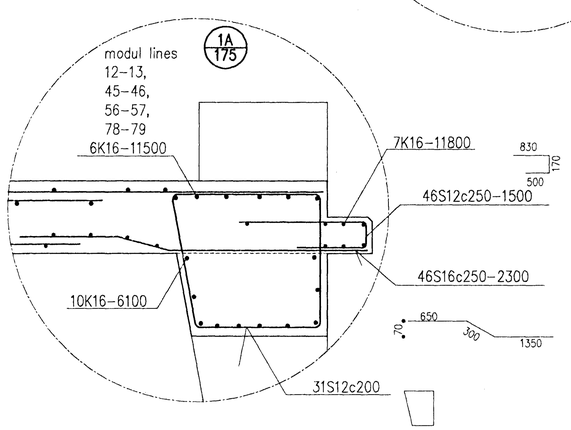

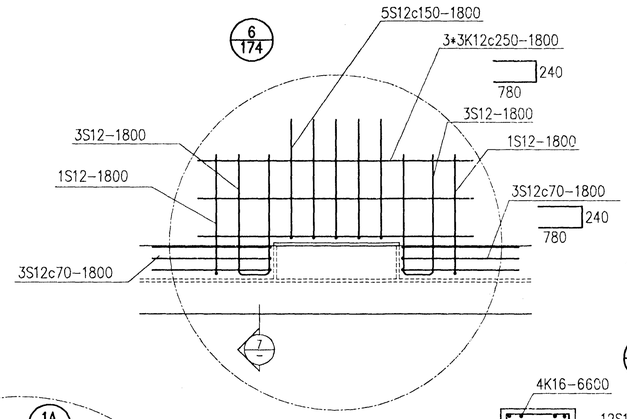

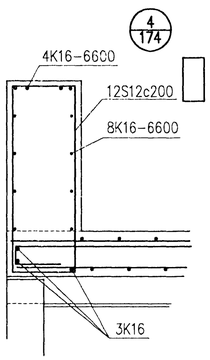

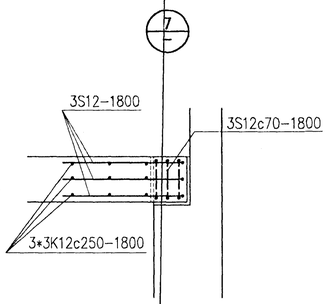

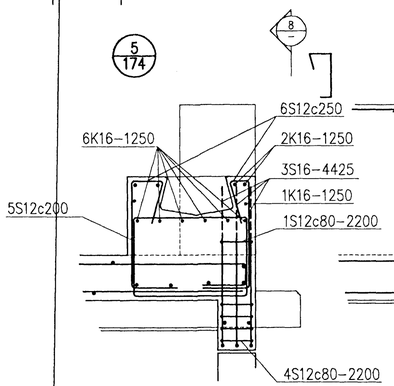

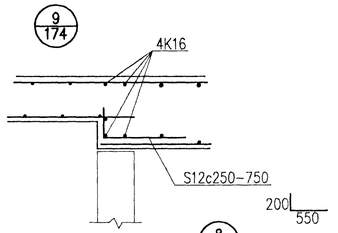

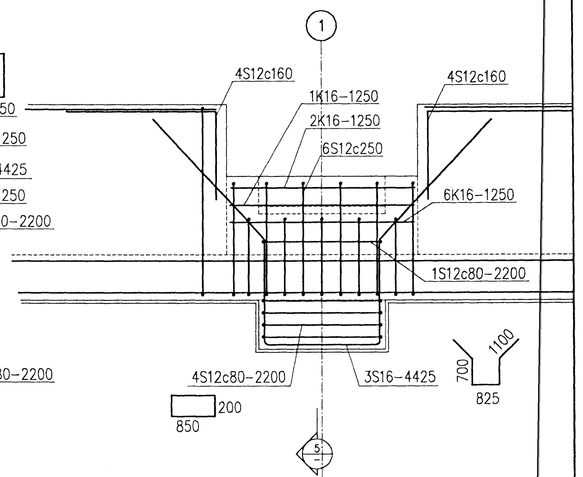

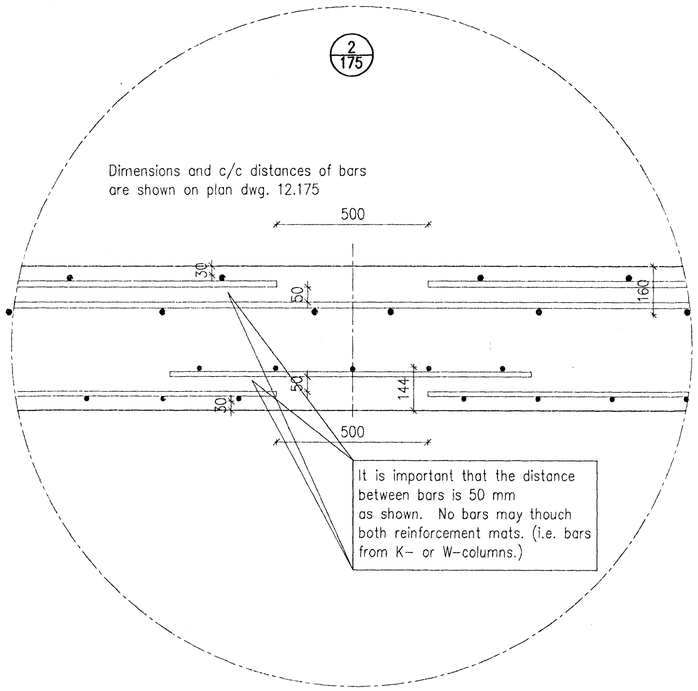

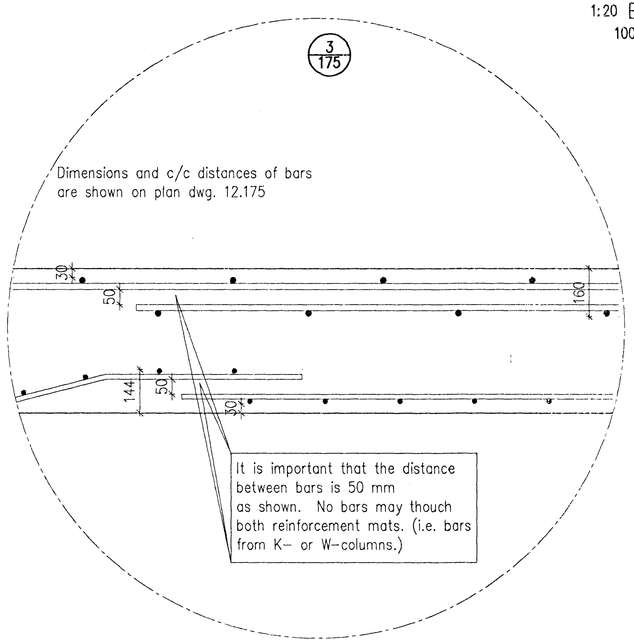

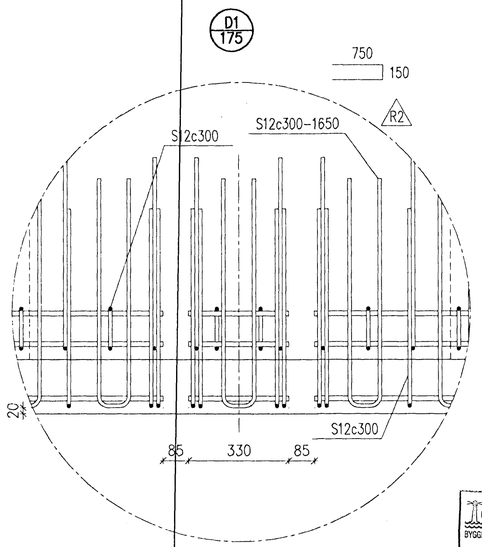

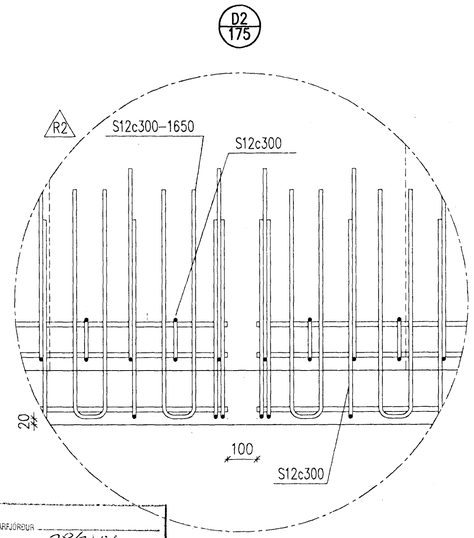

1:20
1000 0 1000 2000 mm

1:10
100 0 200 400 600 800 1000 mm

HAFNARFJÖRÐUR
BYGGINGAFULLTRÚINN 28/3'96
AÐGREITT

REV. NO.	DATE	REVISION	BY	APP.	REV. NO.	DATE	REVISION	BY	APP.
3	1996.03.25	GENERAL REVISION	KGS	N.I.					
2	1996.03.15.	REINFORCEMENT IN CORBEL	KGS	N.I.					
1	1996.01.02	APPROVED FOR CONSTRUCTION	KGS	N.I.					

NOTES

REFERENCE DRAWING

DRAWING NUMBER

This drawing is our property and given for personal use only. It may not be copied or made available to others without our permission. The receiver is responsible for any misuse.

VST CONSULTING ENGINEERS Ltd.
Armula 4 108 Reykjavik Iceland
Tel:+354 569 5000 Fax:+354 569 5010

95.120 – 12.176

ICELANDIC ALUMINIUM COMPANY LTD.

DRAWN	95.12.15	KGS	
APPROVED	95.12.15	KGS	
PROCESS	95.12.15	NI	
PROJECT	95.12.15	NI	
SCALE	1:20	FORMAT A1	

POTROOM NO. 3
CONCRETE WORK
TABLE T5 & T9, DETAILS
REINFORCEMENT

ALUSUISSE ALESA
ALUSUISSE ENGINEERING LTD. ZURICH SWITZERLAND

79000–32376

REVISION 3

ISAL
ICELANDIC ALUMINIUM CO. LTD

186.676

15–DEC–1995 I:\[95–1XX]\95120\DWG\DWG–C\AL–C176.DWG