




SIDE VIEW, EAST WALL

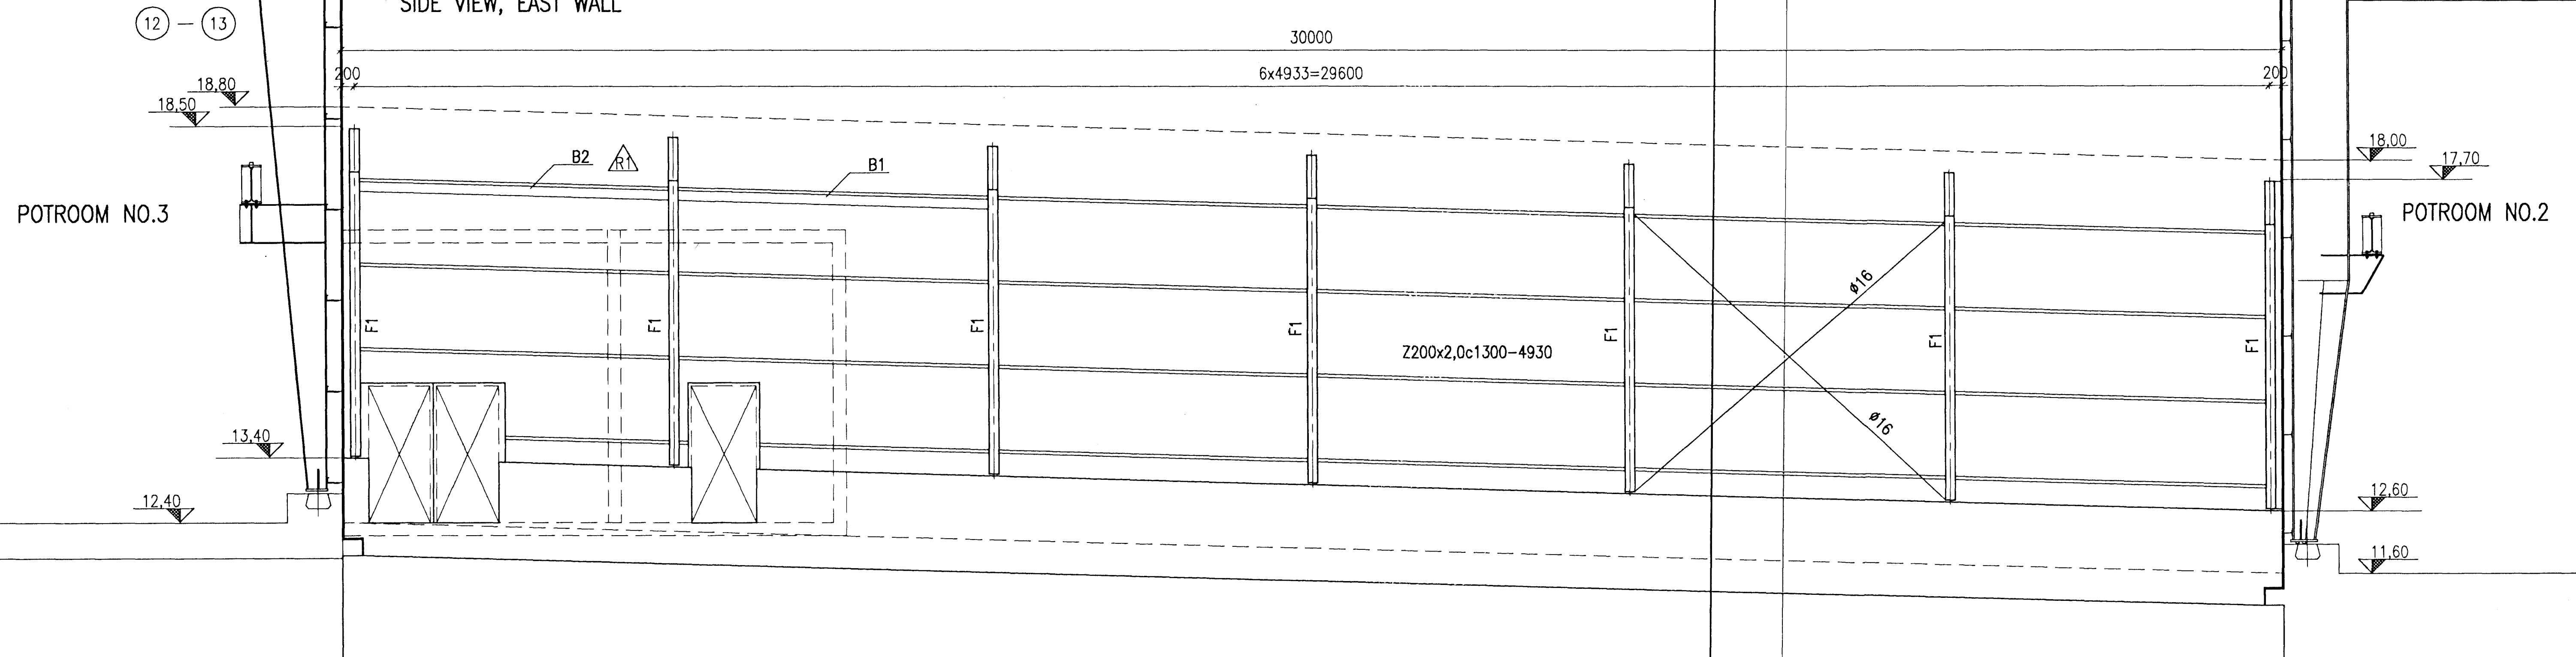

PLAN VIEW, ROOF

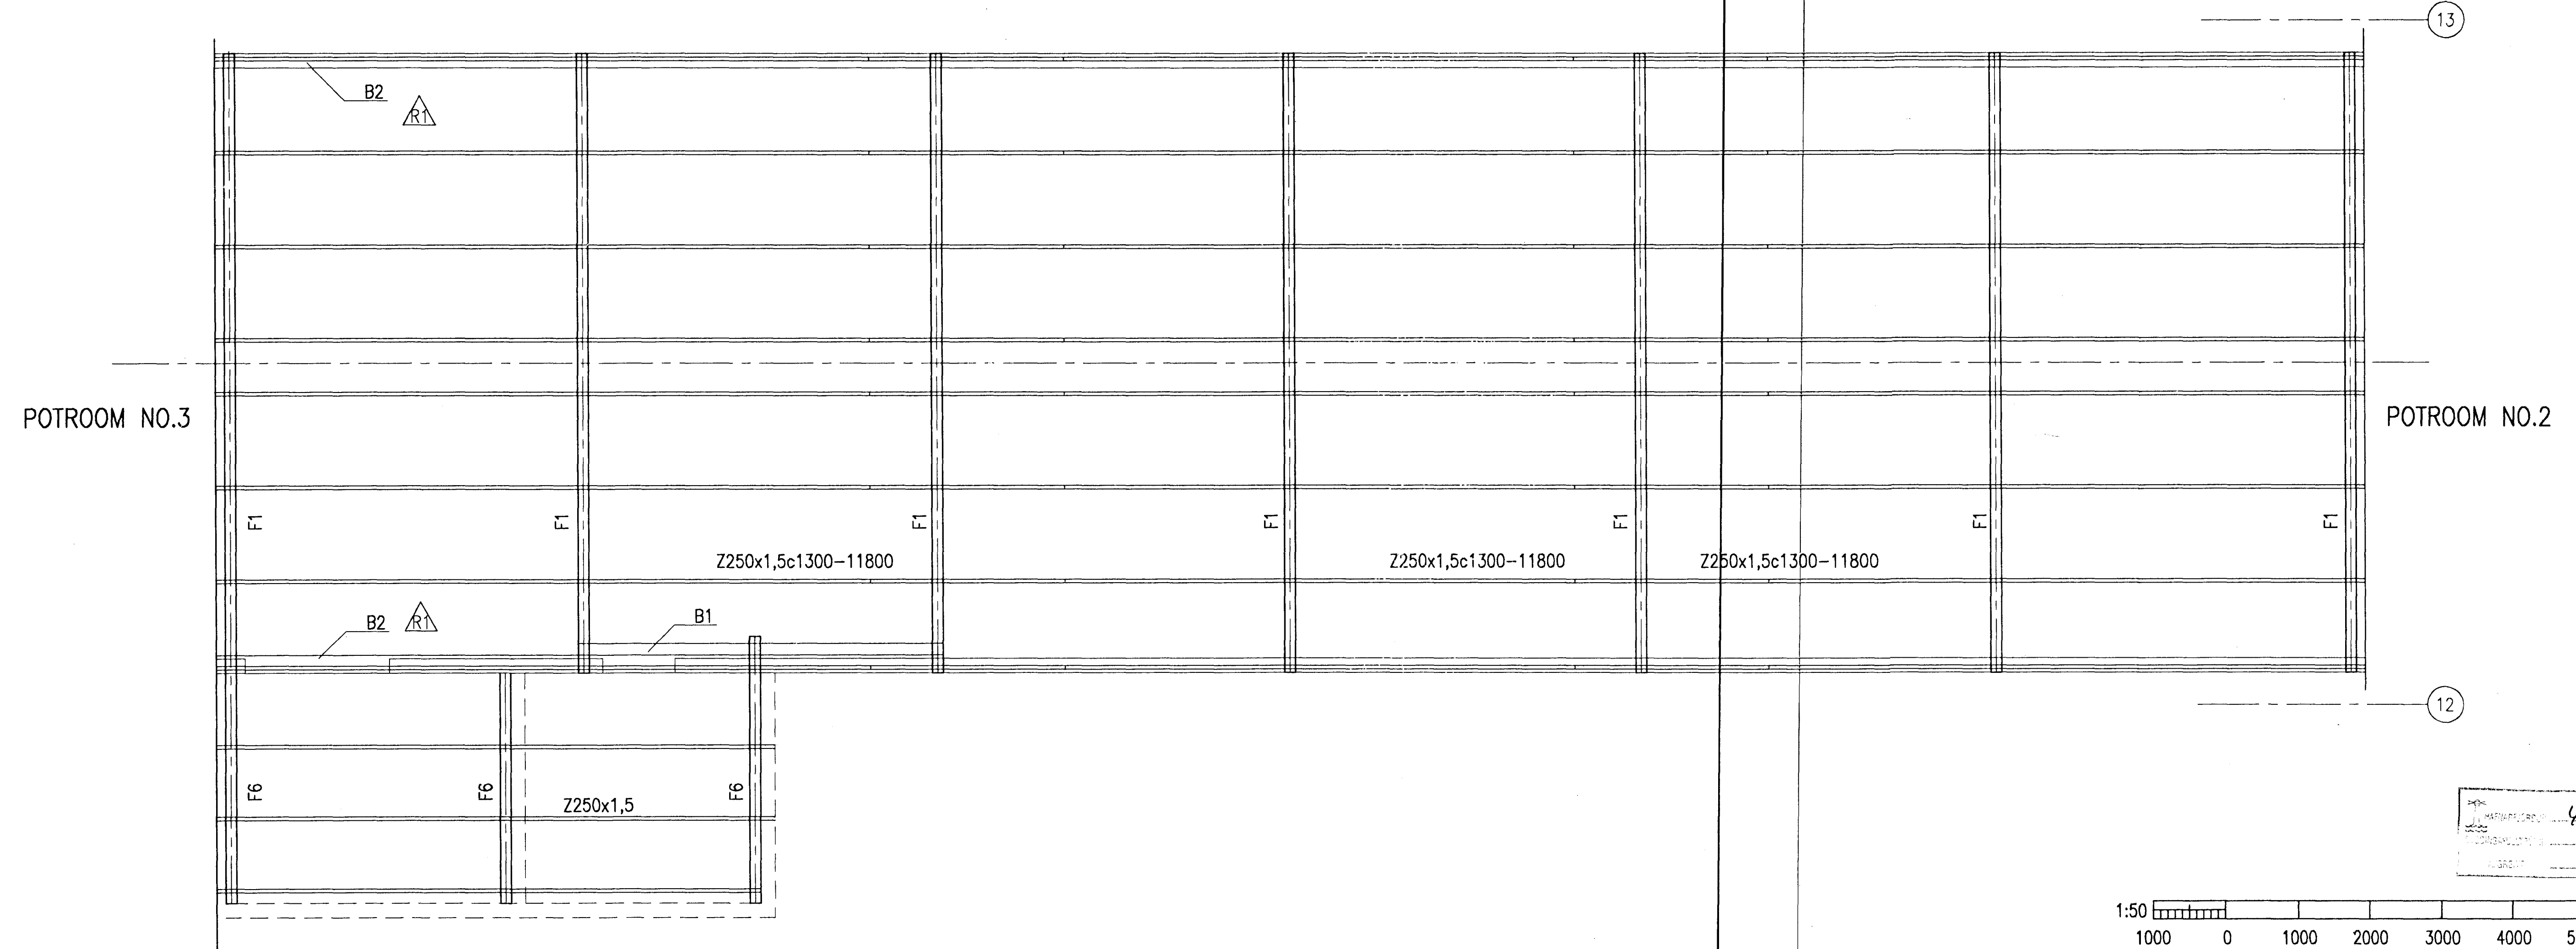

DATE: 4-12-97
 DRAWN BY: LP

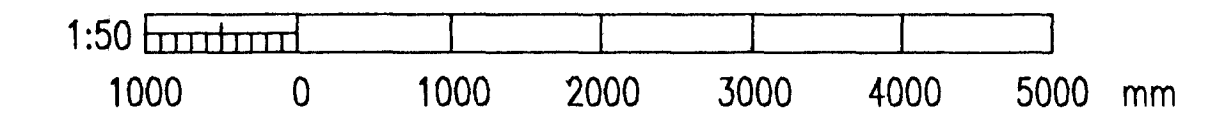

VST CONSULTING ENGINEERS Ltd. Armula 4 108 Reykjavik Iceland Tel:+354 569 5000 Fax:+354 569 5010		95.120 - 28.152
ICELANDIC ALUMINIUM COMPANY LTD.	DRAWN 96.07.10 SGI APPROVED 96.07.10 NI PROCESS 96.07.10 NI PROJECT 96.07.10 NI SCALE 1:50	PASSAGEWAY BUILDINGS STRUCTURAL STEEL BUILDING 12-13 SIDE AND PLAN VIEW
ALUSUISSE ENGINEERING LTD. ZURICH SWITZERLAND	79000-35252	REVISION 1
ICELANDIC ALUMINIUM CO. LTD.	188.252	

REV. NO.	DATE	REVISION	BY	APP.	REV. NO.	DATE	REVISION	BY	APP.	NOTES	REFERENCE DRAWING	DRAWING NUMBER
1	1996.08.22	APPROVED FOR CONSTRUCTION	NI	N.L.								

This drawing is our property and given for personal use only. It may not be copied or made available to others without our permission. The receiver is responsible for any misuse.