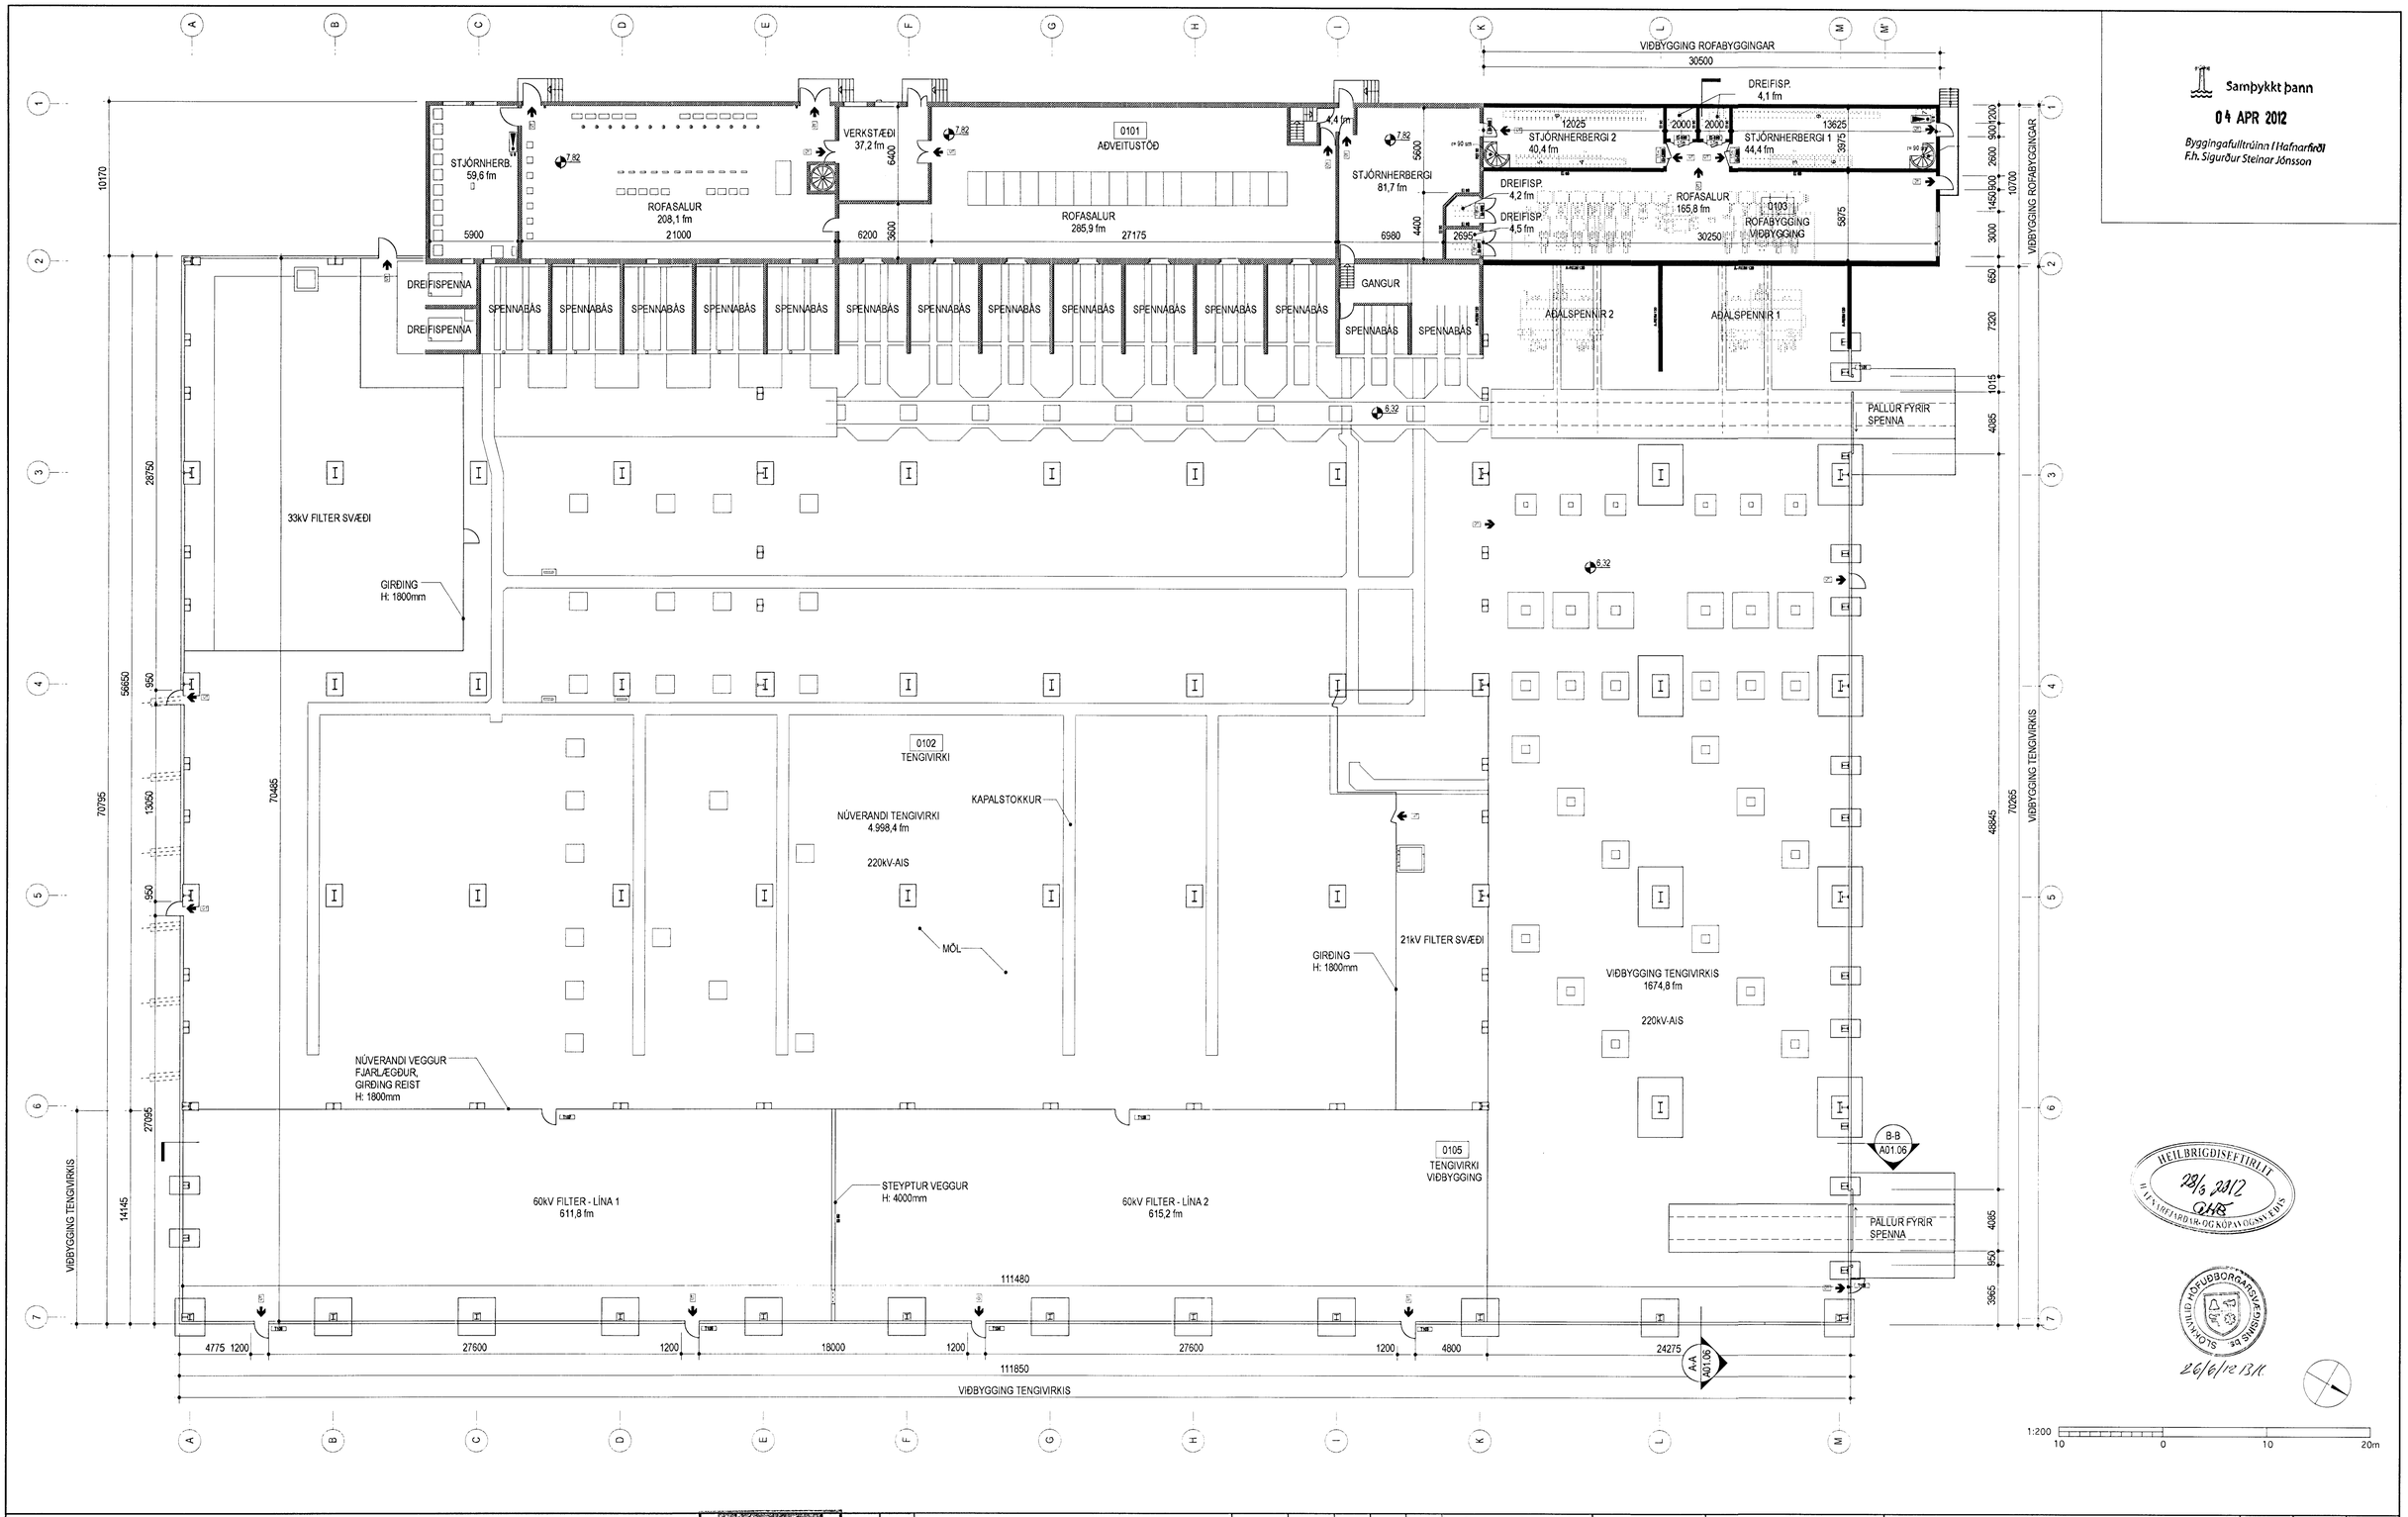

Samþykkt þann
04 APR 2012
Byggingafulltrúinn í Hafnarfirði
F.h. Sigurður Steinar Jónsson

HEILBRIGDISEFTIRLIT
28/3 2012
HAFNARFJARÐAR- OG KÓPAVOGSSVÆÐIS

SLÖKKVILIÐ HÖFUÐBORGARSVÆÐISINS bs.
26/6/12 13.11.

Skýringar:
Legend:

C:\Users\lilja\Desktop\As built teikningahaus.dwg

GLÁMA·KÍM
Arkitektar Lauganegi 104 ehf. 105 Reykjavík
Arni Kjartansson kt. 240332-2009
Bjarni B. Jónsson kt. 220334-5019
Sigurður Kjartansson kt. 120357-2009
Sigurður Helgason kt. 100357-2009

Útg nr Rev no	Lýsing Description	Dagsetning Date	Hann/Tkn Des/Drw	Yfirf Ckd	Notk heim Suppl Rel	Notk heim ISAL Rel
A1	Leiðr. hurðir og merkingar.	20.06.2012	ÓM	SK		
A	As Built	03.03.2012	SK	SK		

This drawing is the property of Rio Tinto Alcan Iceland Ltd. and handed out for personal use only It may neither be copied nor made available to others without permission of Rio Tinto Alcan Iceland Ltd. The receiver is liable for any misuse.

Stærð: Format: A1 Mkv.: Scale: 1:200
Dimensions without tolerances according to ISO 2768-1 medium.

HRV & HATCH JOINT VENTURE ISAL PRODUCTION UPGRADE
GLÁMA·KÍM
Arkitektar Lauganegi 104 ehf. 105 Reykjavík
s. 530 6100, f. 530 6101, kt. 540 496 2738
glamakim@glamakim.is www.glamakim.is

Dagsetning / Date: 30.09.2008
Hannað / Designed: SK
Teikn / Drawn: EHF/ÓM/SK
Verktaki / Supplier: GLÁMA·KÍM
Teikn.nr.verktaka / Supplier drw.no: A01.03
Samþykkt / Approved
Yfirf / Chkd: SK
Hluti af: / Part of:

ROFABYGGING OG TENGIVIRKI
GRUNNMYND JARÐHÆÐAR

Teg.teikningar / Dwg. type: AÐALUPPDRÁTTUR
Architectural: Building Application

Rio Tinto Alcan
ISAL Alcan Iceland Ltd Straumsvik IS-222 Hafnarfjörður Iceland

Flokkur nr.: | Blað nr.: | Næsta bl.nr.:
Kostn.nr.-Cono. / Bún.nr.-Eq.no: 4011 01188
AKS: UB01
Teikn.nr. ISAL /Drw.no. of ISAL: 250387
Breyt./Rev: A

ISAL Yfirfarið og skráð, dags / ISAL Checked, date
ISAL Samþykkt, dags / ISAL Approval, date