





Samþykkt þann
 04 APR 2012
 Byggingafráunni / Hafnarfrófi
 Fh. Sigurður Steinar Jónsson

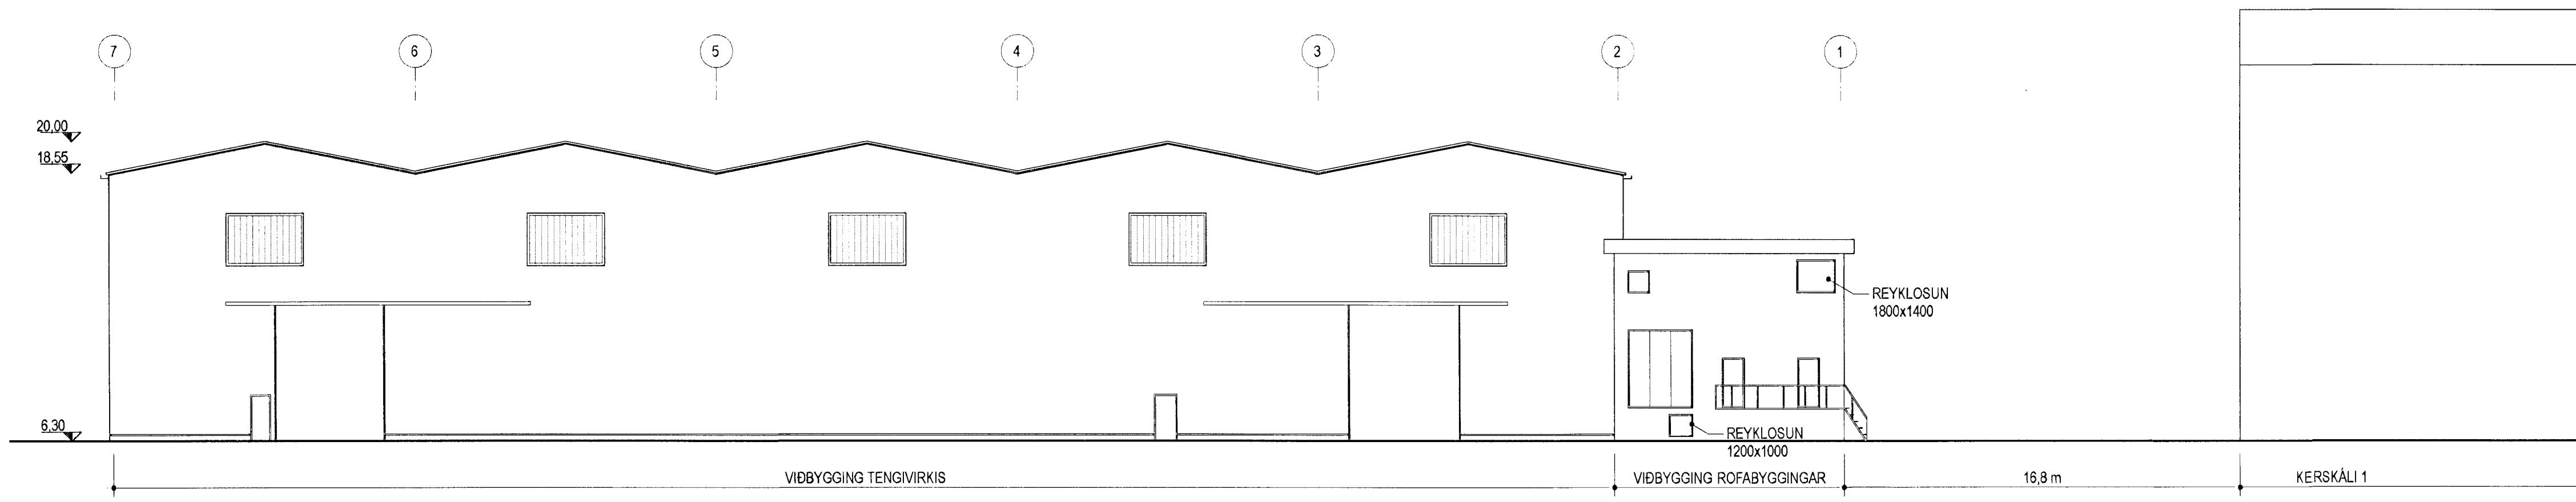

1 ÚTLIT - NORÐUR
 m.kv. 1:200

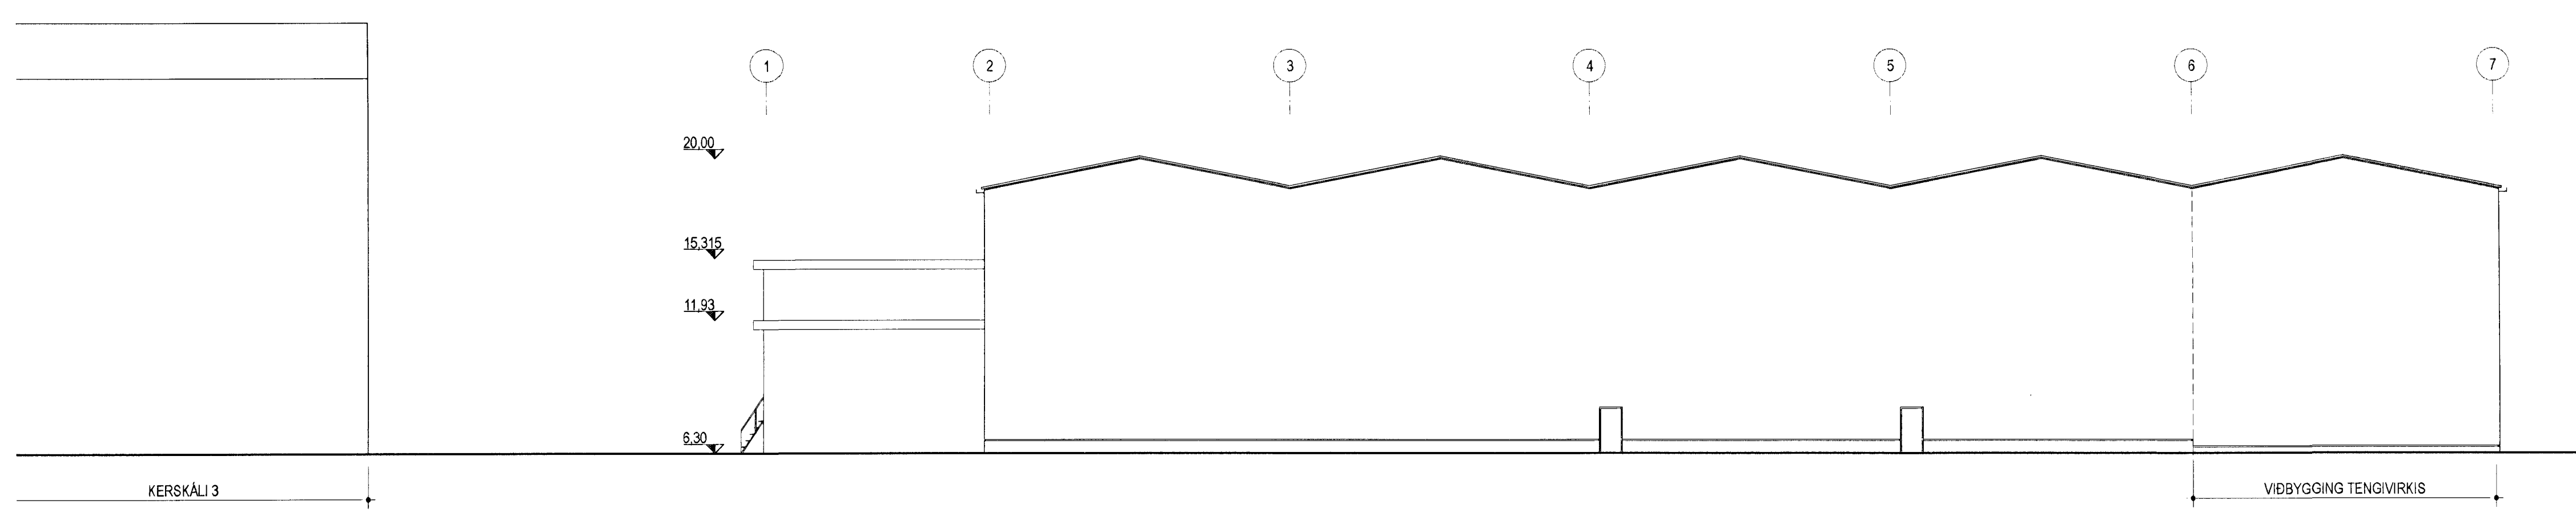

2 ÚTLIT - SUÐUR
 m.kv. 1:200

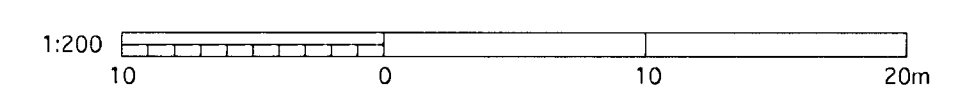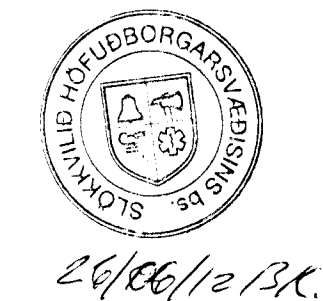

Skýringar:
 Legend:

Handwritten notes and signatures in a small box, including names like 'Sigurður Steinar Jónsson' and 'Eg. Halldórsson'.

Útg nr / Rev no	Lýsing / Description	Dagsetning / Date	Höfundur / Des/Draw	Yfir / Chkd	Notk heim / Suppl Ref	Notk heim / ISAL Ref
A1	Leiðir, hurðir og merkingar.	20.06.2012	ÓM	SK		
A	Ás Built	03.03.2012	SK	SK		

This drawing is the property of Rio Tinto Alcan Iceland Ltd. and handed out for personal use only. It may neither be copied nor made available to others without permission of Rio Tinto Alcan Iceland Ltd. The receiver is liable for any misuse.

Stærð: A1
 Formát: A1
 Miki: 1:200
 Scale: 1:200

Dimensions without tolerances according to ISO 2768-1 medium.

Logos for HRVA HATCH and GLÁMA-KÍM.

Dagsetning / Date: 30.09.2008	Hannað / Designed: SK	Teikn / Drawn: EHFJÓMSK	Verktaki / Supplier: GLÁMA-KÍM	Teikn nr. verktaka / Supplier drwno: A01.05	Samþykkt / Approved: Yfir / Chkd: SK	Húsi af / Part of:
ROFABYGGING OG TENGIVIRKI ÚTLIT				Teg. teikningar / Dwg. type: ADALUPPDRÁTUR / Architectural Building Application		Flokkur nr.: 4011
Rio Tinto Alcan				Teikn nr. ISAL / Drw. no. of ISAL: 250389		Næsta bl. nr.: 01188
ISAL Yfirtalir og skráð, dags / ISAL Checked, date				ISAL Samþykkt, dags / ISAL Approval, date		