


LEGEND

Elevations are in metres in Hafnarfjordur height system.
Coordinates x,y are in metres in a local coordinate system.

● XX.XX/YY.YY XX.XX = Bottom of excavation
 YY.YY = Elevation on compacted fill

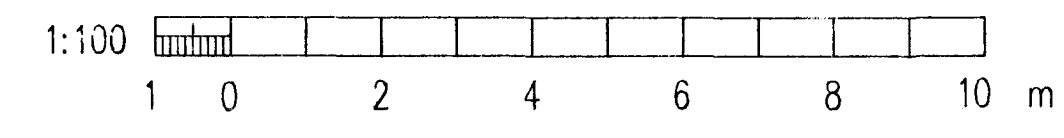

4-12-97
CP

REV. NO.	DATE	REVISION	BY	APP.	REV. NO.	DATE	REVISION	BY	APP.	NOTES	REFERENCE DRAWING	DRAWING NUMBER
1	07.06.96	Changed location of excav. f. Sub120	QSS	QSS								

This drawing is our property and given for personal use only. It may not be copied or made available to others without our permission. The receiver is responsible for any misuse.

VST CONSULTING ENGINEERS Ltd. Arnúla 4 108 Reykjavík Iceland Tel: +354 569 5000 Fax: +354 569 5010		95.120 - 26.101	
ICELANDIC ALUMINIUM COMPANY LTD.		DRAWN 1996.05.15 QSS APPROVED 1996.05.15 QSS PROCESS 1996.05.15 NI PROJECT 1996.05.15 NI SCALE 1:100 FORMAT A1	SUBSTATION 120 EARTHWORK EXCAVATION PLAN, SUBSTATION 120/DAP
ALUSUISSE ENGINEERING LTD. ZÜRICH SWITZERLAND		79000-35.401	1
ICELANDIC ALUMINIUM CO. LTD		188.401	