

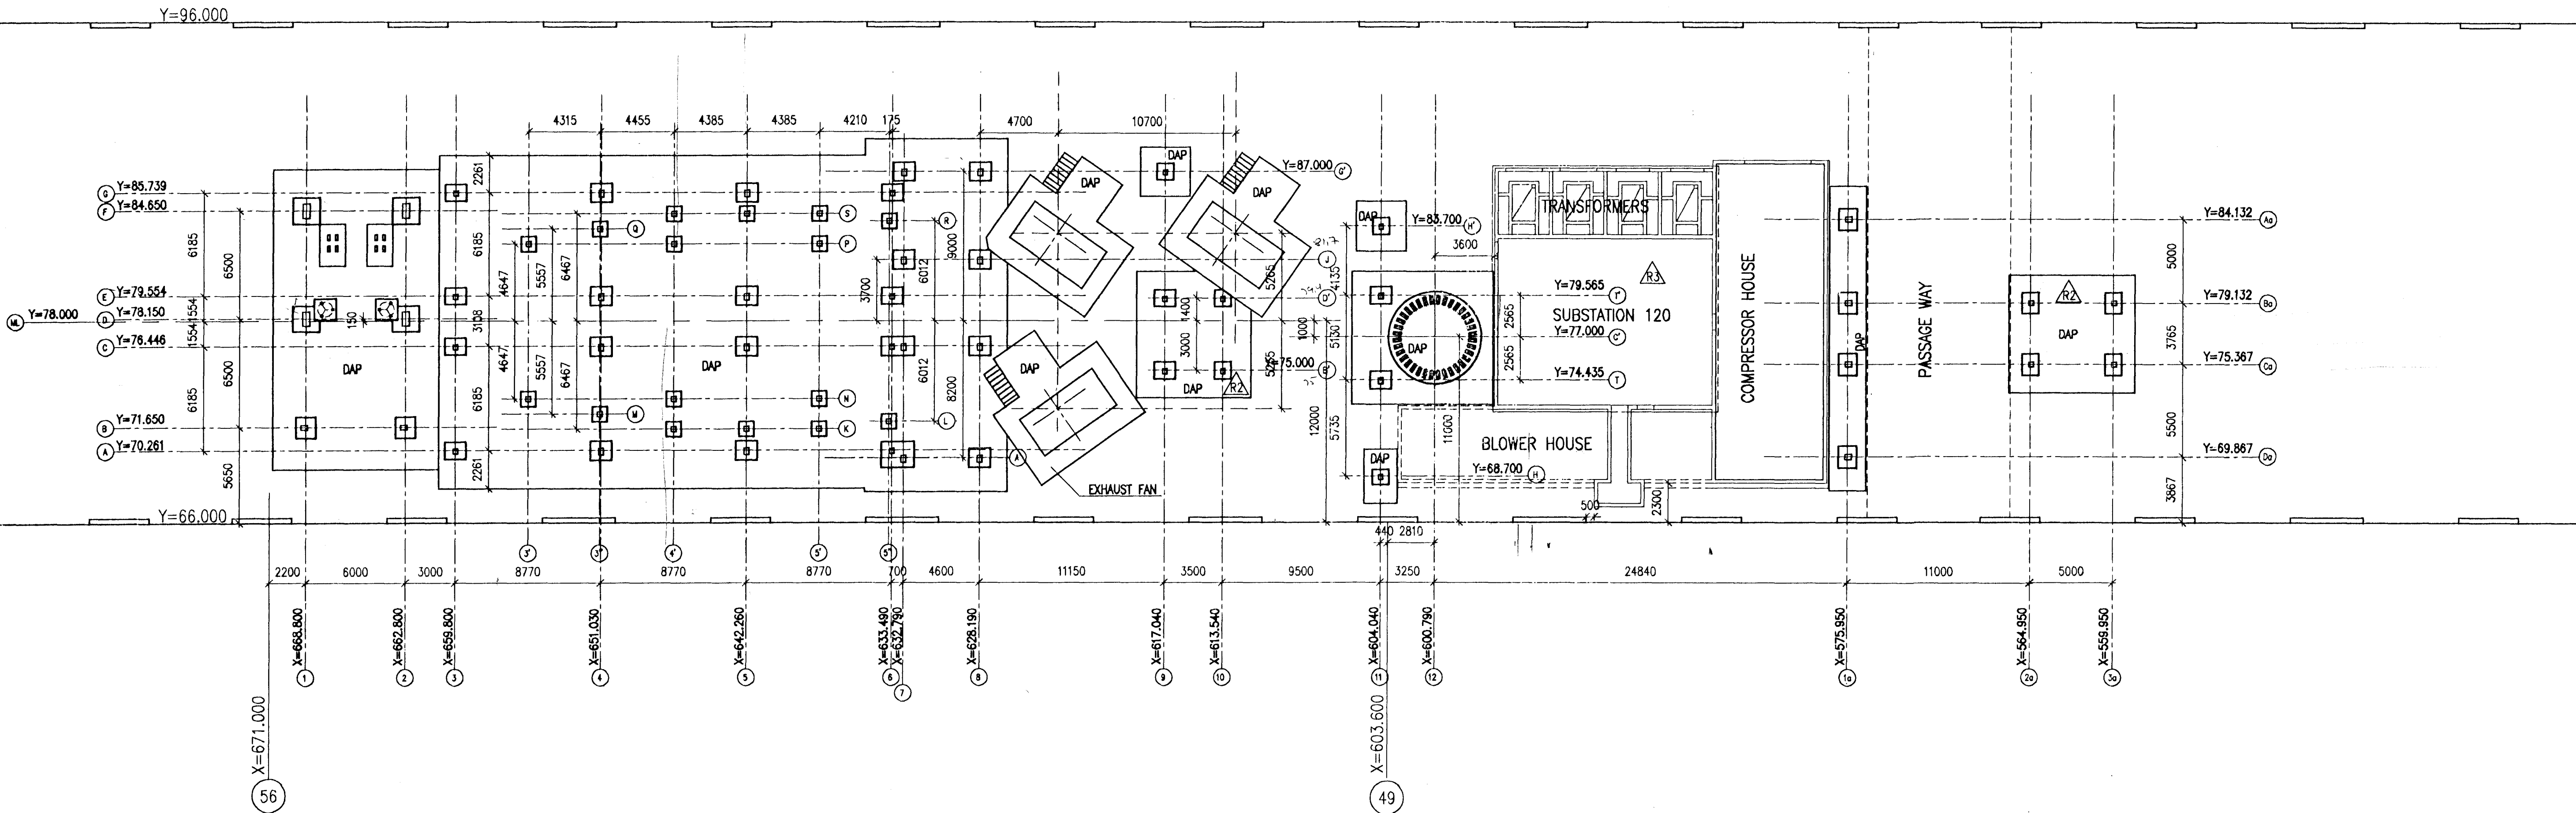


POTROOM 2

POTROOM 3

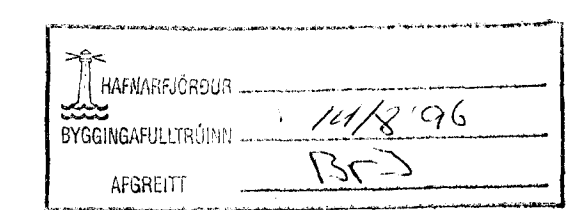

*H = 596
1000.000
H = 596.412m*

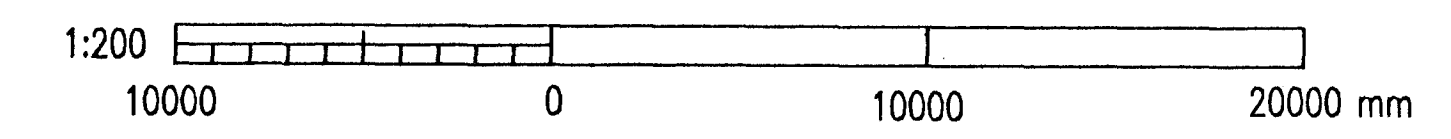

REV. NO.	DATE	REVISION	BY	APP.	REV. NO.	DATE	REVISION	BY	APP.	NOTES	REFERENCE DRAWING	DRAWING NUMBER
3	1996.08.09	COORDINATE CORRECTED FOR MODULE LINE 1.	FGS	N.I.								
2	1996.07.24	SLAB MOD. 9-10, 2a-3a	FGS	N.I.								
1	1996.07.18	APPROVED FOR CONSTRUCTION	FGS	N.I.								

This drawing is our property and given for personal use only. It may not be copied or made available to others without our permission. The receiver is responsible for any misuse.

VST CONSULTING ENGINEERS Ltd. Armula 4 108 Reykjavik Iceland Tel: +354 569 5000 Fax: +354 569 5010	DRAWN 96.05.15 FGS APPROVED 96.05.15 QSS PROCESS 96.05.15 NI PROJECT 96.05.15 NI	95.120 - 28.012 DRY ADSORPTION PLANT CONCRETE WORK GENERAL LAYOUT FORMWORK
	SCALE 1:200 FORWART AT	ALUSUISSE ENGINEERING LTD. ZURICH SWITZERLAND
ICELANDIC ALUMINIUM CO. LTD	192.812	3