Format A1 (841x594 mm) is 20 mm outside of this frame

A Mynd
045048 M 1:10

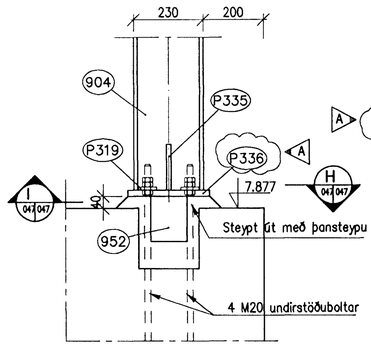

H Snið
048048 M 1:100

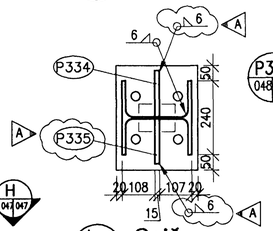

I Snið
048048 M 1:100

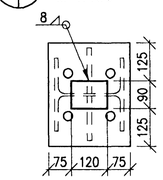

B Mynd
045048 M 1:10

P334 PL 214.149...15
048048 M 1:10

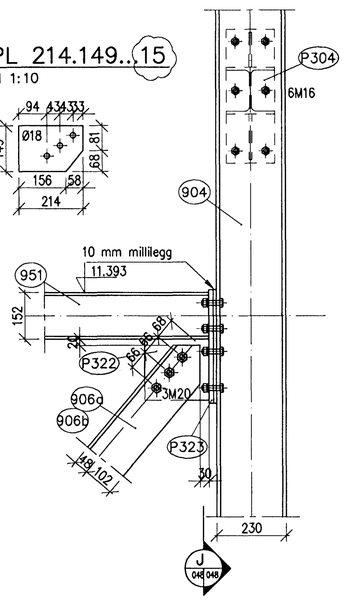

P322 PL 213.200...20
048048 M 1:10

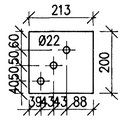

P323 PL 373.180...15
048048 M 1:10

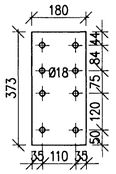

J Snið
048048 M 1:100

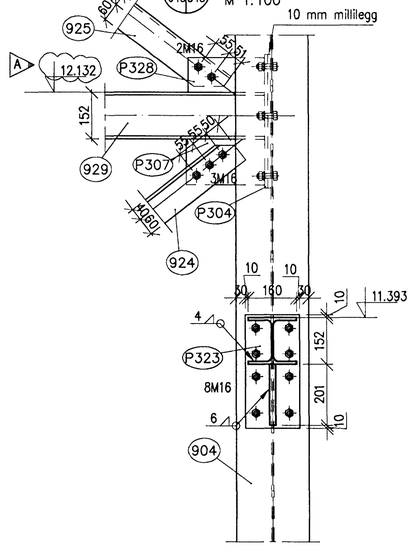

F Mynd
045048 M 1:10

C Mynd
045048 M 1:10

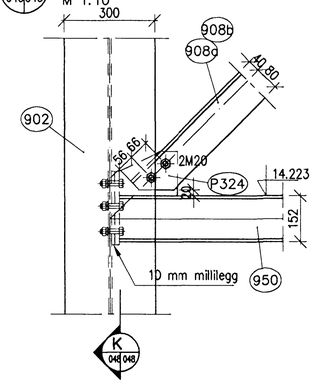

K Snið
048048 M 1:100

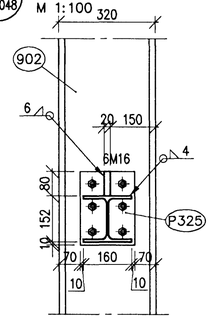

D Mynd
045048 M 1:10

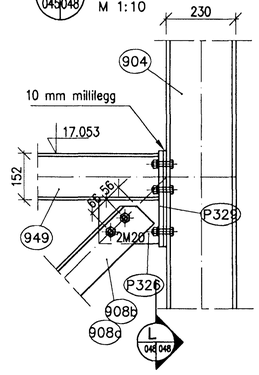

P324 PL 193.145...20
048048 M 1:10

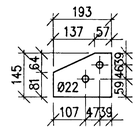

P325 PL 242.180...15
048048 M 1:10

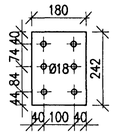

P326 PL 199.205...20
048048 M 1:10

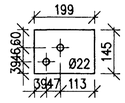

N Snið
048048 M 1:100

P328 PL 252.114...10
048048 M 1:10

L Snið
048048 M 1:100

E Mynd
045048 M 1:10

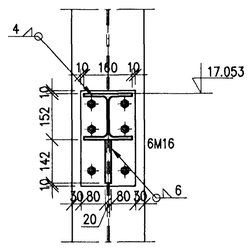

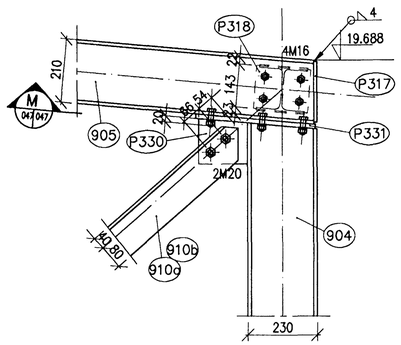

M Snið
048048 M 1:100

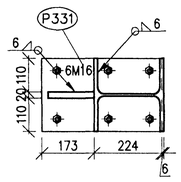

P329 PL 314.180...15
048048 M 1:10

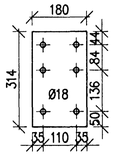

P330 PL 162.149...20
048048 M 1:10

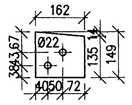

P331 PL 397.240...15
048048 M 1:10

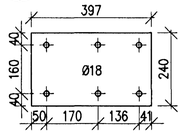

N Mynd
047047 M 1:10

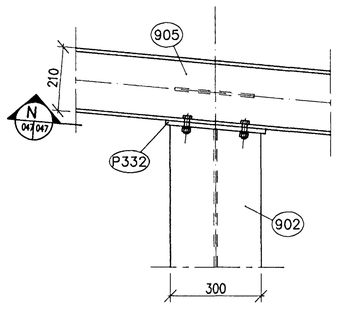

P332 PL 340.320...15
048048 M 1:10

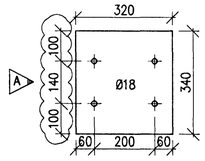

G Mynd
045048 M 1:10

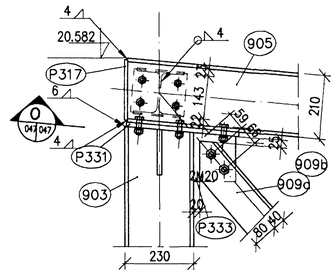

O Snið
048048 M 1:100

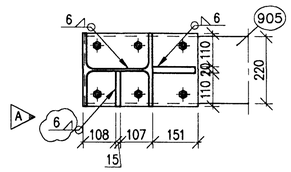

P333 PL 161.140...20
048048 M 1:10

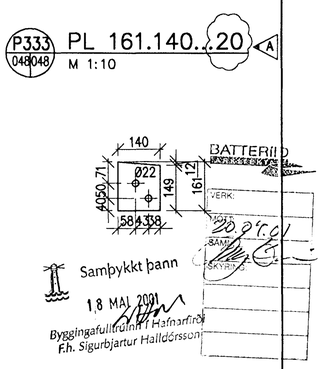

P335 PL 156.149...15
048048 M 1:10

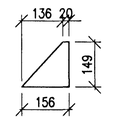

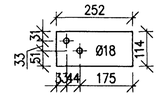

Skýringar: Efnisgæði fyrir stál og bolta sjá verklýsingu.
Explanations: Öll mál eru í mm nema hæðarkótar sem eru í m.
Bitatöflur sjá teikningu 166043

Rev.	Revision	Date	Approved	Released
A	Breyta plötum og suðum	02.04.2001	BH/mg	

Tilv.teikningar nr. ISAL / Ref.drawing no. of ISAL
Samsetn.teikningar nr. ISAL / Assembly drawing no. of ISAL

This drawing is the property of the ICELANDIC ALUMINIUM CO. LTD. and handed out for personal use only. It may neither be copied nor made available to others without permission of the ICELANDIC ALUMINIUM CO. LTD. The receiver is liable for any misuse.

Fjöldi stykkja / Number of pieces: IV III II I

Hlutur / Object	Atriði / Item	Efni / Material	ea.;stk / Weight (kg)	total;1 heild / Pyngd	Athugasemdir / Remarks
ÍSAL – Flutningur skauta – Matshluti 83					Mælikvarði / Scale 1:10
Stálvirki utanhúss – Lyftuhús					Stærð frumteikn. / Format of orig. A1
Deili – Snið					CCno.-Eq.type-Eq.no.

Verktaki / Supplier: Línuhönnun hf.
Drw.no. of suppl. / Teikn.nr. verktaka: Breyt./Rev.

Teiknað / Drawn	ÞB/BH 09.03.2001	Yfirfarið / Checked	BH 02.04.2001	Samþykkt / Approved	

algroup alusuisse *primary materials*
icelandic aluminium co. ltd. p.o. box 244 is-222 hafnarfjordur, iceland

Drw.no. of ISAL / Teikn.nr. ÍSAL: 166048 — Breyt./Rev.: A

Teiknað / Drawn | Yfirfarið og skoðað / Checked and filed | Notkun heimiluð / Released