


**FESTING SUDURVEGGJAR AD OFAN BIL 10 - 11 SÚLA VID DYR VID HURÐA-BRAUT**

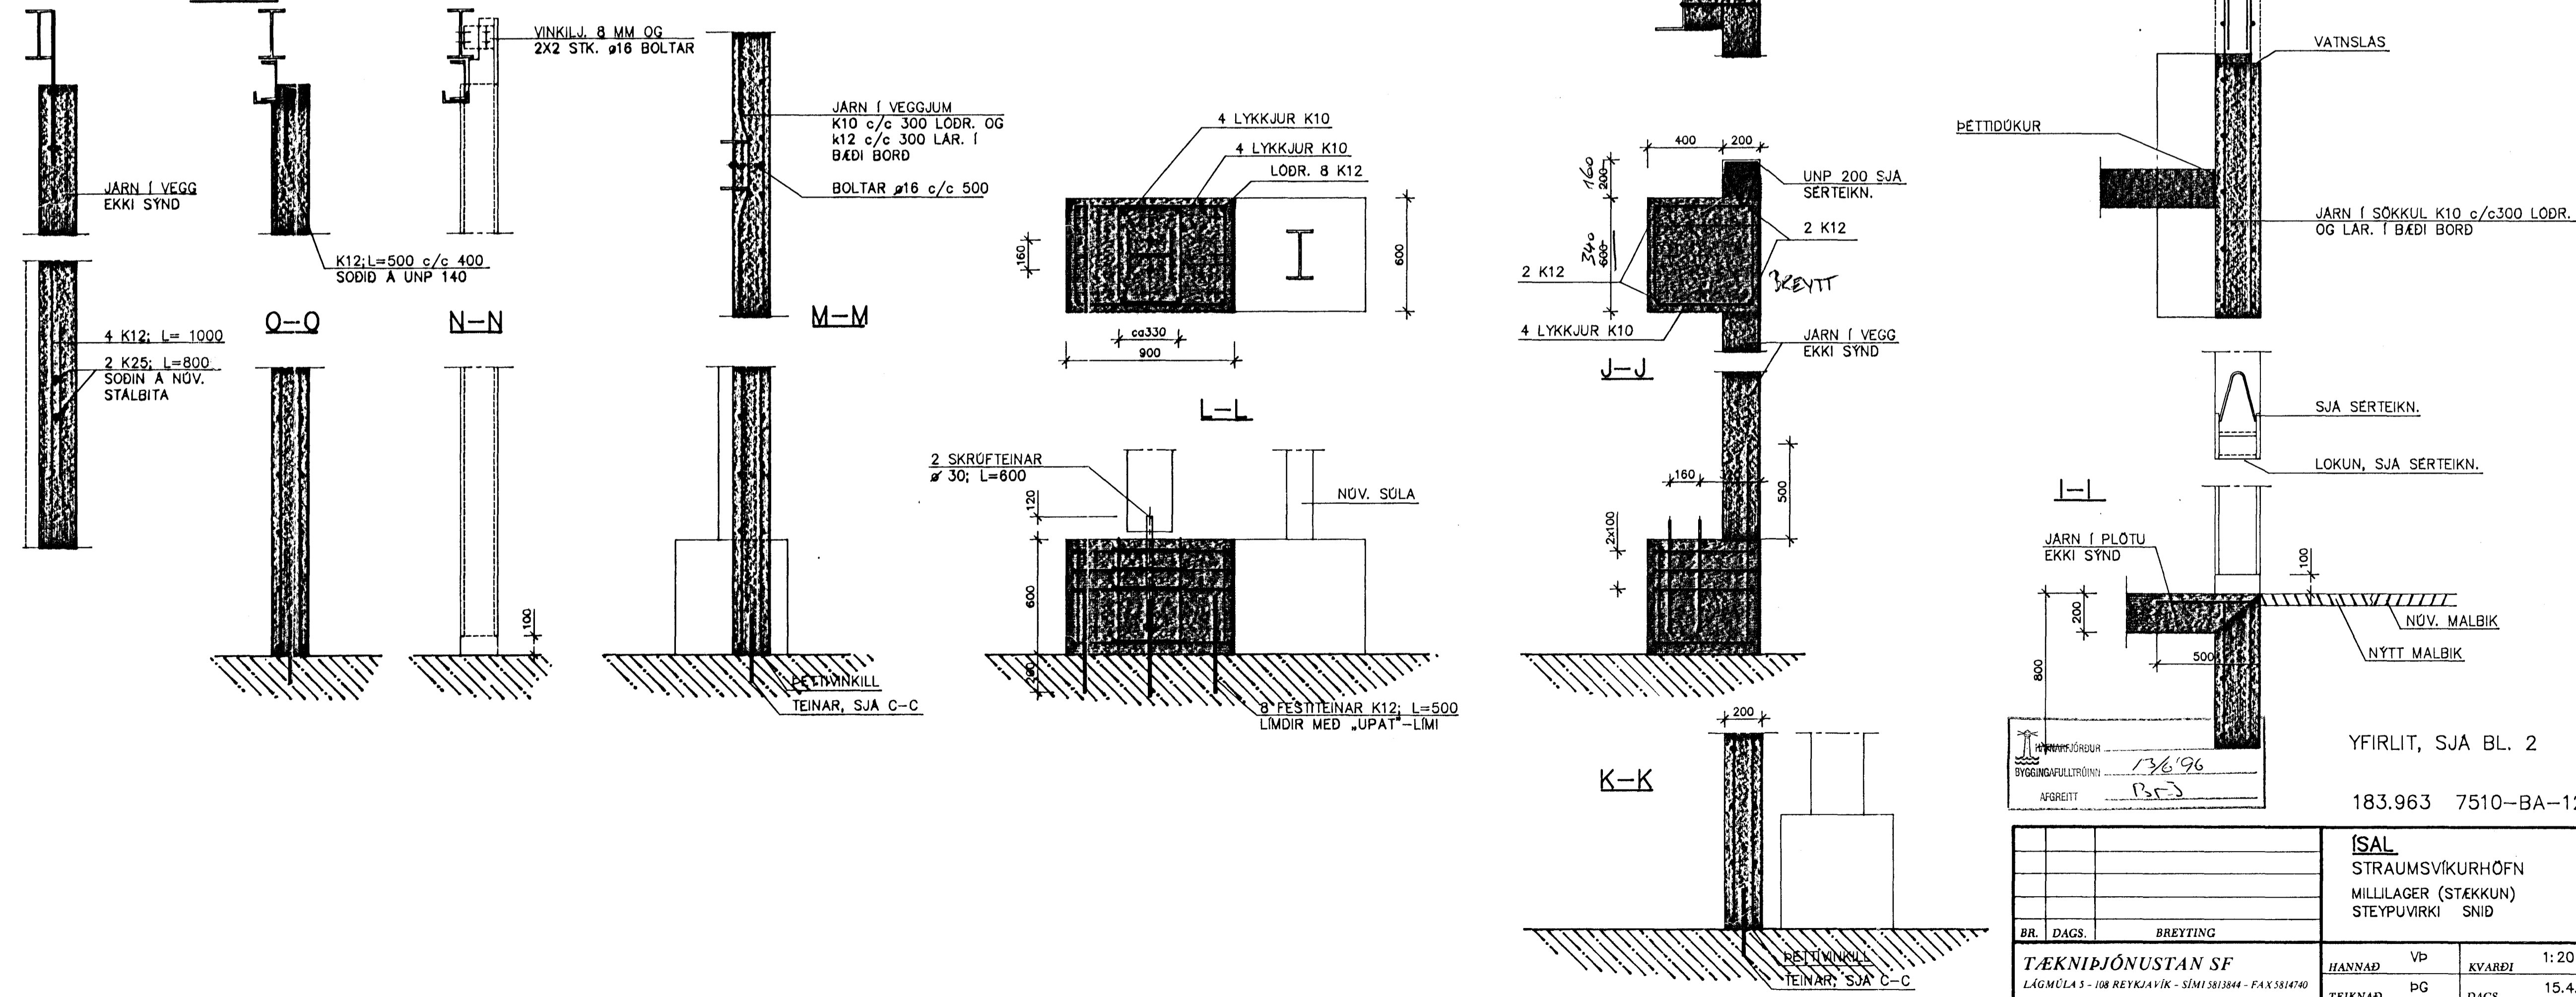

ISAL		STRAMSVÍKURHÖFN	
MILLILAGER (STÉKKUN)		STEYPUVIRKI SNID	
BR.	DAGS.	BREYTING	
TÆKNIDJÓUSTAN SF		HANNAD VP	KVARDI 1:20
LÁGMÚLA 5 - 108 REYKJAVÍK - SÍMI 5813844 - FAX 5814740		TEIKNAD DG	DAGS. 15.4.'96
YFIRFARIÐ		NR. 9602	BL. 12