


Skýringar:
Explanations:

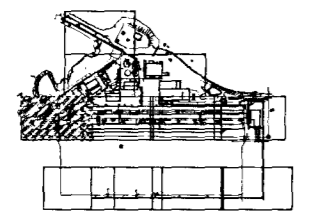

- LOKI X LOKI NR. X Á ELDRI KÆLVATNSLÖGN.
- LOKI X LOKI NR. X Á NÝRRI NEYSLUVATNSLÖGN, FRÁ HAFNARFIRDI
- LOKI X LOKI NR. X Á NÝRRI KÆLVATNSLÖGN.
- BRUNAHANI X BRUNAHANI NR. X Á KÆLVATNSLÖGN.
- ELDRI KÆLVATNSLÖGN, ÓR HRAUNINU
- NÝ NEYSLUVATNSLÖGN, FRÁ HAFNARFIRDI
- NÝ KÆLVATNSLÖGN, ÓR HRAUNINU

ISAL (95-1XX) 35120 VVG-V0WG-MAINWATER-AI-vatn101.DWG

Bygt. / Date	Breyting / Revision	Daga / Date	Gerð / Made by	Sambjótt / Approved

This drawing is the property of the ICELANDIC ALUMINUM CO. LTD. and handed out for personal use only. It may neither be copied nor made available to others without permission of the ICELANDIC ALUMINUM CO. LTD. The receiver is liable for any misuse.


VATNSVEITA
VATNSLAGNIR Í JÖRÐU
REYNDARTEIKNING - GRUNNMÝND
SVÆÐI 1
4020AV 1184
185432