Format A1 (841x594 mm) is 20 mm outside of this frame

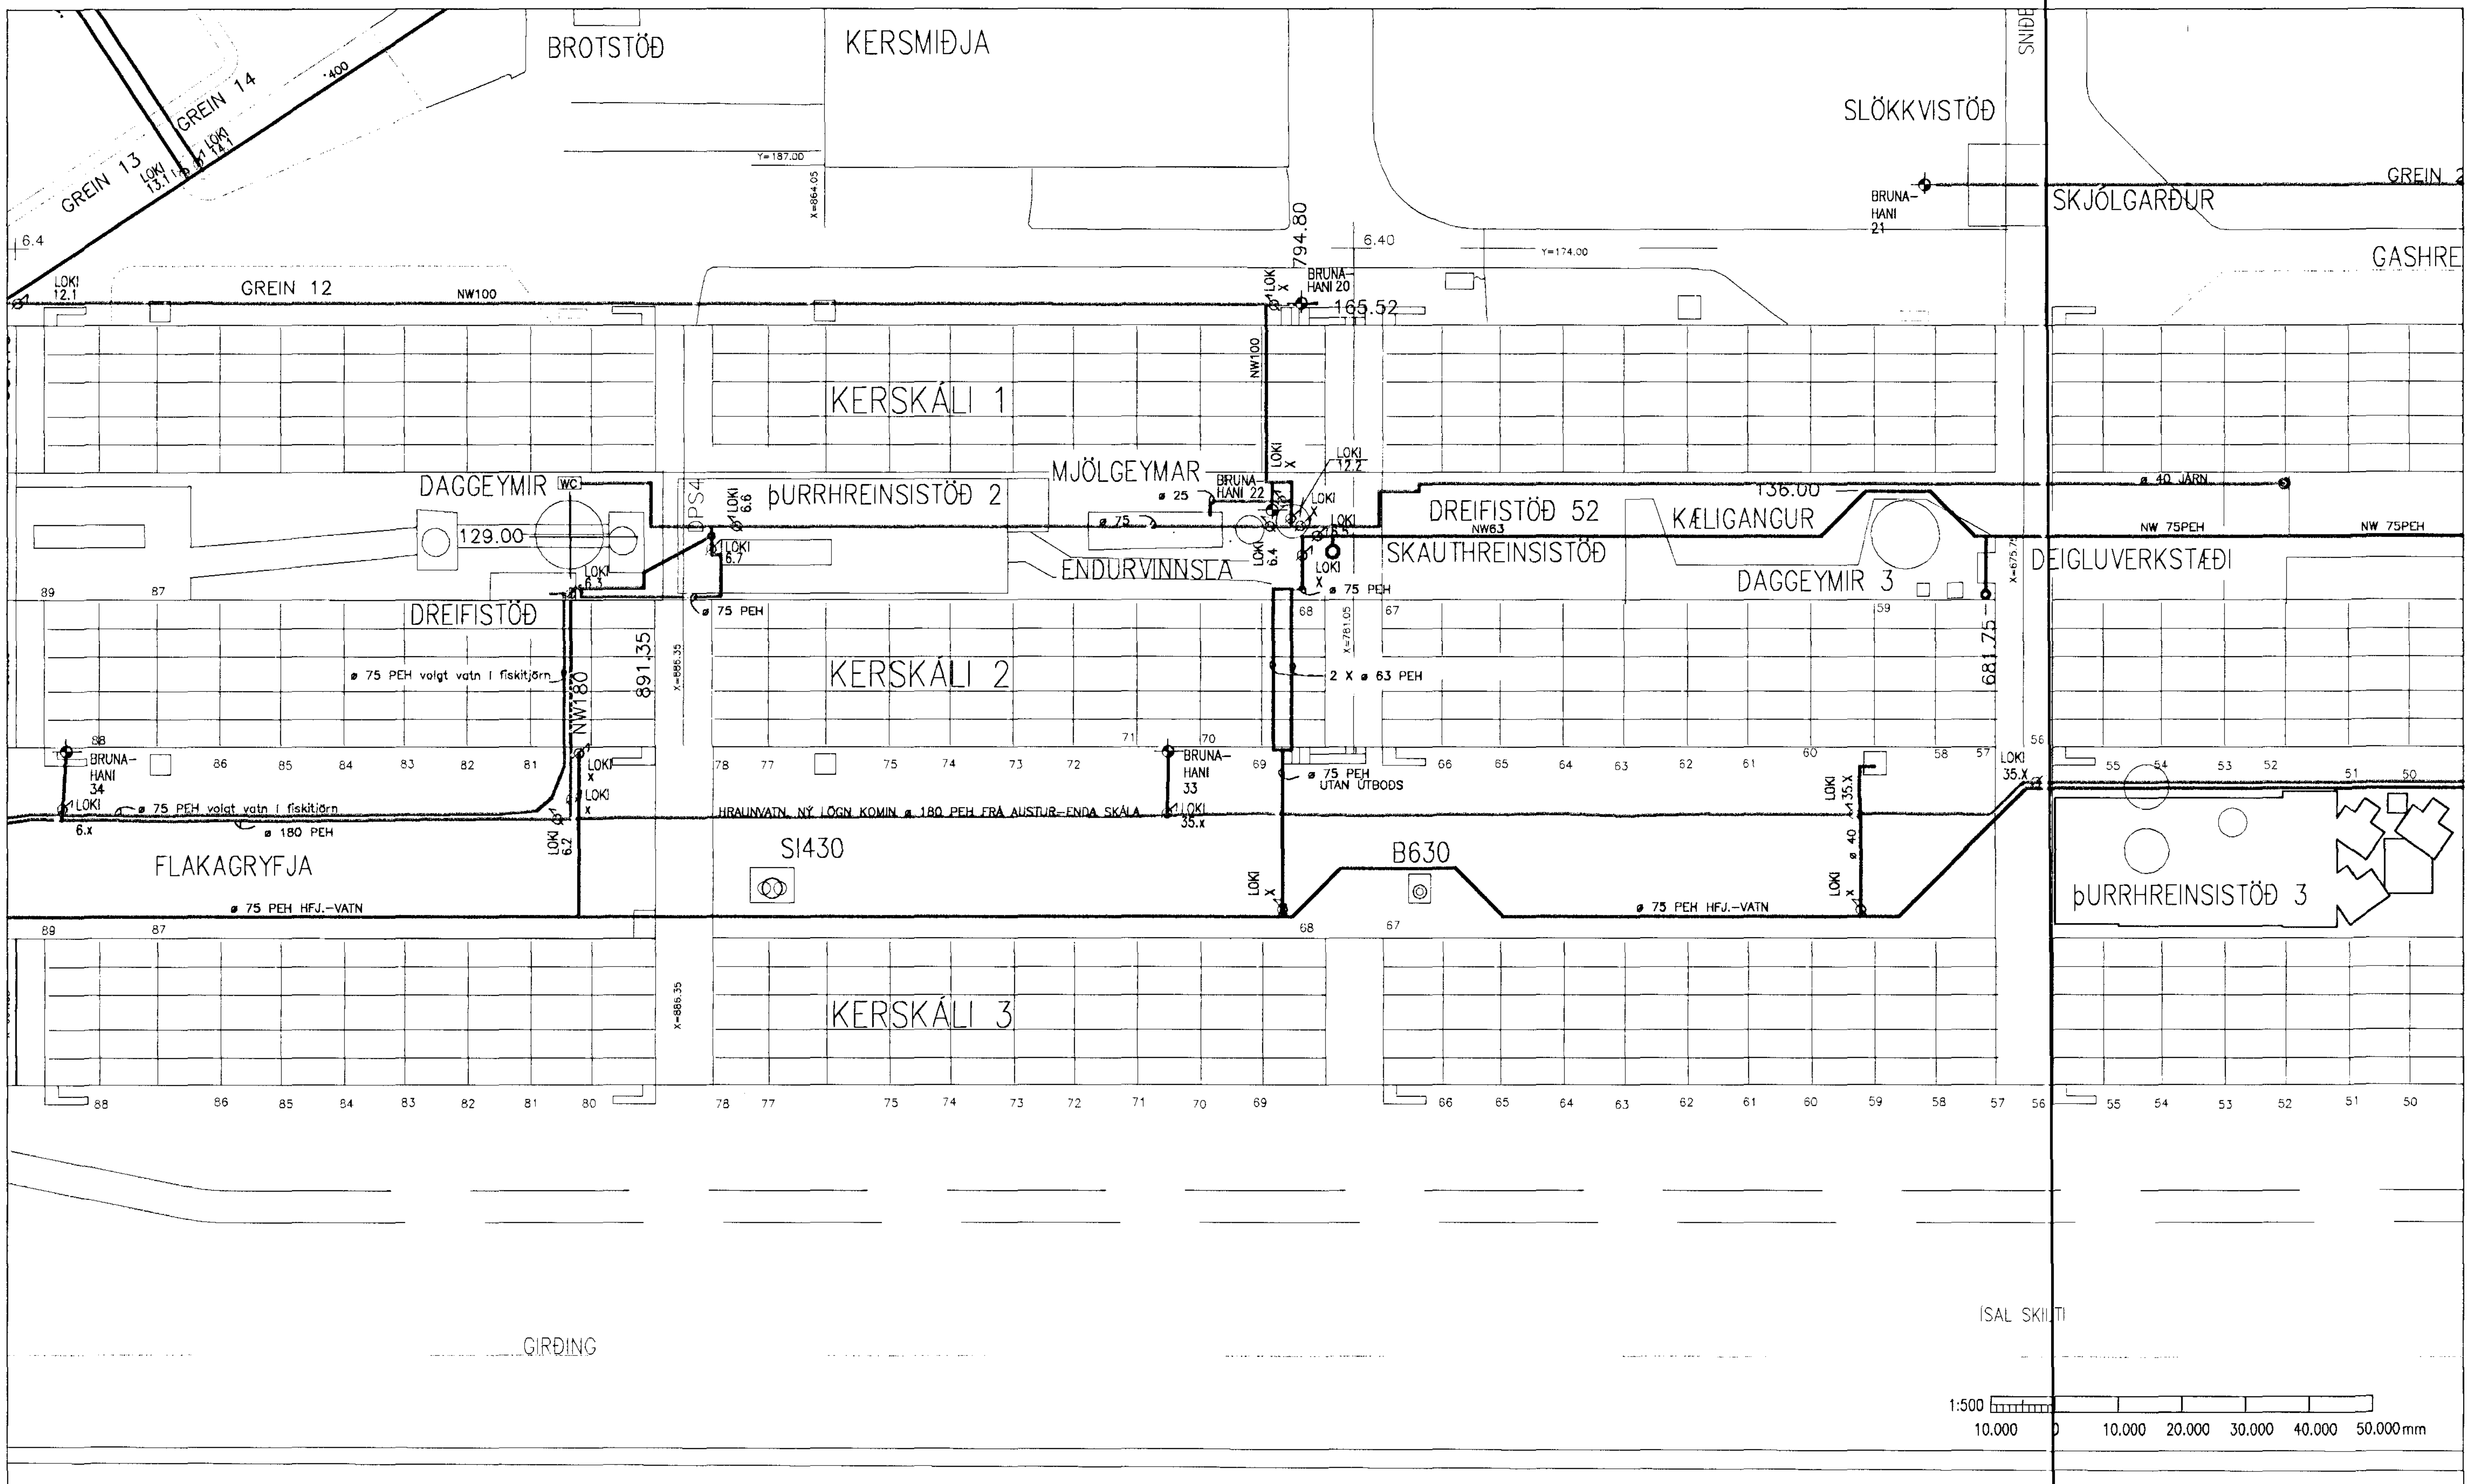

Skýringar:
Explanations:

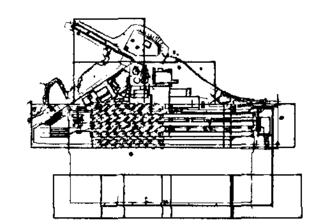

ø LOKI X	LOKI NR. X Á ELDRI KÆLIVATNSLÖGN.
ø LOKI X	LOKI NR. X Á NÝRRI NEYSLUVATNSLÖGN, FRÁ HAFNARFIRÐI
ø LOKI X	LOKI NR. X Á NÝRRI KÆLIVATNSLÖGN.
BRUNA-HANI X	BRUNAHANI NR. X Á KÆLIVATNSLÖGN.
———	ELDRI KÆLIVATNSLÖGN, ÚR HRAUNINU
———	NÝ NEYSLUVATNSLÖGN, FRÁ HAFNARFIRÐI
———	NÝ KÆLIVATNSLÖGN, ÚR HRAUNINU

I:\[95-1XX]\95120\DWG\DWG-MAINWATER\AL-VATN102.DWG

Breyt. Rev. | Breyting Revision | Dags. Date | Gert af Made by | Samþykkt Approved

Tilv.teikningar nr. ÍSAL / Ref.drawing no. of ISAL | Samsetn.teikningar nr. ÍSAL / Assembly drawing no. of ISAL

This drawing is the property of the ICELANDIC ALUMINIUM CO. LTD. and handed out for personal use only. It may neither be copied nor made available to others without permission of the ICELANDIC ALUMINIUM CO. LTD. The receiver is liable for any misuse.

Fjöldi stykkja / Number of pieces	Hlutur / Object	Atriði / Item	Efni / Material	ea.: stk / total: í heild — Weight (kg) Þyngd	Athugasemdir / Remarks
IV III II I					

VATNSVEITA — SVÆÐI 2

VATNSLAGNIR Í JÖRÐU

REYNDARTEIKNING – GRUNNMYND

Mælikvarði / Scale: 1:500
Stærð frumteikn. / Format of orig.: A1
CCno.–Eq.type–Eq.no.: 4020AV 1184

VST Verkfræðistofa Sigurðar Thoroddsen hf.
Ármúla 4, 108 Reykjavík. Sími 569 5000 Fax 569 5010

Drw.no. of suppl. / Teikn.nr. verktaka: 95.120–36.112 | Breyt./Rev.

Teiknað / Drawn: AG JÚNÍ 1998 | Yfirfarið / Checked | Samþykkt / Approved

ICELANDIC ALUMINIUM CO. LTD.
Straumsvík, IS-220 Hafnarfjördur, Iceland

Drw.no. of ISAL / Teikn.nr. ÍSAL: 185433 | Breyt./Rev.

Teiknað / Drawn | Yfirfarið / Checked | Samþykkt / Approved