



GIRDING
AZIMUTH 325°29'55"

HNIT X
HNIT Y

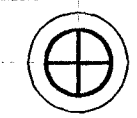

HNITAPUNKTAR MIÐAÐIR
VIÐ HAFNARFJÖRÐ
Y=6971.96 }
X=26253.58 } PUNKTUR
Y=6970.86 }
X=26252.82 } HORN LÓÐARMARKA

LANDSHNITAKERFI

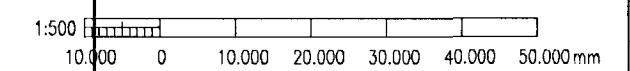

Skýringar:
Explanations:

- LOKI NR. X Á ELDRI KÆLVATNSLÖGN.
- LOKI NR. X Á NÝRRI NEYSLUVATNSLÖGN, FRÁ HAFNARFIRÐI
- LOKI NR. X Á NÝRRI KÆLVATNSLÖGN.
- BRUNAHANI NR. X Á KÆLVATNSLÖGN.
- ELDRI KÆLVATNSLÖGN, ÖR HRAUNINU
- NÝ NEYSLUVATNSLÖGN, FRÁ HAFNARFIRÐI
- NÝ KÆLVATNSLÖGN, ÖR HRAUNINU

N:\195-1XX\195120\DWG\DWG-MAIN\WATER\AL-VATN104.DWG

Breyt. / Rev.	Breyting / Revision	Dagur / Date	Gerð / Made by	Sambýtt / Approved

Þv. teikningar nr. ISAL
Ref. drawing no. of ISAL

Samastr. teikningar nr. SAL
Assembly drawing no. of SAL

This drawing is the property of the ICELANDIC ALUMINIUM CO. LTD. and handed out for personal use only. It may neither be copied nor made available to others without permission of the ICELANDIC ALUMINIUM CO. LTD. The receiver is liable for any misuse.

Fjöldi stúkkja / Number of pieces	Hlutur / Object	Áritun / Item	Efni / Material	Þyngd / Weight	Stærð / Size	Alþyggisamær / Remarks
1	VATNSVEITA				SVÆÐI 4	
	VATNSLAGNIR Í JÖRÐU					
	REYNDARTEIKNING - GRUNNMYND					
	YST Varkrafstöfola Sigurður Thorgeirsson M. Sýnt á 1. útgáfu 1998			95.120-36.114		
	AG JÚNÍ 1998					
	ICELANDIC ALUMINIUM CO. LTD. Straumsvík, IS-220 Hafnarfjörður, Iceland			185435		