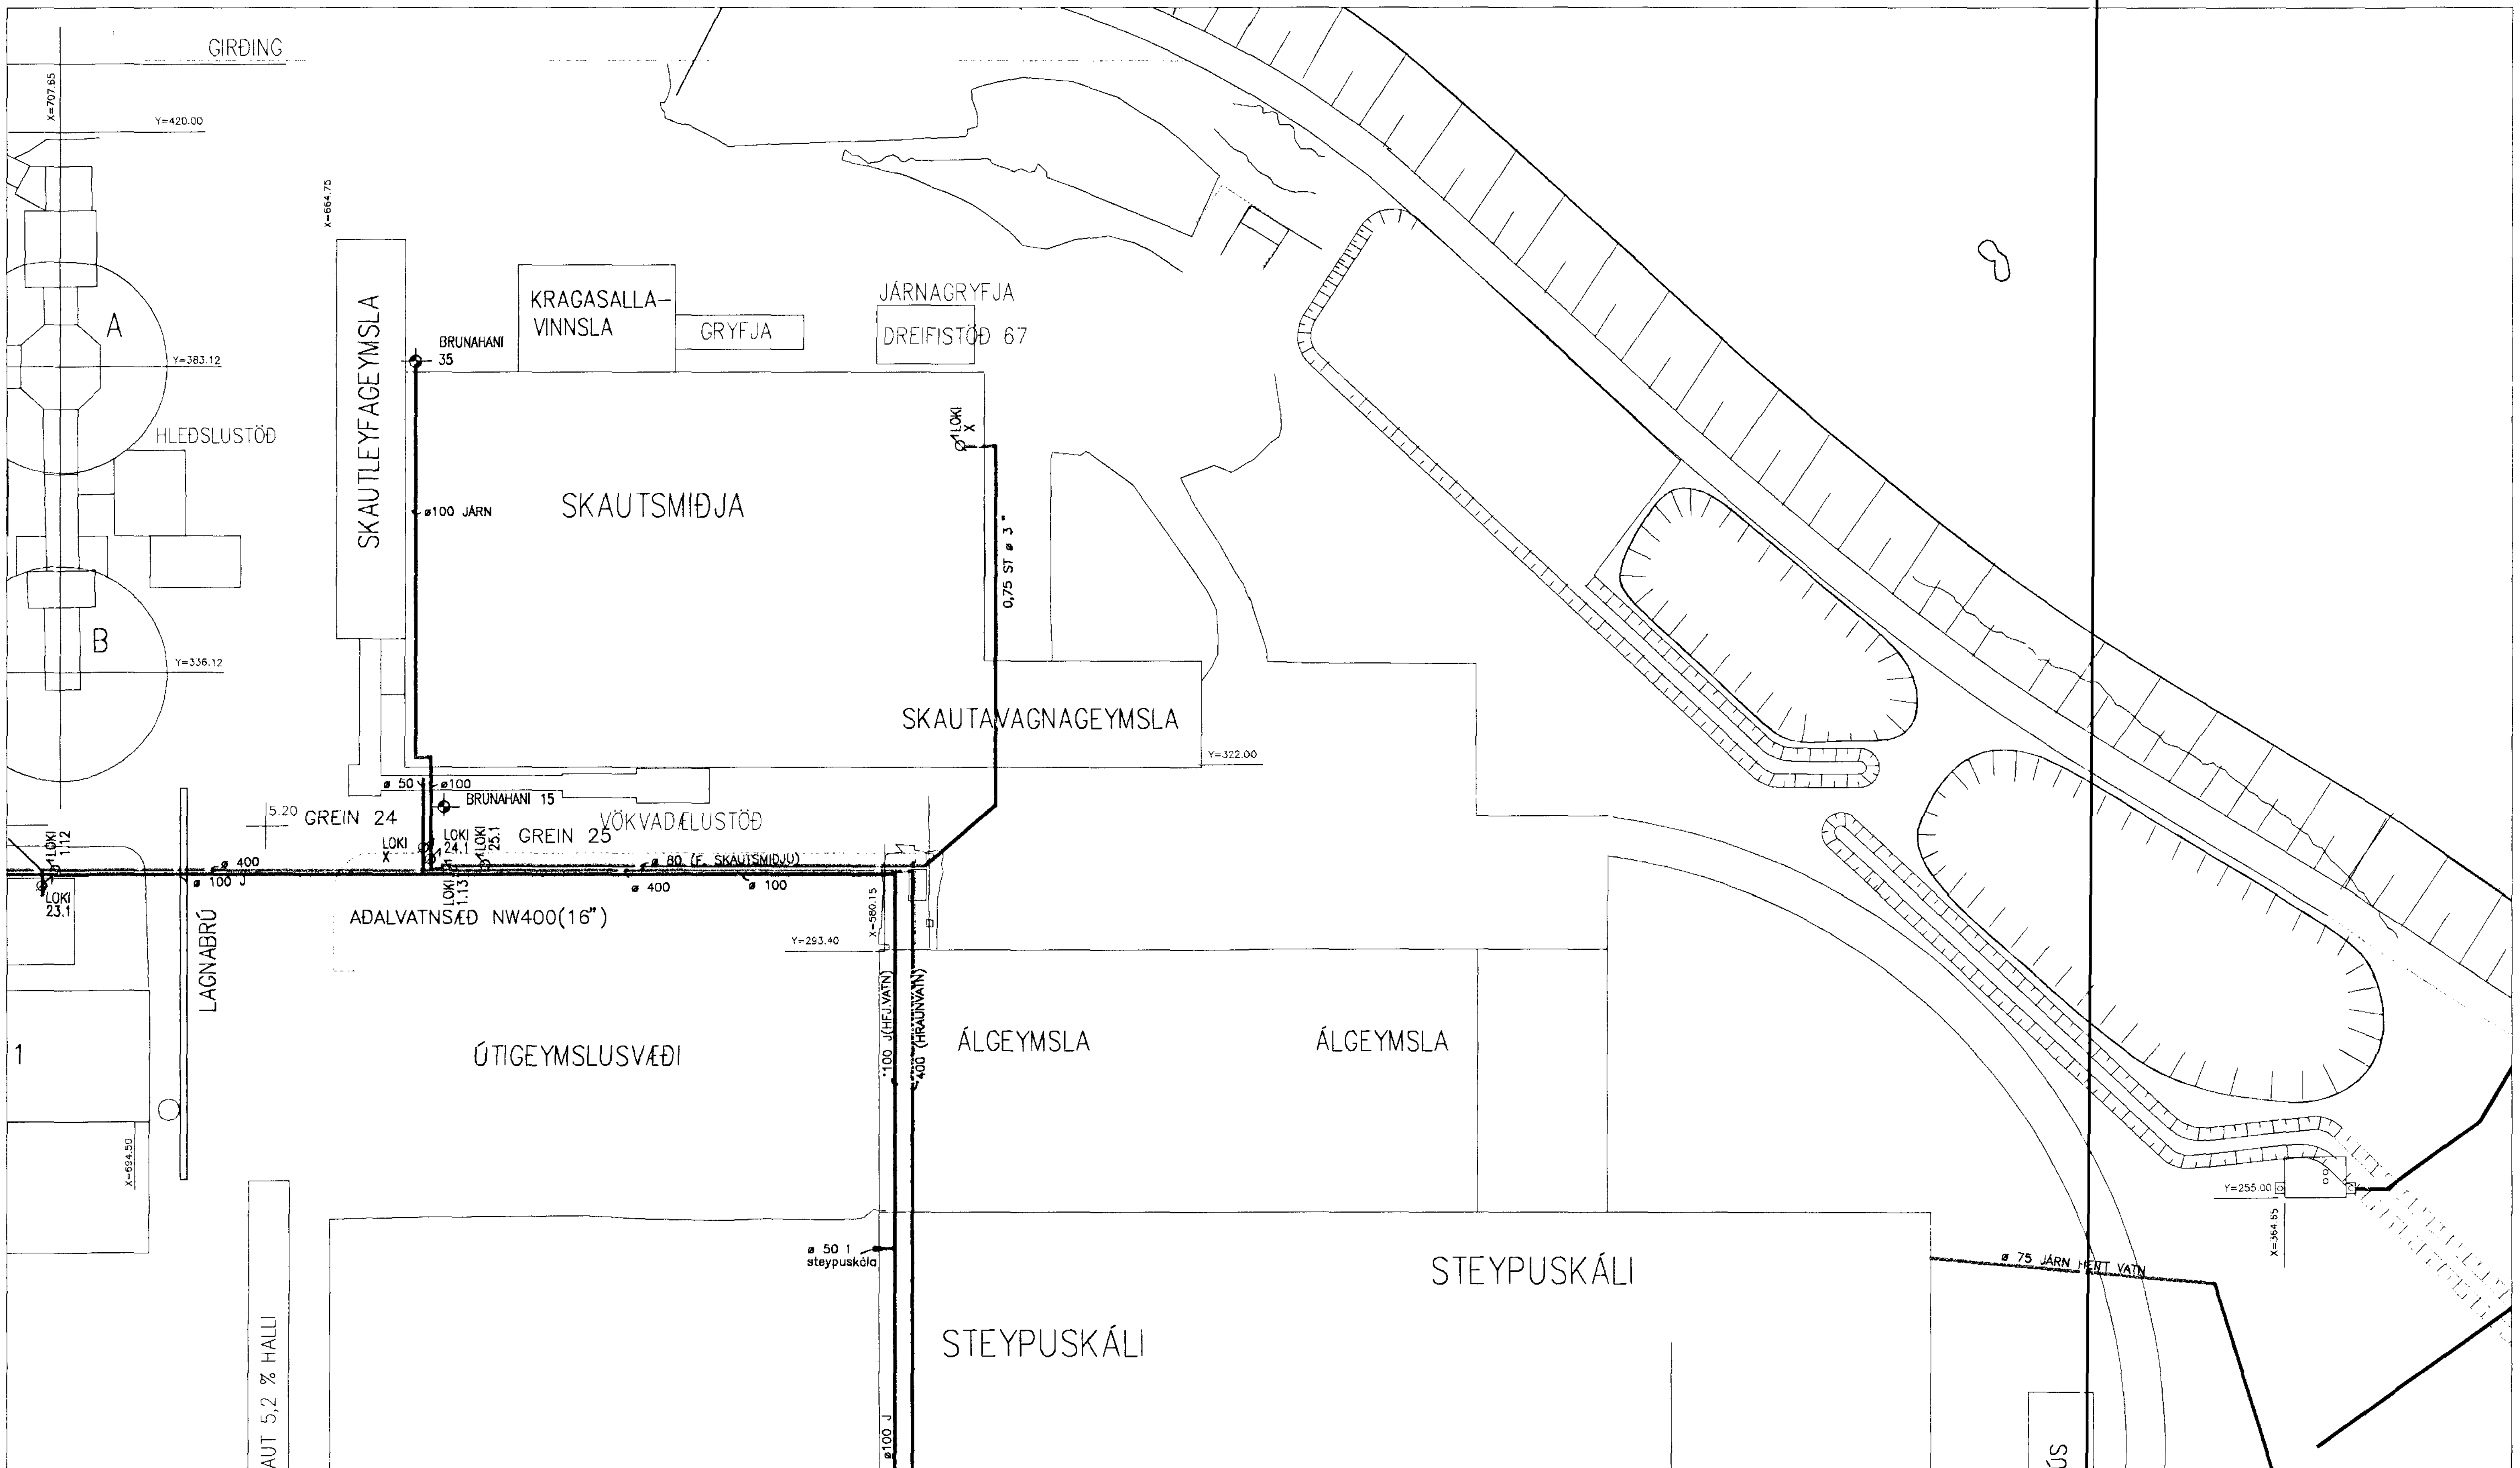

1:500

10.000 0 10.000 20.000 30.000 40.000 50.000 mm

Skýringar:
Explanations:

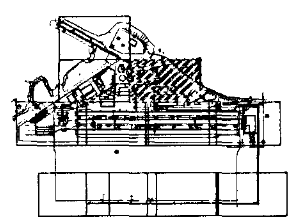

ø LOKI X	LOKI NR. X Á ELDRI KÆLIVATNSLÖGN.
ø LOKI X	LOKI NR. X Á NÝRRI NEYSLUVATNSLÖGN, FRÁ HAFNARFIRÐI
ø LOKI X	LOKI NR. X Á NÝRRI KÆLIVATNSLÖGN.
BRUNA-HANI X	BRUNAHANI NR. X Á KÆLIVATNSLÖGN.
———	ELDRI KÆLIVATNSLÖGN, ÚR HRAUNINU
———	NÝ NEYSLUVATNSLÖGN, FRÁ HAFNARFIRÐI
———	NÝ KÆLIVATNSLÖGN, ÚR HRAUNINU

I:\95-1XX\95120\DWG\DWG-MAINWATER\AL-VATN106.DWG

Breyt. Rev. | Breyting Revision | Dags Date | Gert af Made by | Samþykkt Approved

Tilv.teikningar nr. ISAL Ref.drawing no. of ISAL | Samsetn.teikningar nr. ISAL Assembly drawing no. of ISAL

This drawing is the property of the ICELANDIC ALUMINIUM CO. LTD. and handed out for personal use only. It may neither be copied nor made available to others without permission of the ICELANDIC ALUMINIUM CO. LTD. The receiver is liable for any misuse.

Fjöldi stykkja Number of pieces	Hlutur Object	Atriði Item	Efni Material	ea.: stk Weight (kg)	total: í heild Þyngd	Athugasemdir Remarks
IV III II I	VATNSVEITA — SVÆÐI 6					Mælikvarði Scale 1:500
	VATNSLAGNIR Í JÖRÐU					Stærð frumteikn. Format of orig. A1
	REYNDARTEIKNING – GRUNNMYND					CCno.–Eq.type–Eq.no. 4020AV 1184

VST Verkfræðistofa Sigurðar Thoroddsen hf.

Drw.no. of suppl. / Teikn.nr. verktaka: 95.120–36.116 | Breyt./Rev.

Teiknað Drawn: AG JÚNÍ 1998 | Yfirfarið Checked | Samþykkt Approved

ICELANDIC ALUMINIUM CO. LTD.
Straumsvík, IS-220 Hafnarfjördur, Iceland

Drw.no. of ISAL / Teikn.nr. ISAL: 185437 | Breyt./Rev.

Teiknað Drawn | Yfirfarið Checked | Samþykkt Approved