Format A1 (841x594 mm) is 20 mm outside of this frame

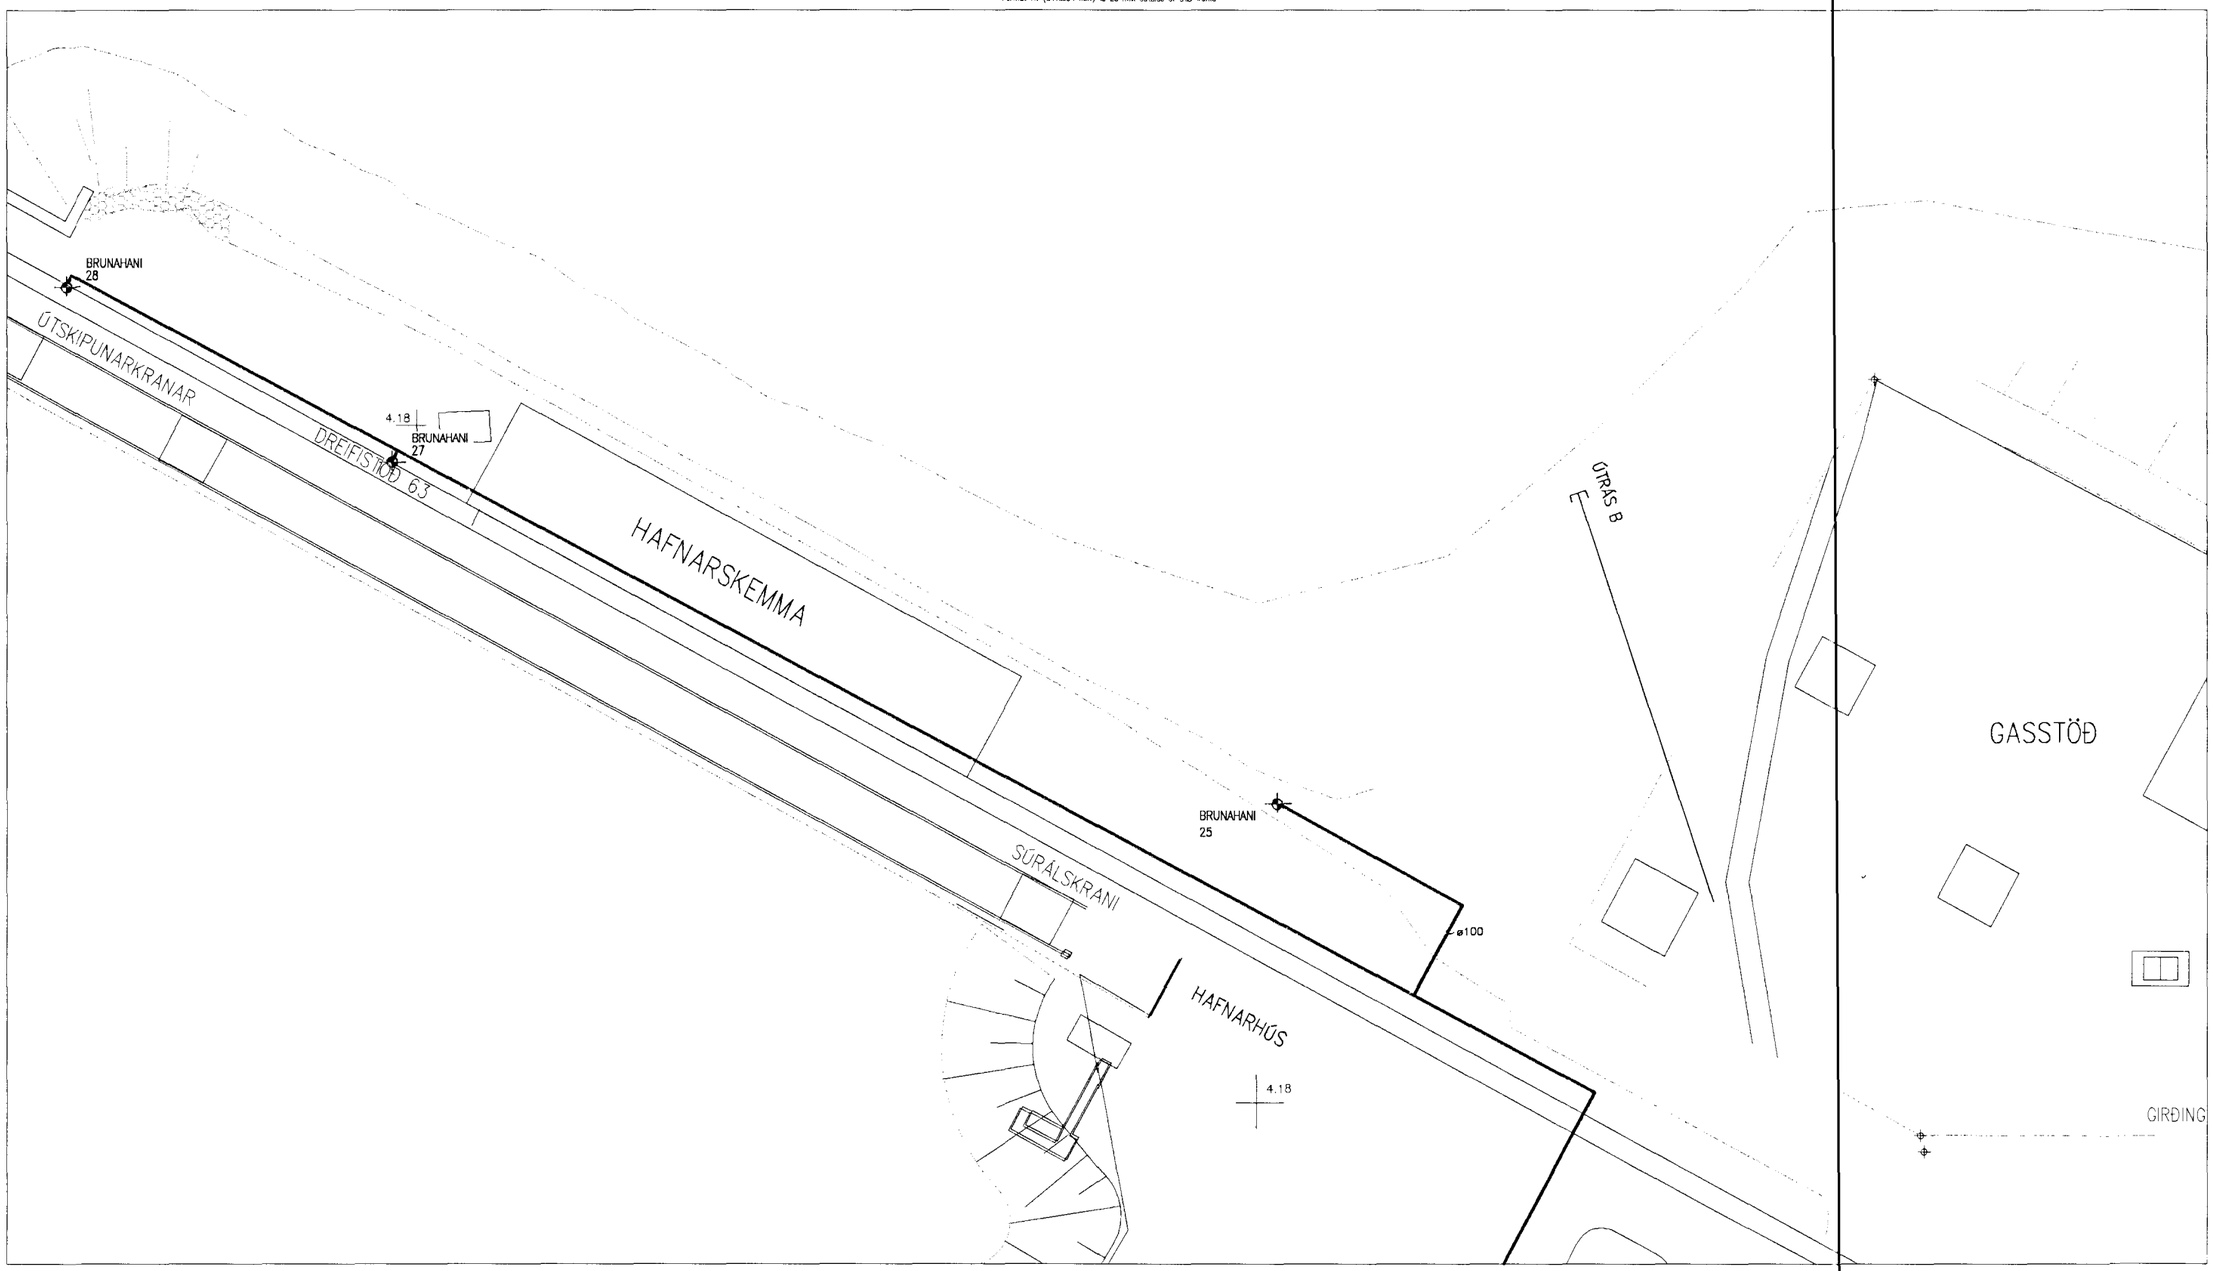

1:500

10.000 0 10.000 20.000 30.000 40.000 50.000 mm

Skýringar:
Explanations:

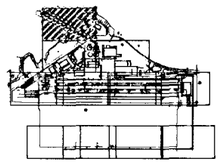

LOKI X	LOKI NR. X Á ELDRI KÆLIVATNSLÖGN.
LOKI X	LOKI NR. X Á NÝRRI NEYSLUVATNSLÖGN, FRÁ HAFNARFIRÐI
LOKI X	LOKI NR. X Á NÝRRI KÆLIVATNSLÖGN.
BRUNA-HANI X	BRUNAHANI NR. X Á KÆLIVATNSLÖGN.
	ELDRI KÆLIVATNSLÖGN, ÚR HRAUNINU
	NÝ NEYSLUVATNSLÖGN, FRÁ HAFNARFIRÐI
	NÝ KÆLIVATNSLÖGN, ÚR HRAUNINU

I:\I95-1XXI\95120\DWG\DWG-MAINWATER\AL-VATN107.DWG

Breyt. Rev.	Breyting Revision	Dags. Date	Gert af Made by	Samþykkt Approved

Tilv.teikningar nr. ISAL
Ref.drawing no. of ISAL

Samsetn.teikningar nr. ISAL
Assembly drawing no. of ISAL

This drawing is the property of the ICELANDIC ALUMINIUM CO. LTD. and handed out for personal use only. It may neither be copied nor made available to others without permission of the ICELANDIC ALUMINIUM CO. LTD. The receiver is liable for any misuse.

Fjöldi stykkja / Number of pieces: IV III II I

Hlutur / Object | Atriði / Item | Efni / Material | eo.-stk. / Weight (kg) | totalf. heild / Pyrigd | Athugasemdir / Remarks

VATNSVEITA SVÆÐI 7

VATNSLAGNIR Í JÖRÐU

REYNDARTEIKNING – GRUNNMYND

Mælikvarði / Scale: 1:500
Stærð frumteikn. / Format of orig.: A1
CCho.-Eq.type-Eq.no.: 4020AV 1184

VST Verkfræðistofa Sigurðar Thoroddsen hf.
Armúla 4, 108 Reykjavík, Sími 568 3000, Fax 568 3010

Teiknað / Drawn: AG JÚNÍ 1998 | Yfirfarið / Checked | Samþykkt / Approved

Drw.no. of supp. / Teikn.nr. verkaþ: 95.120–36.117 | Breyt./Rev.

ISAL ICELANDIC ALUMINIUM CO. LTD.
Straumsvík, IS-220 Hafnarfjordur, Iceland

Drw.no. of ISAL / Teikn.nr. ISAL: 185438 | Breyt./Rev.

Teiknað / Drawn | Yfirfarið / Checked | Samþykkt / Approved