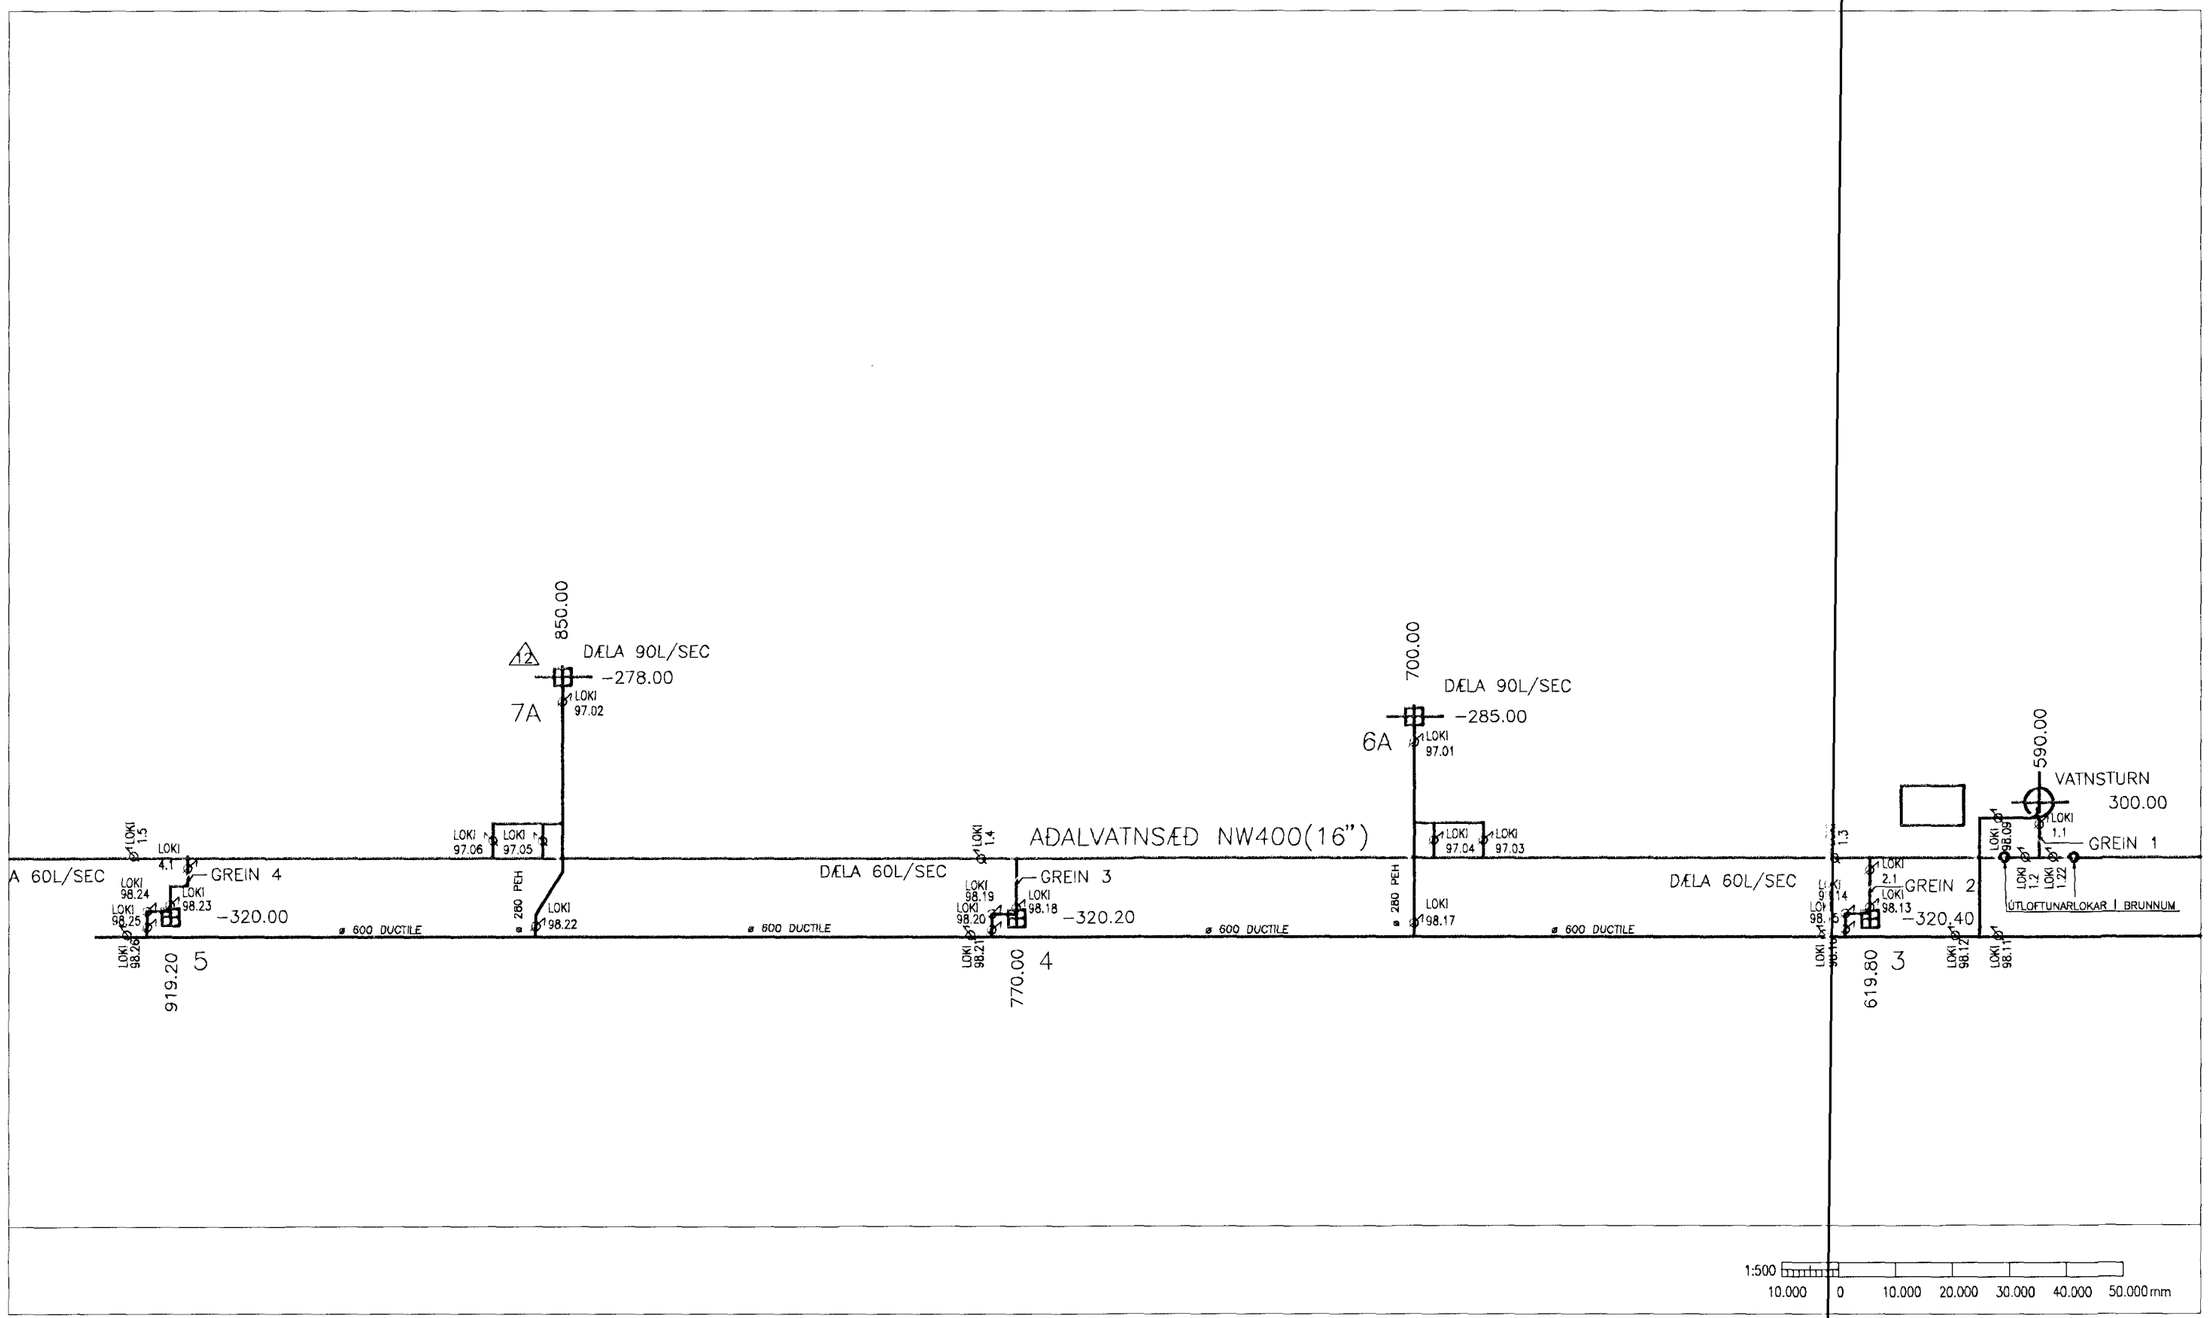

Skýringar:
Explanations:

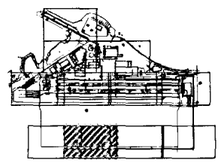

LOKI X	LOKI NR. X Á ELDRI KÆLIVATNSLÖGN.
LOKI X	LOKI NR. X Á NÝRRI NEYSLUVATNSLÖGN, FRÁ HAFNARFIRÐI
LOKI X	LOKI NR. X Á NÝRRI KÆLIVATNSLÖGN.
BRUNA-HANI X	BRUNAHANI NR. X Á KÆLIVATNSLÖGN.
	ELDRI KÆLIVATNSLÖGN, ÓR HRAUNINU
	NÝ NEYSLUVATNSLÖGN, FRÁ HAFNARFIRÐI
	NÝ KÆLIVATNSLÖGN, ÓR HRAUNINU

I:\I95-(XX)\95120\DWG\DWG-MAINWATER\AL-VATN109.DWG

Breyt. Rev.	Breyting Revision	Dags. Date	Gert af Made by	Samþykkt Approved

Tlv.teikningar nr. ISAL
Ref.drawing no. of ISAL

Samsetn.teikningar nr. ISAL
Assembly drawing no. of ISAL

This drawing is the property of the ICELANDIC ALUMINIUM CO. LTD. and handed out for personal use only. It may neither be copied nor made available to others without permission of the ICELANDIC ALUMINIUM CO. LTD. The receiver is liable for any misuse.

Fjöldi stykkja / Number of pieces: IV III II I

Hlutur / Object	Atriði / Item	Efni / Material	eg. stk / Weight	totalþ. / (kg)	heild / Pyngd	Athugasemdir / Remarks

VATNSVEITA SVÆÐI 9

VATNSLAGNIR Í JÖRÐU

REYNDARTEIKNING – GRUNNMYND

Mælikvarði / Scale: 1:500
Stærð frumteikn. / Format of orig.: A1
CDno.-Eq.type-Eq.no.: 4020AV 1184

VST Verkfræðistofa Sigurðar Thoroddsen hf.
Armúla 4, 108 Reykjavík Sími 588 5000 Fax 588 5010

Drw.no. of suppl. / Teikn.nr. verkfr. / Breyt./Rev.: 95.120-36.119

Teiknað / Drawn: AG JÚNI 1998 Yfirfarið / Checked

Samþykkt / Approved

ICELANDIC ALUMINIUM CO. LTD.
Straumsvík, IS-220 Hafnarfjordur, Iceland

Drw.no. of ISAL / Teikn.nr. ISAL: 185440 Breyt./Rev.

Teiknað / Drawn: Yfirfarið / Checked: Samþykkt / Approved