Format A1 (841x594 mm) is 20 mm outside of this frame

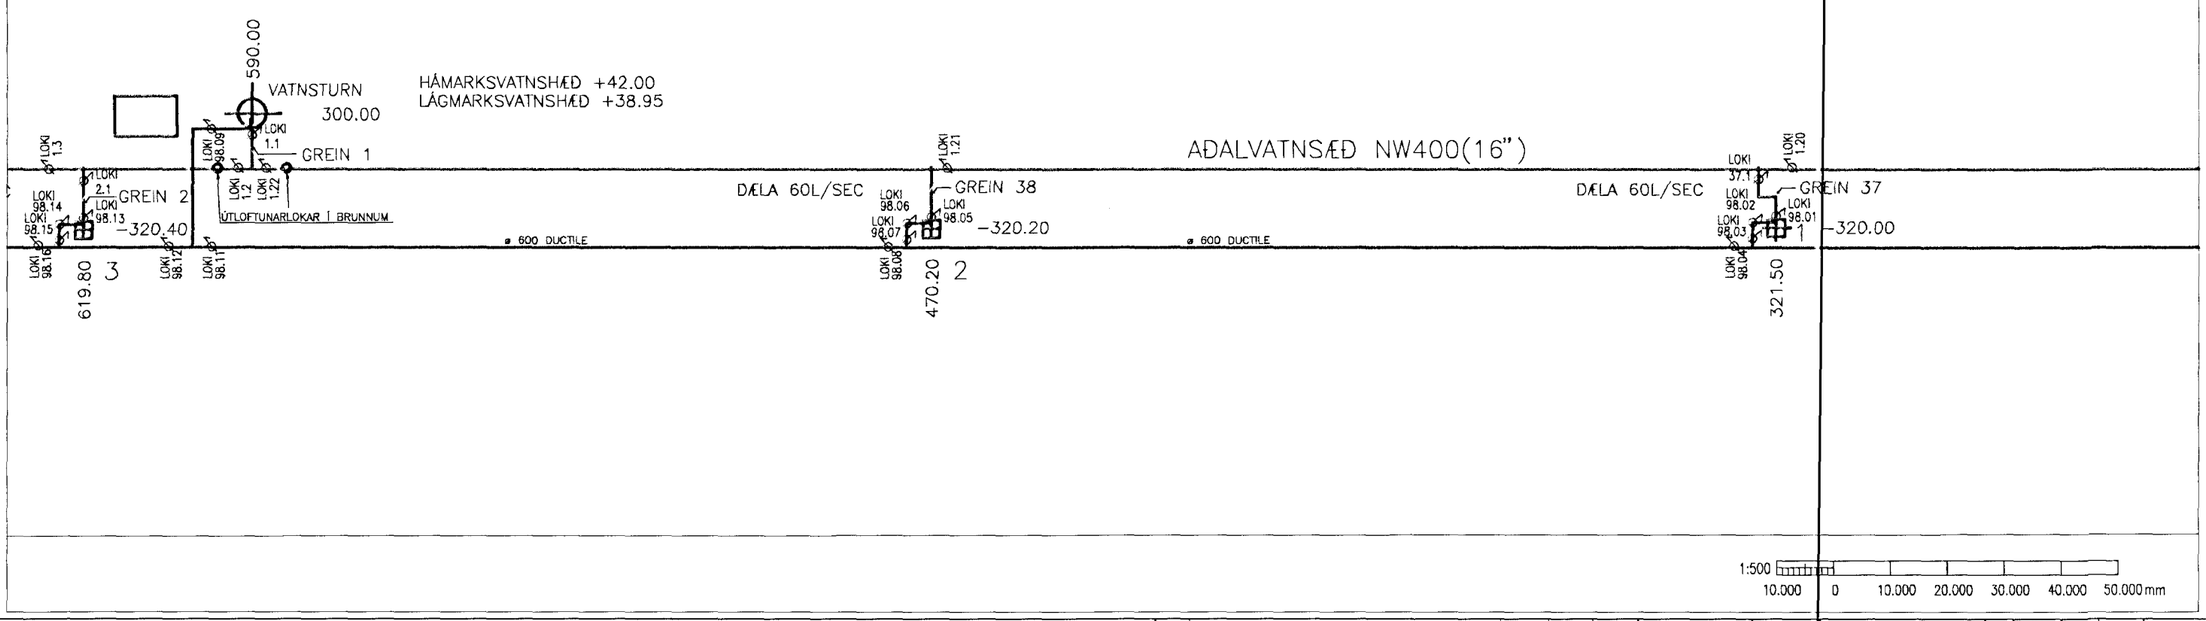

Skýringar:
Explanations:

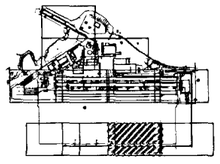

- LOKI NR. X Á ELDRI KÆLIVATNSLÖGN.
- LOKI NR. X Á NÝRRI NEYSLUVATNSLÖGN, FRÁ HAFNARFIRÐI
- LOKI NR. X Á NÝRRI KÆLIVATNSLÖGN.
- BRUNAHANI NR. X Á KÆLIVATNSLÖGN.
- ELDRI KÆLIVATNSLÖGN, ÚR HRAUNINU
- NÝ NEYSLUVATNSLÖGN, FRÁ HAFNARFIRÐI
- NÝ KÆLIVATNSLÖGN, ÚR HRAUNINU

I:\95-1XX\95120\DWG\DWG-MAINWATER\AL-VATN110.DWG

Breyt. Rev.	Breyting Revision	Dags. Date	Gert af Made by	Samþykkt Approved
Tilv.teikningar nr. ÍSAL Ref.drawing no. of ÍSAL		Samsetn.teikningar nr. ÍSAL Assembly drawing no. of ÍSAL		

This drawing is the property of the ICELANDIC ALUMINIUM CO. LTD. and handed out for personal use only. It may neither be copied nor made available to others without permission of the ICELANDIC ALUMINIUM CO. LTD. The receiver is liable for any misuse.

Fjöldi stykkja / Number of pieces: IV III II I

Hlutur / Object	Áætlað / Item	Efni / Material	Þyngd stk / Weight (kg)	Samtals / Total	Athugasemdir / Remarks
VATNSVEITA	SVÆÐI 10				Mælikvarði / Scale 1:500
VATNSLAGNIR Í JÖRÐU					Stærð frumteikn. / Format of orig. A1
REYNDARTEIKNING - GRUNNMYND					OCN.-Eq.type-Equ.no. 4020 AV 1184

VST Verkfræðistofa Sigurðar Thoroddsen hf. Ármúla 4, 108 Reykjavík Sími 588 5088 Fax 588 5019

Teikn.dags. / Drawn: ÁG JÚNÍ 1998 | Yfirfarið / Checked

Skráno. af hönn. / Taktur. verktaki / Engr. Nos.: 95.120-36.120

Samþykkt / Approved

ÍSAL ICELANDIC ALUMINIUM CO. LTD. Straumsvík, IS-220 Hafnarfjörður, Iceland

Skráno. af ÍSAL / Taktur. ÍSAL / Engr. Nos.: 185441

Teikn.dags. / Drawn | Yfirfarið / Checked | Samþykkt / Approved