Format A1 (841x594 mm) is 20 mm outside of this frame

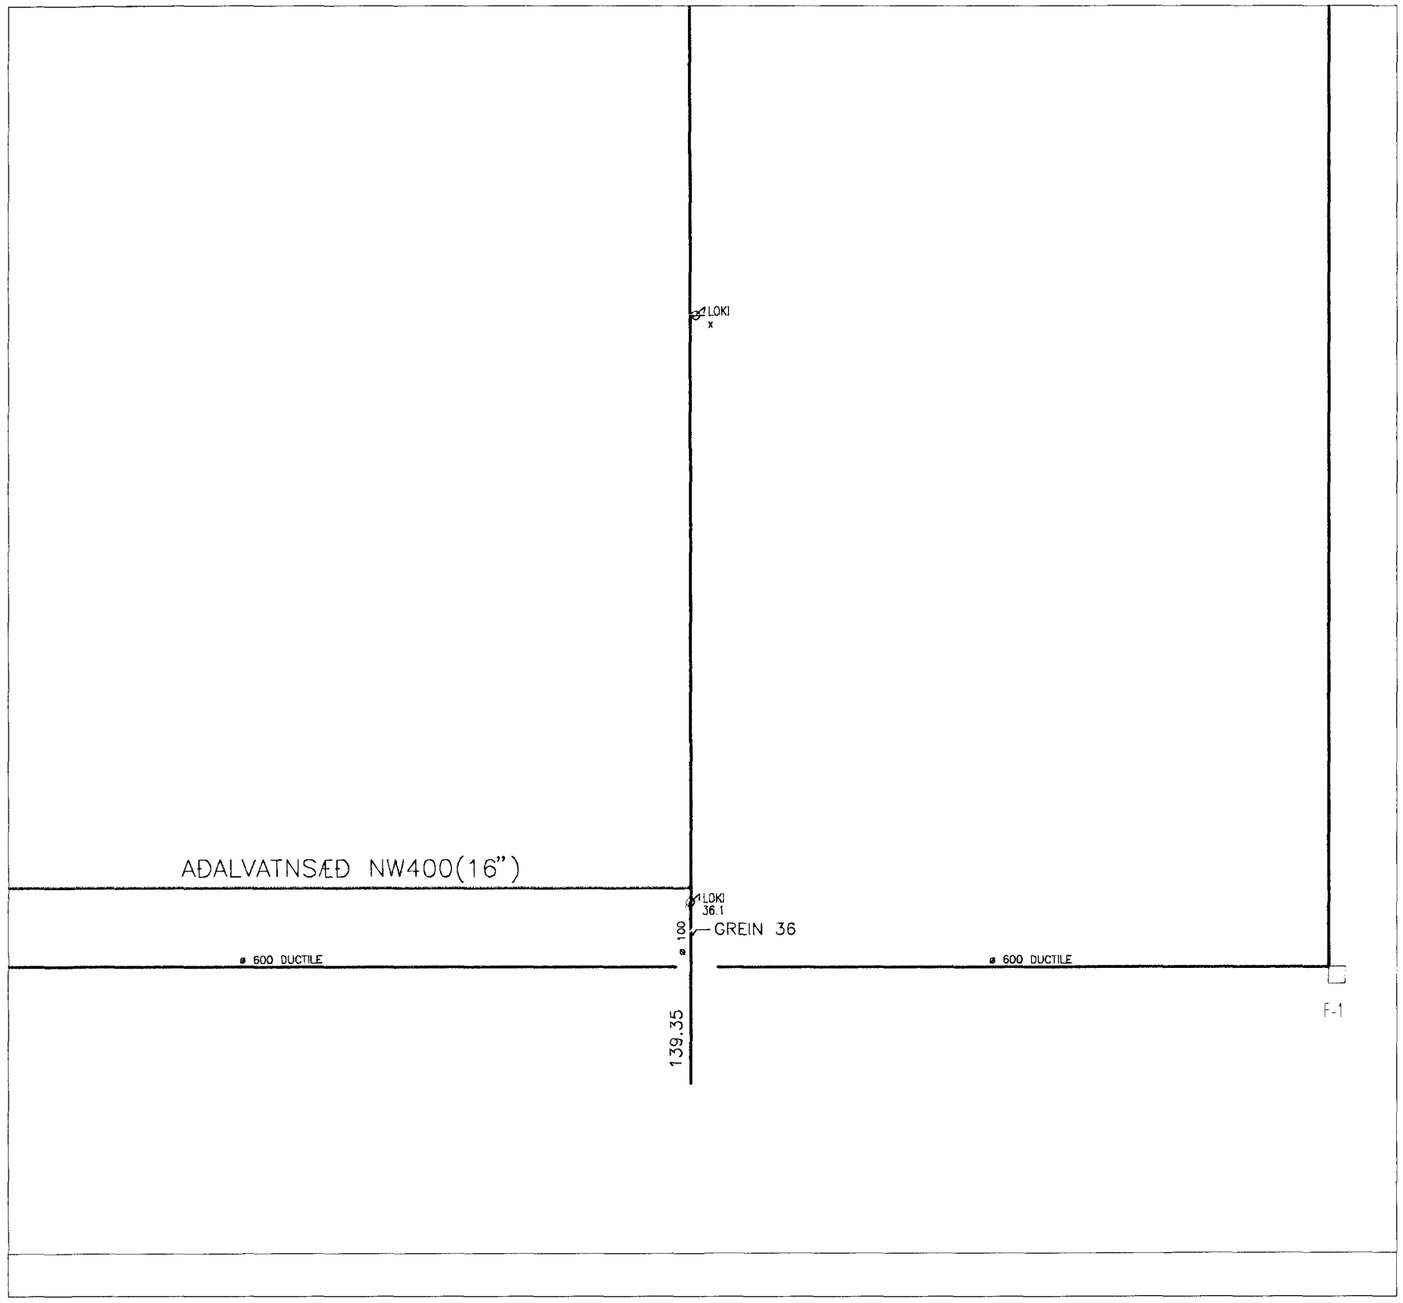

1:500

10.000 0 10.000 20.000 30.000 40.000 50.000 mm

Skýringar:
Explanations:

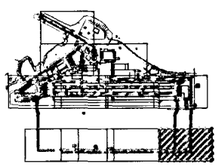

ø LOKI x	LOKI NR. X Á ELDRI KÆLIVATNSLÖGN.
ø LOKI x	LOKI NR. X Á NÝRRI NEYSLUVATNSLÖGN, FRÁ HAFNARFIRÐI
ø LOKI x	LOKI NR. X Á NÝRRI KÆLIVATNSLÖGN.
BRUNA-HANI x	BRUNAHANI NR. X Á KÆLIVATNSLÖGN.
	ELDRI KÆLIVATNSLÖGN, ÓR HRAUNINU
	NÝ NEYSLUVATNSLÖGN, FRÁ HAFNARFIRÐI
	NÝ KÆLIVATNSLÖGN, ÓR HRAUNINU

Breyt. Rev.	Breyting Revision	Dags. Date	Gert af Made by	Samþykkt Approved
Tilv.teikningar nr. ÍSAL Ref.drawing no. of ÍSAL		Samsetn.teikningar nr. ÍSAL Assembly drawing no. of ÍSAL		

I:\95-1XX\\95120\DWG\DWG-MAIN\WATER\AL-VATN111.DWG

This drawing is the property of the ICELANDIC ALUMINIUM CO. LTD. and handed out for personal use only. It may neither be copied nor made available to others without permission of the ICELANDIC ALUMINIUM CO. LTD. The receiver is liable for any misuse.

Fjöldi stykkja Number of pieces: IV III II I

Flutur Object	Áætlk Item	Efni Material	eq.stk	total f. hepp Weight (kg) Eyrgd	Athugasemdir Remarks

VATNSVEITA SVÆÐI 11

VATNSLAGNIR Í JÖRÐU

REYNDARTEIKNING - GRUNNMYND

Mælikvarði Scale 1:500

Stærð Aðaltekn. Format of drg. A1

CCno.-Eq.type-Eq.no. 4020AV 1184

VST Verkfræðistofa Sigurðar Thoroddsen hf.

Drw.no. of hpsk / Factory drawing Breyt./Rev. 95.120-36.121

Teiknað Drawn AG JÚNÍ 1998 Yfirfarið Checked Samþykkt Approved

ÍSAL ICELANDIC ALUMINIUM CO. LTD. Straumsvík, IS-220 Hafnarfjörður, Iceland

Drw.no. of ISAL / Factory ISAL 185442 Breyt./Rev.

Teiknað Drawn Yfirfarið Checked Samþykkt Approved