


RÚMMYND HITALAGNA 1:50

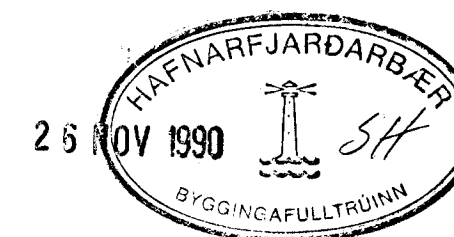

DI	22.11.70	BR. SKV. LÖGN PÍPULM. HITI Í GOLF ANDDYRI	
BR. NR	DAGS	EDLI BREVINGAR	SIGN
STUJLABERG 100 HAFNARFJÖRÐI			DAGS OKT. 87
RÚMMYND HITALAGNA			FASSAR
MELIKV. 1:50			TEKNAEM
SIGURÐUR ÞORLEIFSSON TEKNIFRÉÐSLEIÐI F.M.T.F.I.			VERK NR 8925
STRANDGÖTU 11 HAFNARFJÖRÐI SIMI 5-751			BLAD NR 2-07