



Samþykkt á fundi bygginga-  
nefndar þ. 5. 15. 1988

BYGGINGAFULLTRÚINN  
HAFNARFIRÐI

*[Signature]*

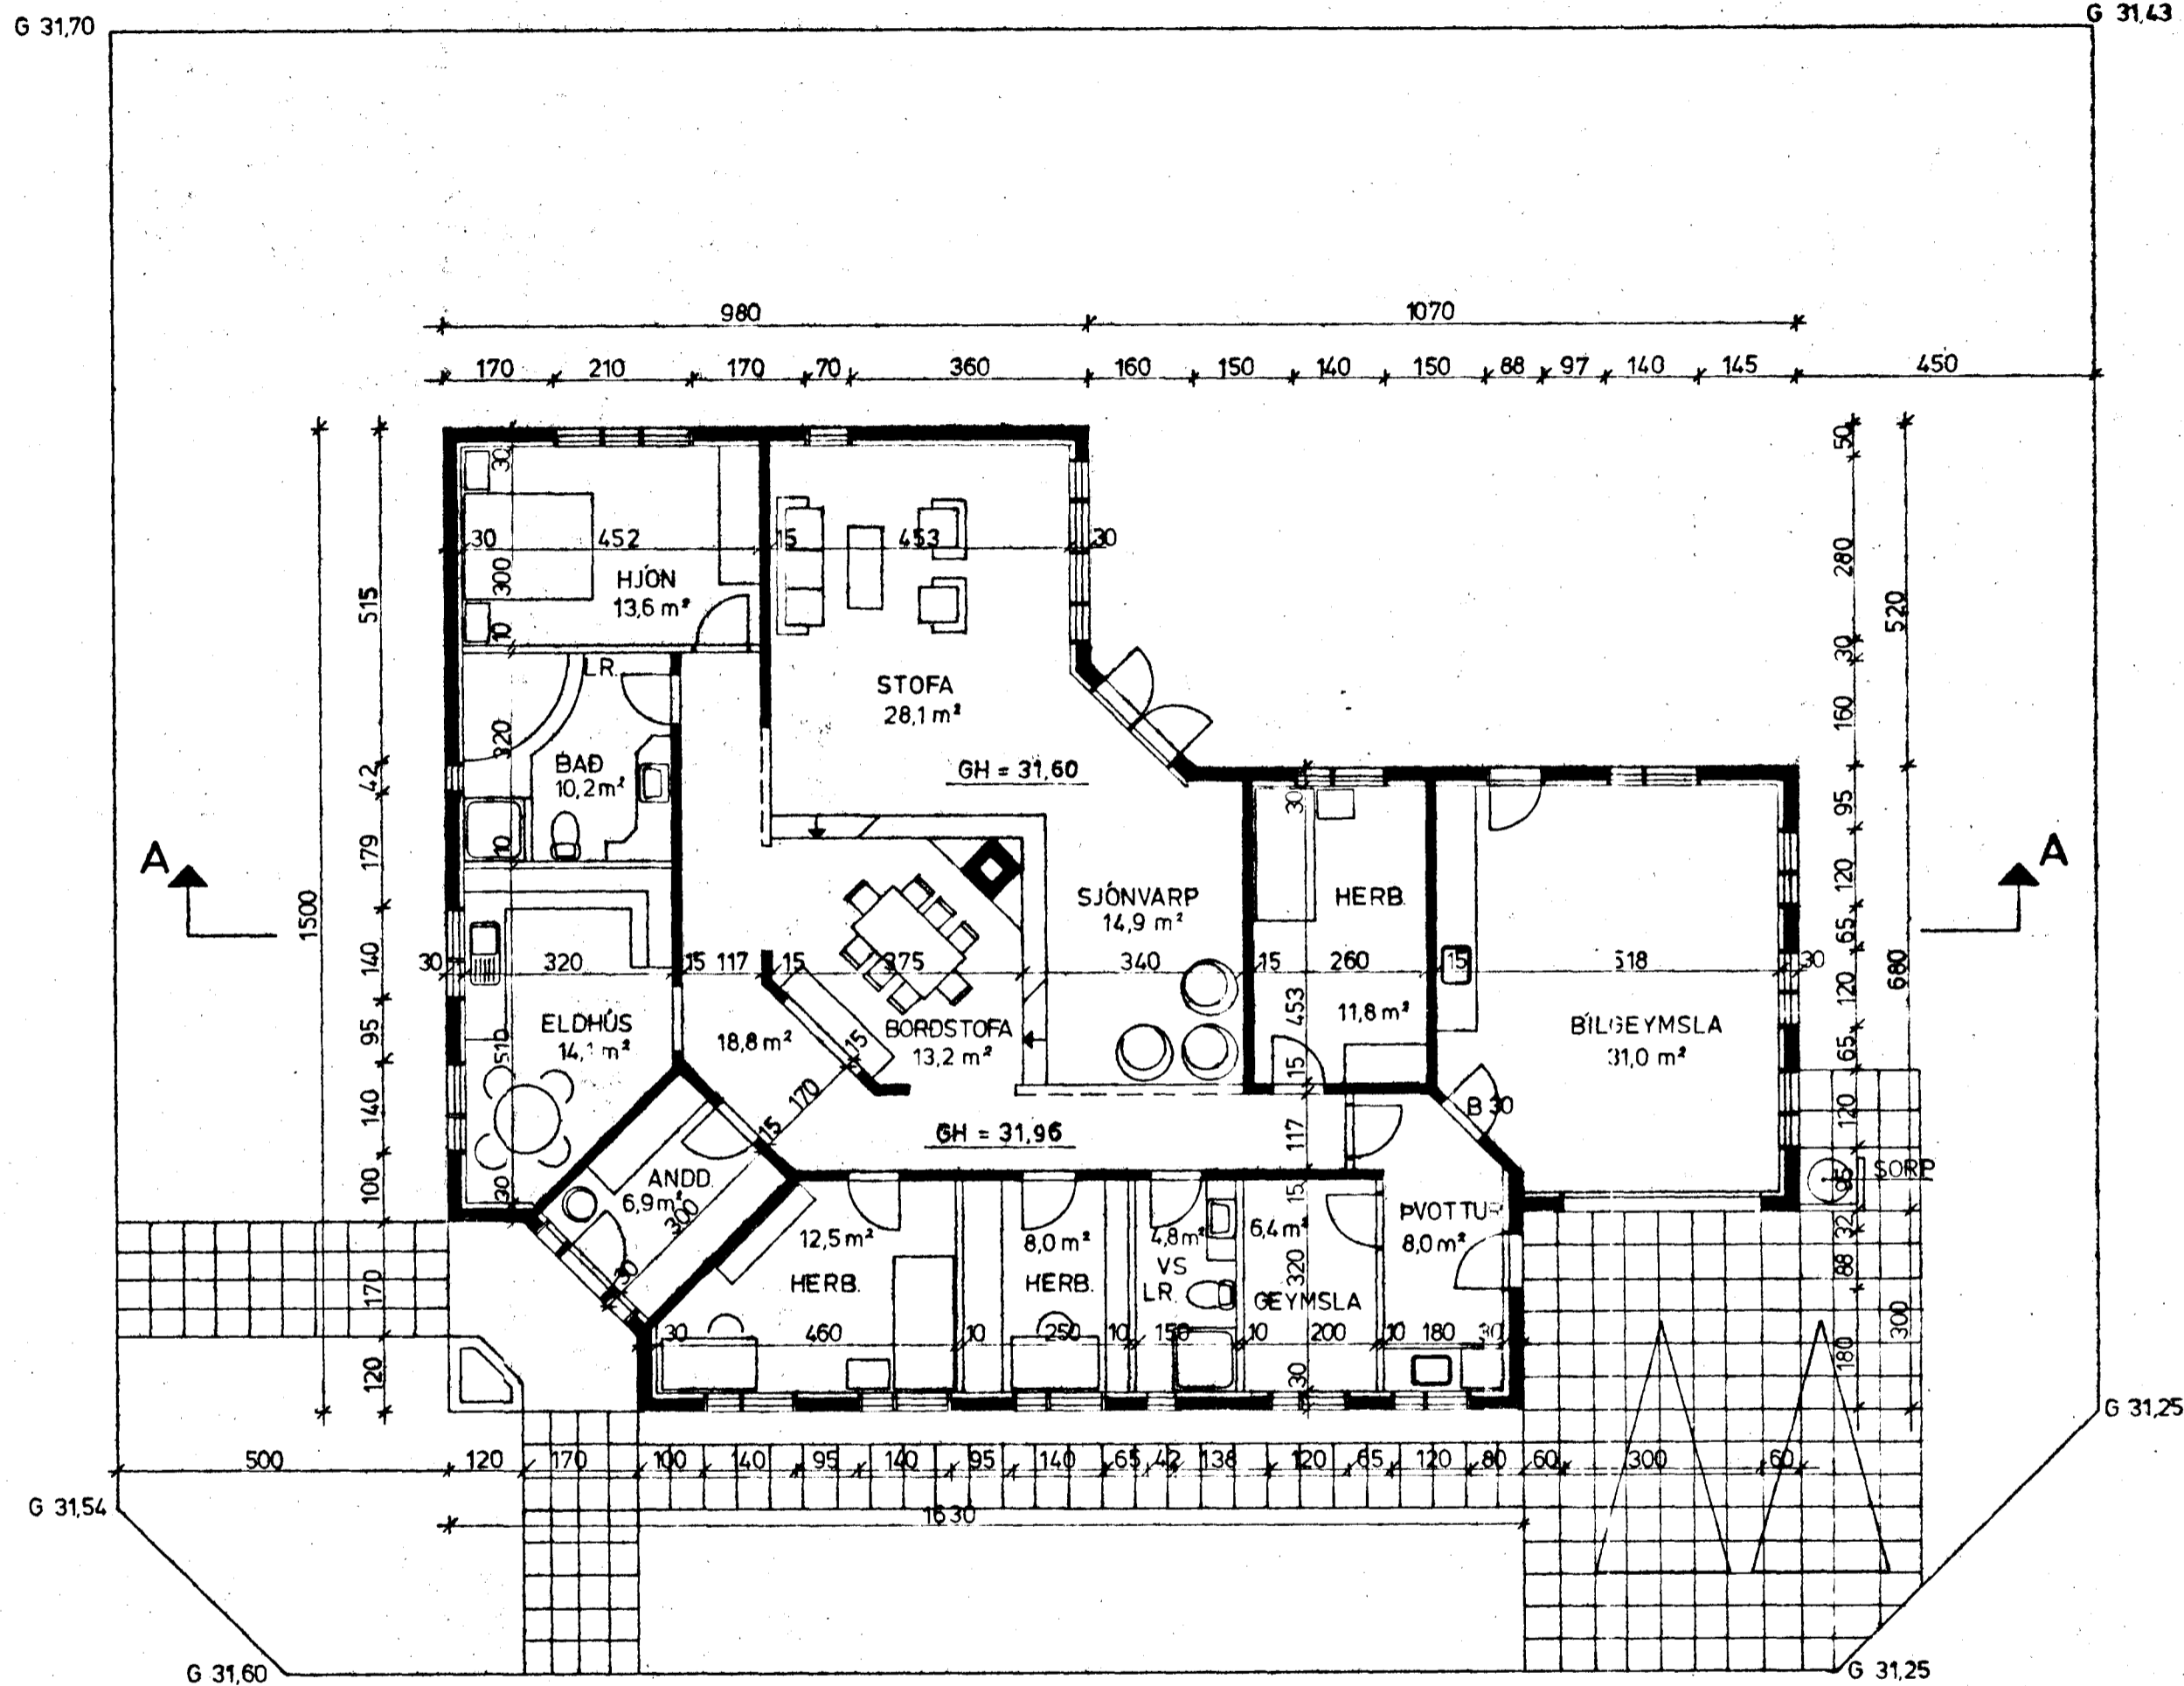

GRUNNMYND 1 : 100

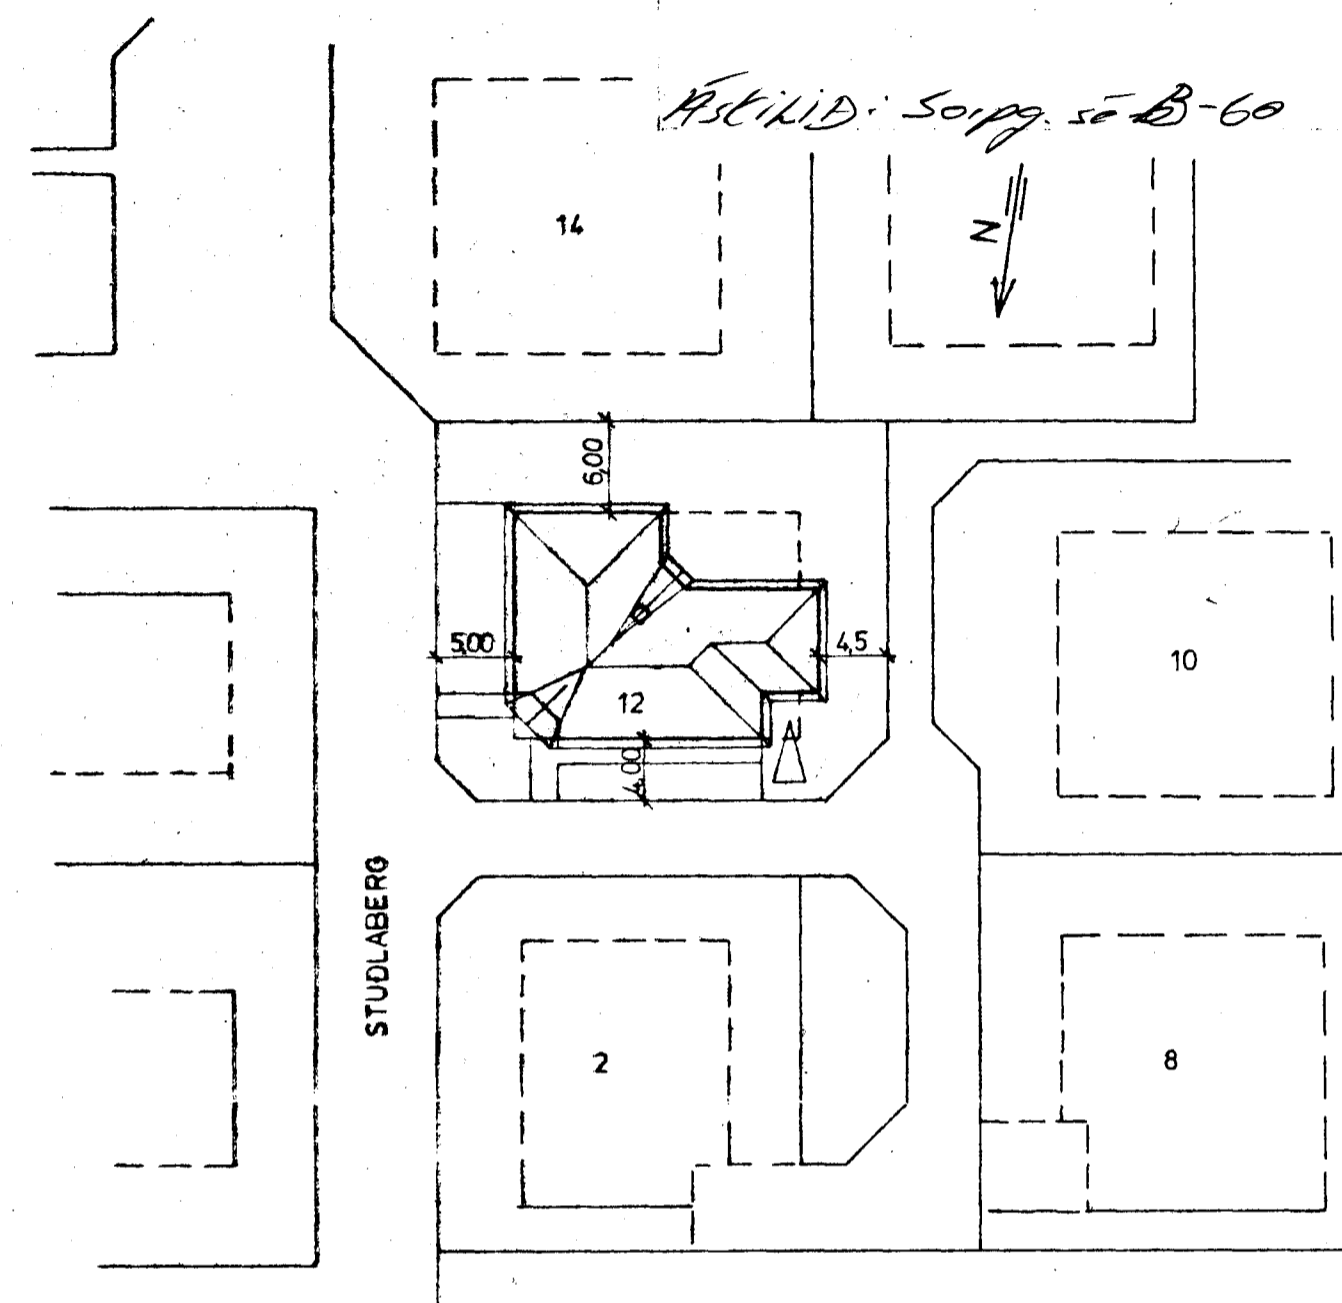

AFSTADA 1 : 500

STÆRD LÖÐAR	738,8 m <sup>2</sup>
BRÚTTÓ FLATARMÁL HÚSS	232,5 m <sup>2</sup> 237,8 m <sup>2</sup>
RÚMMÁL HÚSS	850,2 m <sup>3</sup> 890 m <sup>3</sup>
NÝTINGARPLUTFALL	31,6 %

STUÐLABERG 12	Mælikv. 1 : 100 1 : 500	Verk	Teikn. nr. 1
GRUNNMYND OG AFSTADA	Hannað: <i>[Signature]</i> Teiknað: <i>[Signature]</i>	Yfirfarið: Samb: <i>[Signature]</i>	Dags. APRIL '88
Hermannus Sigvaldason M.V.F.?			