


Δ T 40°

OFN	WÖTT REIKNED AFKÖST	HEÐ LENGD OFNASTRÆÐ	TENGING HEÐ LENGD	WÖTT AFKÖST	HERÐ
1	2.844	70 360	A B		BILGEMSLA
2	640	100 60	A B		GEMSLA
3	3.423	MELT	A B		BORSTOFA
4	1.126	30 170	A B		GANGUR
5	2.96	70 120	A B		GEMSLA
6	1.457	70 120	A B		HERBERGI
7	643	70 120	A B		HERBERGI
8	642	70 120	A B		ÞAÐ
9	643	70 120	A B		HERBERGI
10	1.326	70 180	A B		HERBERGI
11	1.508	MELT	A B		ELDHÚS
12	476	70 100	C D		FÖRSTOFA
13	633	70 100	A B		ÞVOTTIÐ
14	3.930	70 360	A B		GRÆÐSKÁLI
GOLFHTALÖGN	1.670				GRÆÐSKÁLI
SAMTALS	21.137				

————— TÚR LÖGN OFNALAGNAR
 - - - - - RETÚR LÖGN OFNALAGNAR
 ······· HEIT NEYSLUVATA
 - - - - - KALT NEYSLUVATA
 STÆRDIR OFNA OG STÚTASTÆÐSETNING
 ENDURSKOÐAST A STAÐNUM

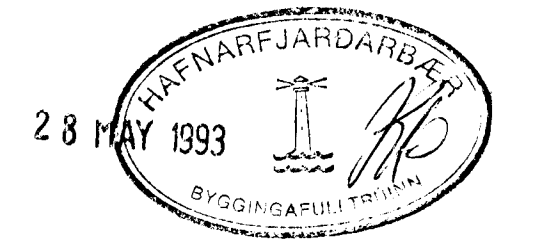

ÁSKILIÐ, ELÐRI
TEIKNING ÓGILD

TEIKNINGU DREYTT Í JANUAR 1993 - Tei
SÍÐ TEIKNINGU L-3.

STUÐLARIÐBERG 14 HAFNARFJÆRÐI	MÁI 1988
OFNALÖGN	MELIKVÆÐI
TEIKNINGUAFSTU SYENS KARLSSONAR TFI HRUNGAUÐ 12 120 HAFNARFJÆRÐI 91-54223	TEIKNING L-2

Handwritten signature: M. Ma.