



Samþykkt á fundi bygginga-
ráðs 29/8 '88
nefndar p. 9/1 19 20 *Gluggab.*

BYGGINGAFULLTRÚINN
Í HAFNARFIRDI

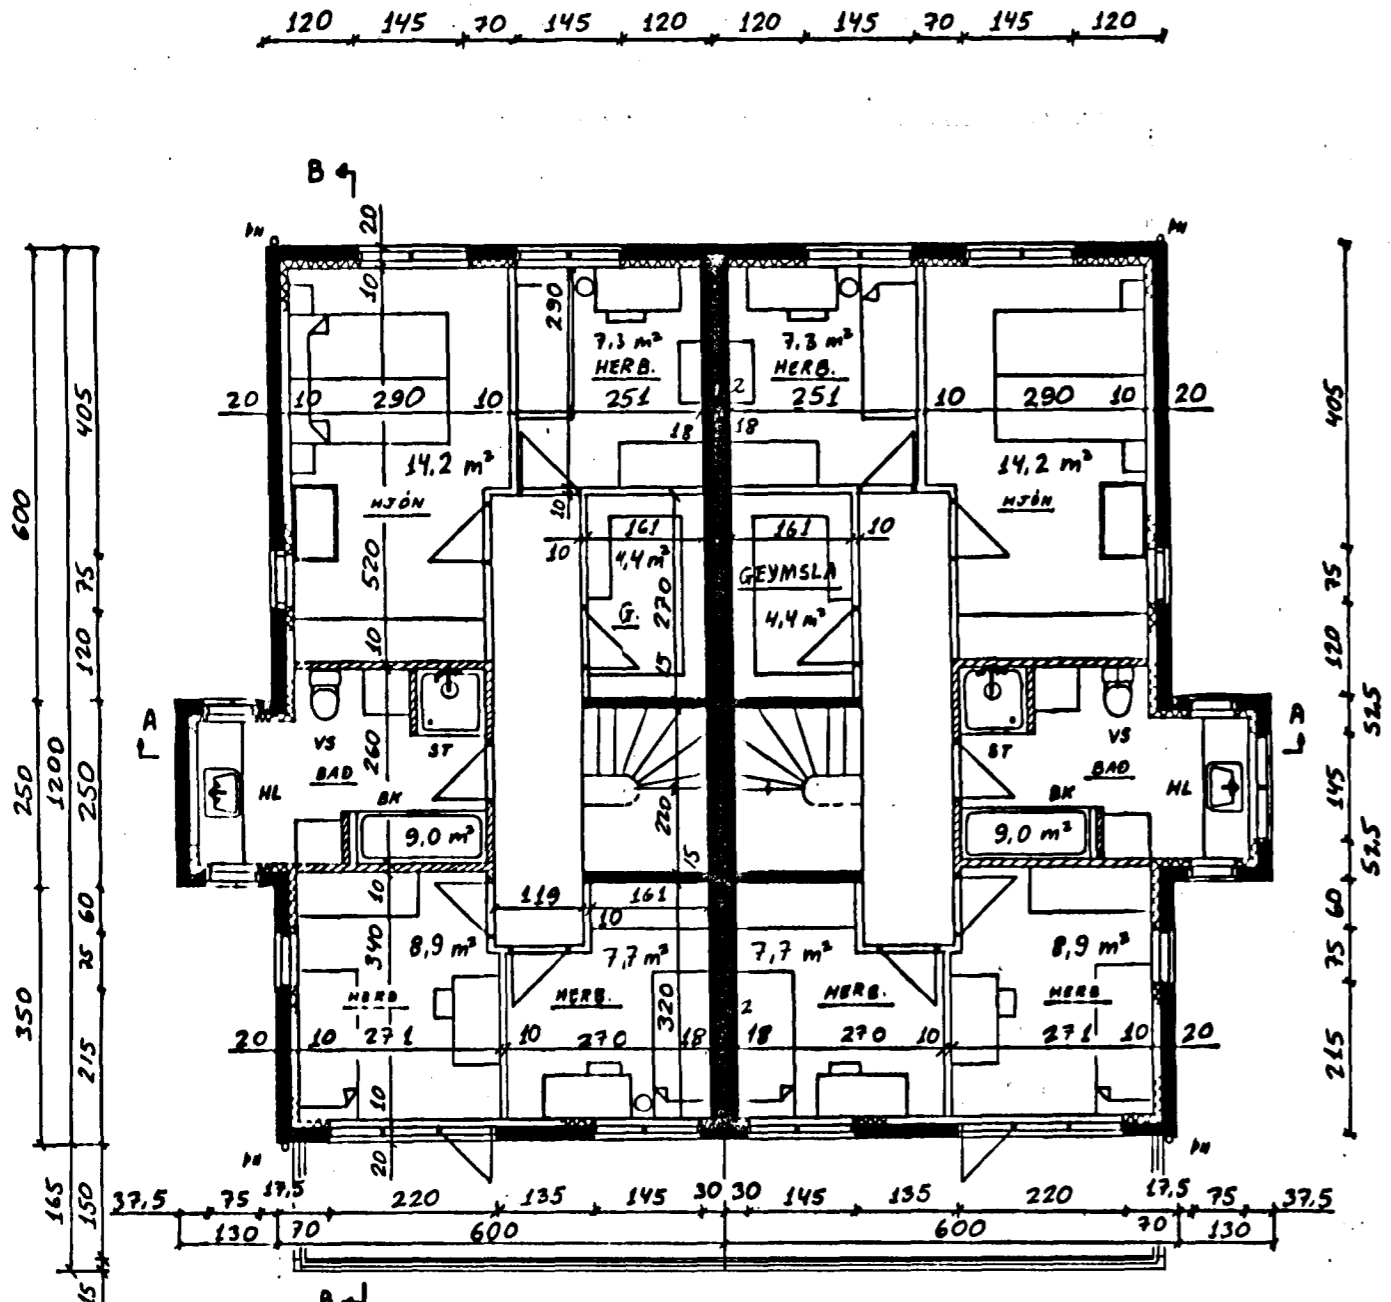


2. HÆÐ. GRUNNMYND. 1:100

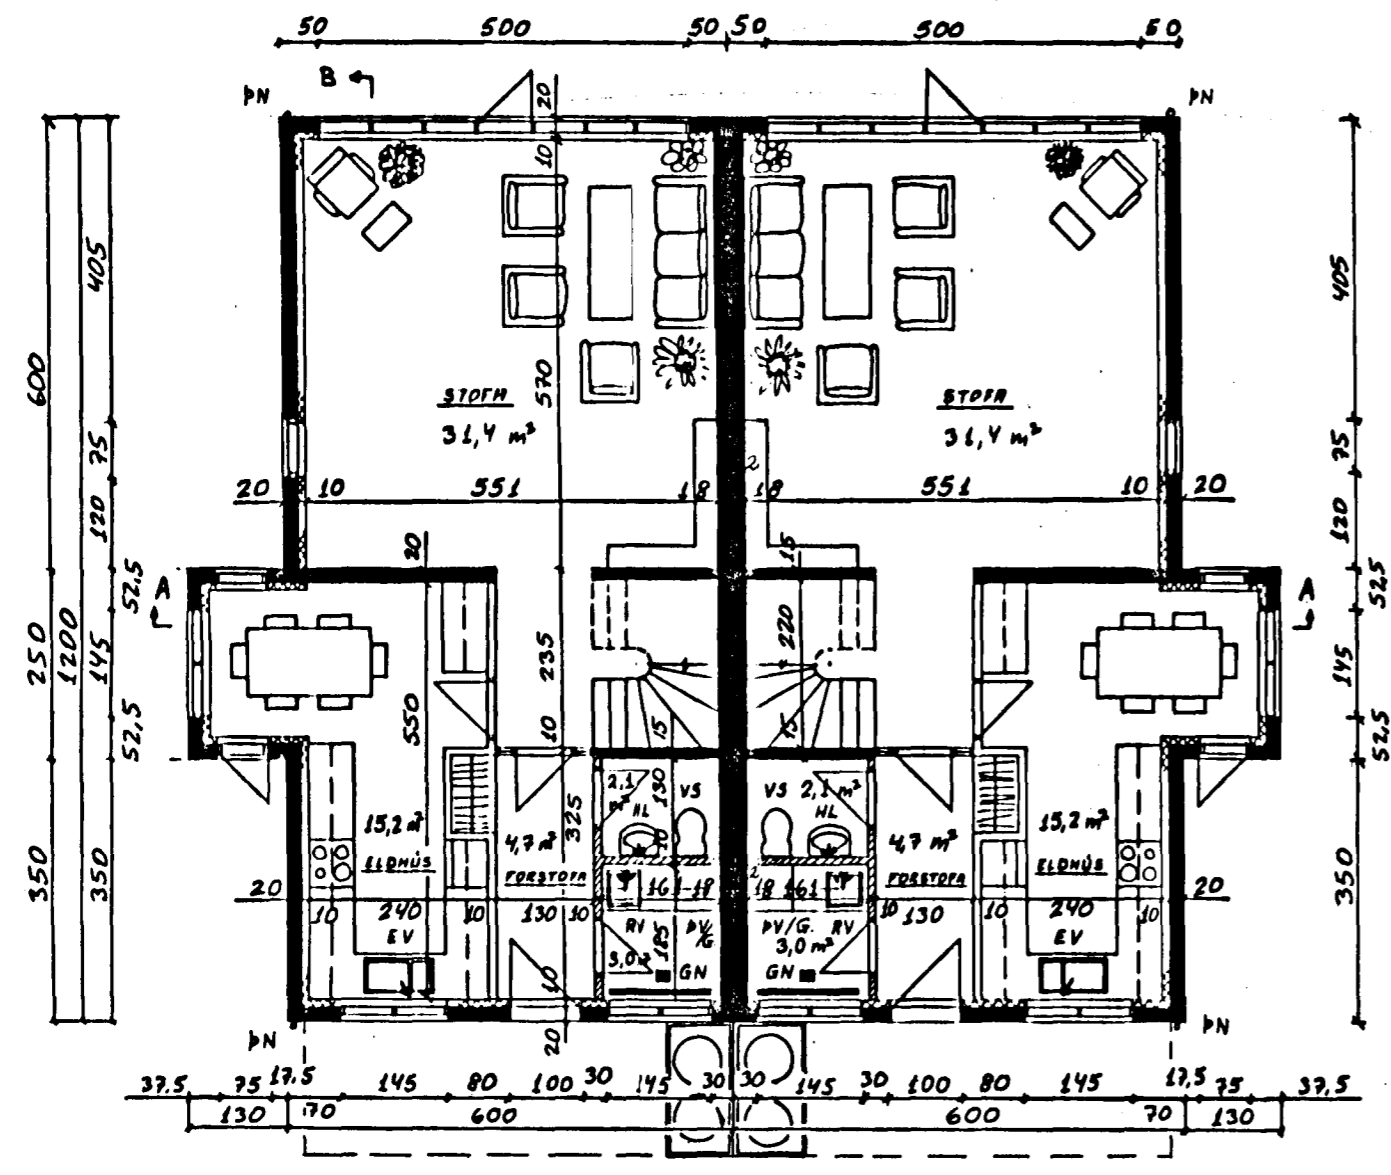

1. HÆÐ. GRUNNMYND. 1:100

AFSTÖÐUMYND. 1:500

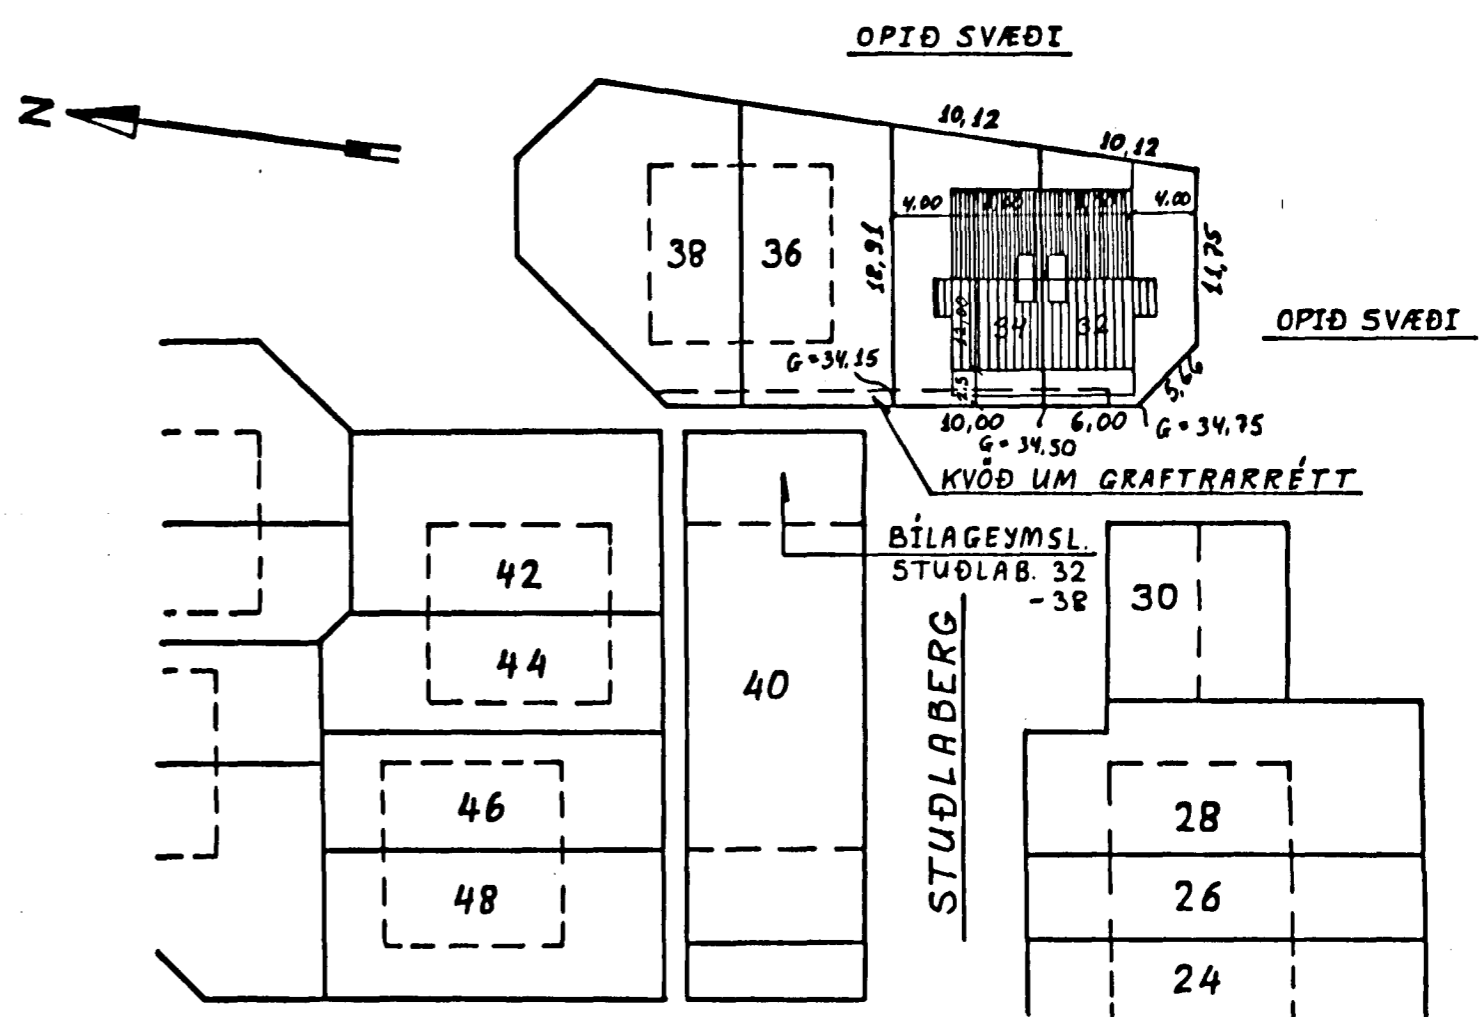

	STUÐLABERG 32	STUÐLABERG 34
1. HÆÐ	75.2 m ² 202.8 m ³	75.2 m ² 202.8 m ³
2. HÆÐ	75.2 m ² 233.9 m ³	75.2 m ² 233.9 m ³
RIS	(64.3) m ² 80.4 m ³	(64.3) m ² 80.4 m ³
HEILDARGÓLFFLATARMÁL:	150.4 m ² —	150.4 m ² —
HEILDARRÚMMÁL:	— 517.1 m ³	— 517.1 m ³
LÓÐARSTÆRÐ:	157.4 m ² —	181.2 m ² —

BREYTT 23/10 '89 - Jón Kristjánsson / STUÐLABERG 34 - GLUGGI BURT Í BADHERB.
 BREYTT 20/9 '88 - Jón Kristjánsson / SVALIR FERÐAR Á FRAMHLID - GLUGGAR Á FRAM-OG
 BREYTT 22/6 '88 - Jón Kristjánsson / ÚTIHURÐ Í ELDHÚS. BAKHLID EFRI HÆÐAR
 BREYTT 24/5 '88 - Jón Kristjánsson / GEYMSLA FERÐ TIL
 BREYTT 23/5 '88 - Jón Kristjánsson / FM HERB. - GEYMSLA BÆTT VID - MÁLSETN.