


RÚMMYND 1:50

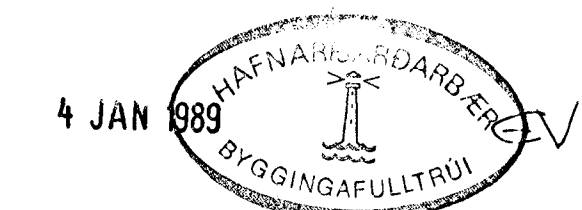

01	13.12.88	MELAGR FERD OFNAR 1 KJALLARA FERD 12L	
DR. NR.	DAGS	EDLI BREVINGAR	SIGN.
SVEJURBRAUT 28 HAFNARFIREÐI			DAGS JULI '88
RÚMMYND HITLAGNA.			HANNAÐ
			TEIKNAD
			VERK NR. 8816
MÆLIKV. 1:50			BLAD NR.
SIGURÐUR ÞORLEIFSSON TEKNIFRÆÐINGUR F.T.F.I.			2-07
STRANDGÖTU 11 HAFNARFIREÐI SÍMI 54751			